



## **Madison Metro Transit System**



1101 East Washington Avenue  
Madison, Wisconsin 53703  
Administrative Office: 608 266 4904  
Fax: 608 267 8778

May 6, 2005

TO: Plan Commission

FROM: Timothy Sobota, Transit Planner, Metro Transit

SUBJECT: **1833 Winnebago Street – Demolition/Rezoning – Kennedy Point Condominiums**

Metro Transit has reviewed the subject development and has the following comments.

**MAJOR OR NON-STANDARD REVIEW COMMENTS** (Comments which are special to the project and/or may require additional work beyond a standard, more routine project.)

1. The applicant shall install a concrete passenger boarding pad on the south side of Winnebago Street, approximately 5 feet west of the corner radius of the private drive. (Approximately ten feet east of location shown on sheet C7 submitted 28 June 2005). The concrete pad shall occupy the full distance of the terrace, measure 10 feet in width parallel to the street, and lie flush between the sidewalk and the top of curb.
2. The developer shall revise the location of this concrete passenger boarding pad on the final documents filed with their permit application so that Metro Transit may review and approve the design.


### **GENERAL OR STANDARD REVIEW COMMENTS**

In addition, we offer the following General or Standard Review Comments:

3. Metro Transit operates bus service seven days a week along Winnebago Street and South First Street. Metro bus stop #1901 is on the south side of the Winnebago Street, approximately 80 feet east of South First Street.
4. Metro Transit requests to sign and review final documents submitted for this project.


Please contact Tim Sobota, Metro Transit at 261-4289  
or by email at <tsobota@cityodmadison.com>  
if you have questions regarding the above items.

CC: Project contact person, Joe Krupp: <jkrupp@kruppconstruction.com> (email)

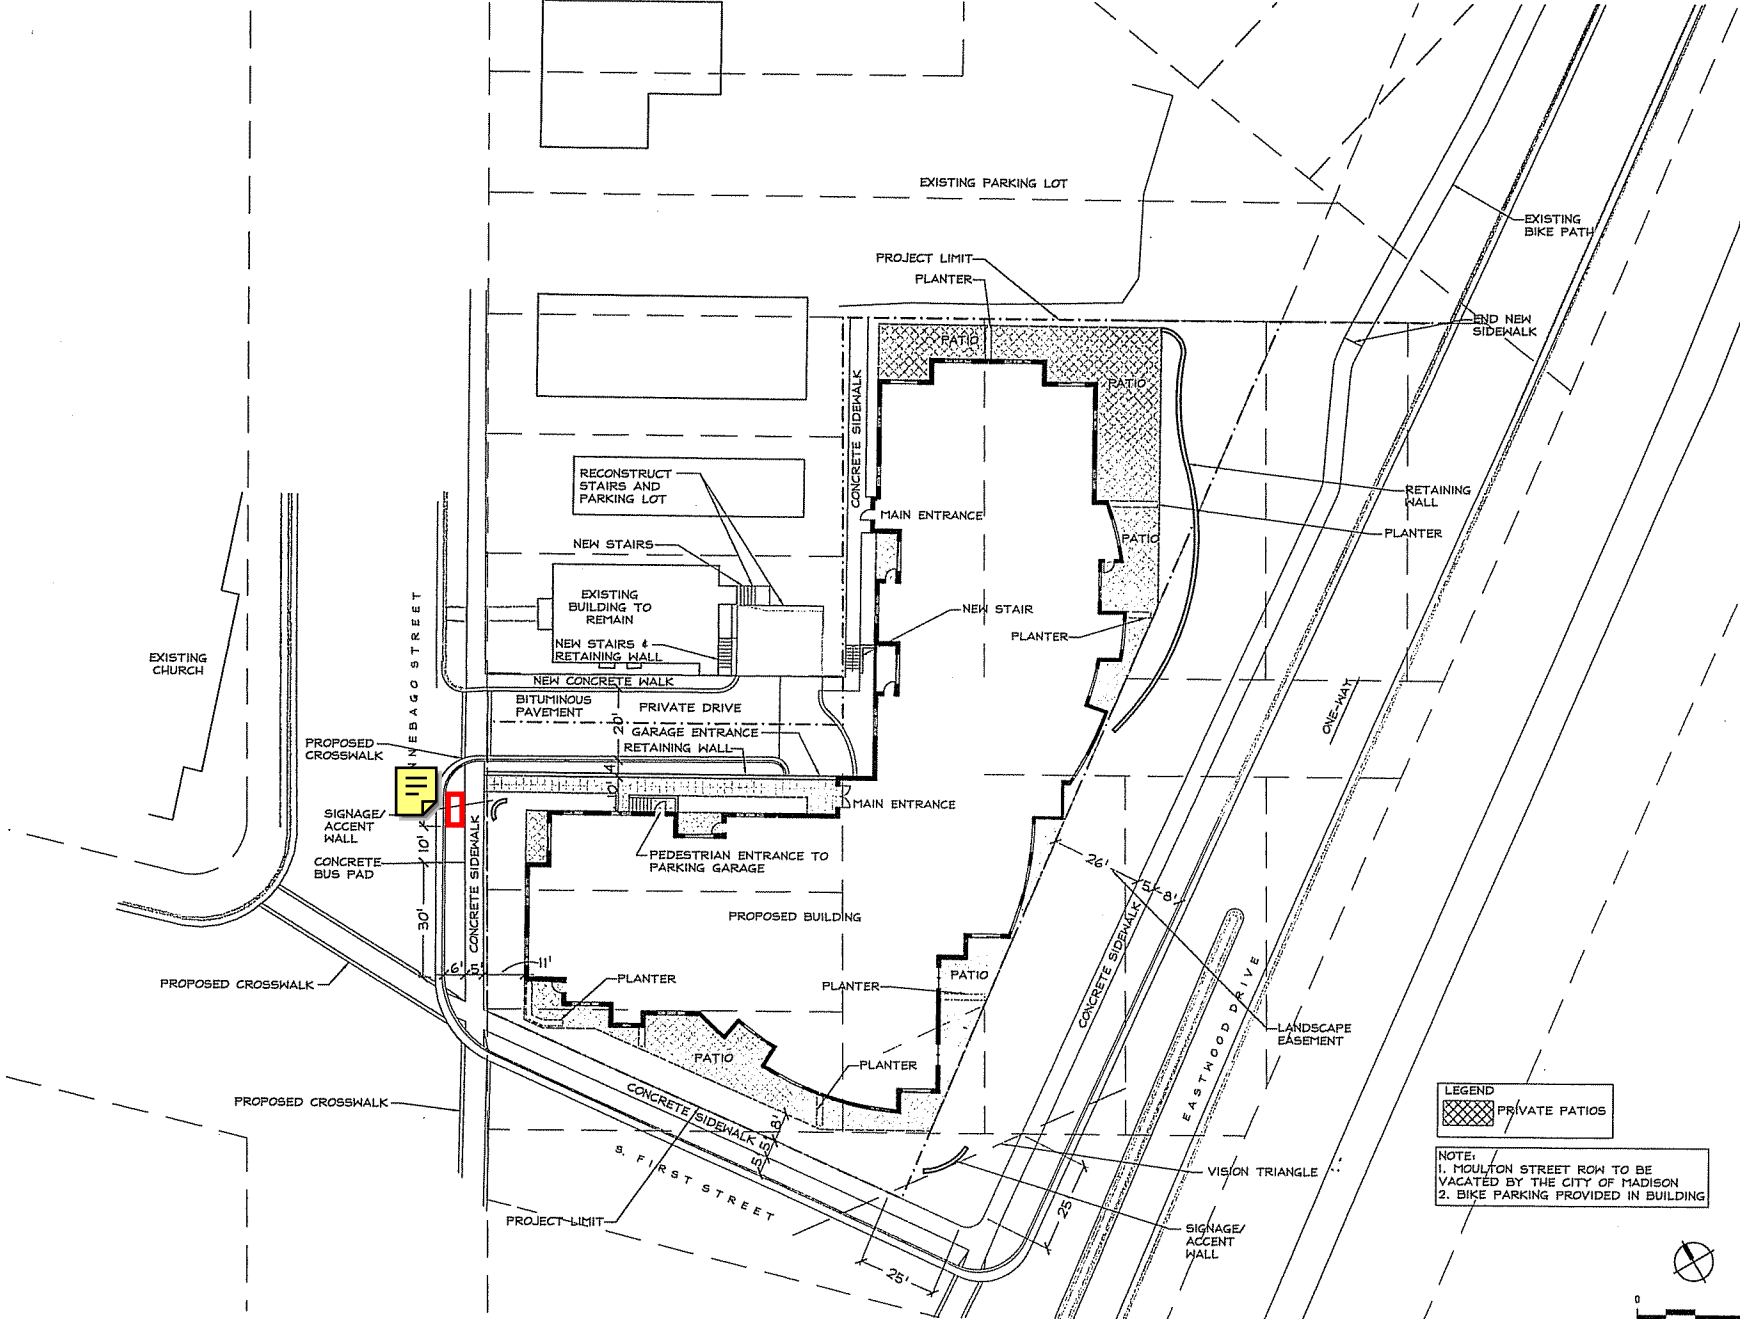

**LEGEND**  
 PRIVATE PATIOS

**NOTE:**  
 1. MCULTON STREET ROW TO BE VACATED BY THE CITY OF MADISON  
 2. BIKE PARKING PROVIDED IN BUILDING

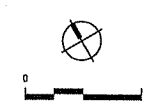

717 John Nolen Drive, Madison, WI 53713  
 Ph: 608-255-0800 Fax: 608-255-7750

Revisions:  
 Date: \_\_\_\_\_ Description: \_\_\_\_\_  
 \_\_\_\_\_  
 \_\_\_\_\_  
Schreiber/Anderson Associates, Inc.  
 GDP-SIP SUBMITTAL  
**Kennedy Point Condominiums**  
 Madison, Wisconsin  
 A Residential Development by Knapp Construction Madison, Wisconsin

Sheet Title:  
 Site Plan

Date:  
 28 June 2005

Sheet Number:  
**C7**