



Consultant: _____
 Home: _____

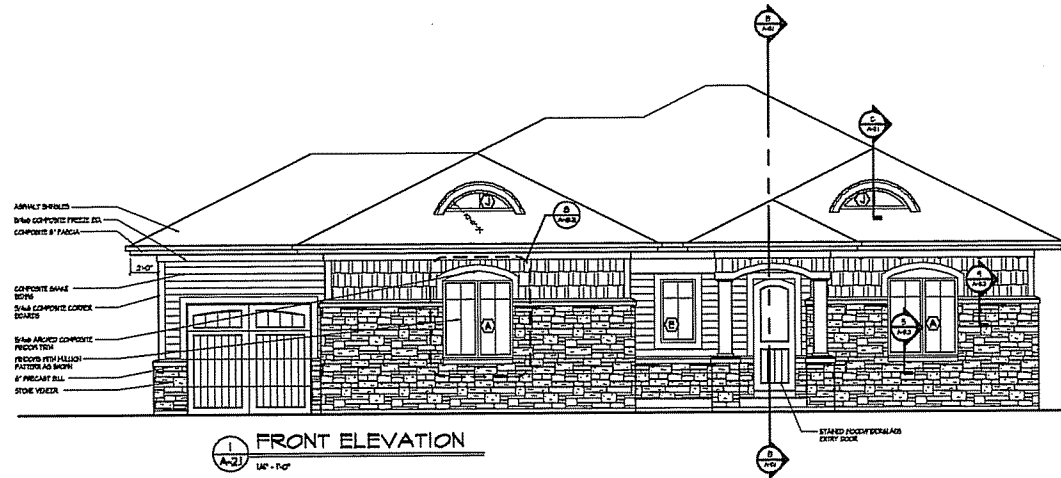

1 FRONT ELEVATION
 UC - 1st

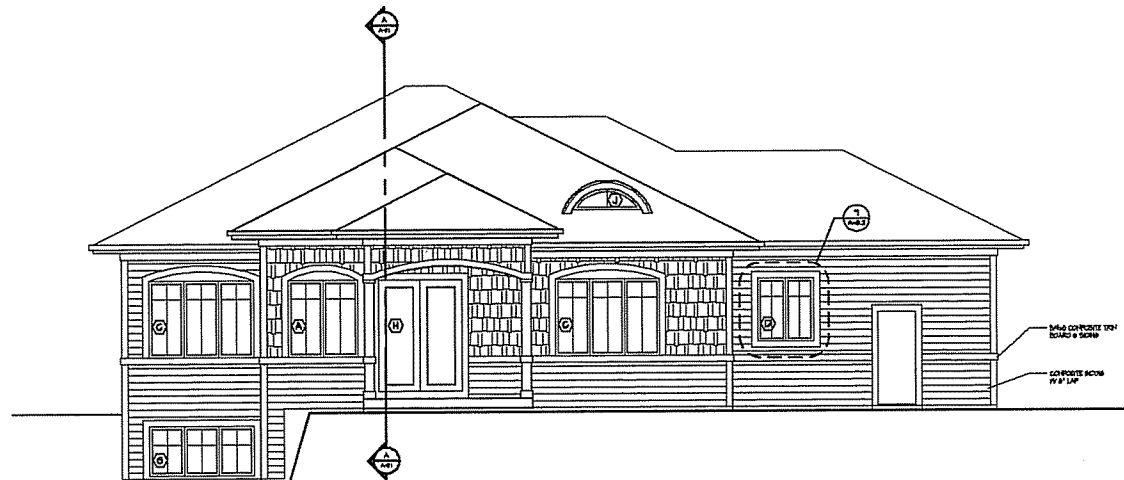

2 REAR ELEVATION
 UC - 1st

Revision:
 Issued For Bidding - October 26, 2011


Project Title:
Hawks Reserve
 Lot: 53

Single Family Unit:
 4002 Royal Oaks Circle


Drawing Title:
Building Elevations
 Single Family

Project No.: 0922 Drawing No.: A-2.1

These drawings are the property of KNOTHE & BRUCE ARCHITECTS. No part of these drawings may be reproduced, stored in a retrieval system, or transmitted in any form or by any means, electronic, mechanical, photocopying, recording, or by any information storage and retrieval system, without the prior written permission of KNOTHE & BRUCE ARCHITECTS.

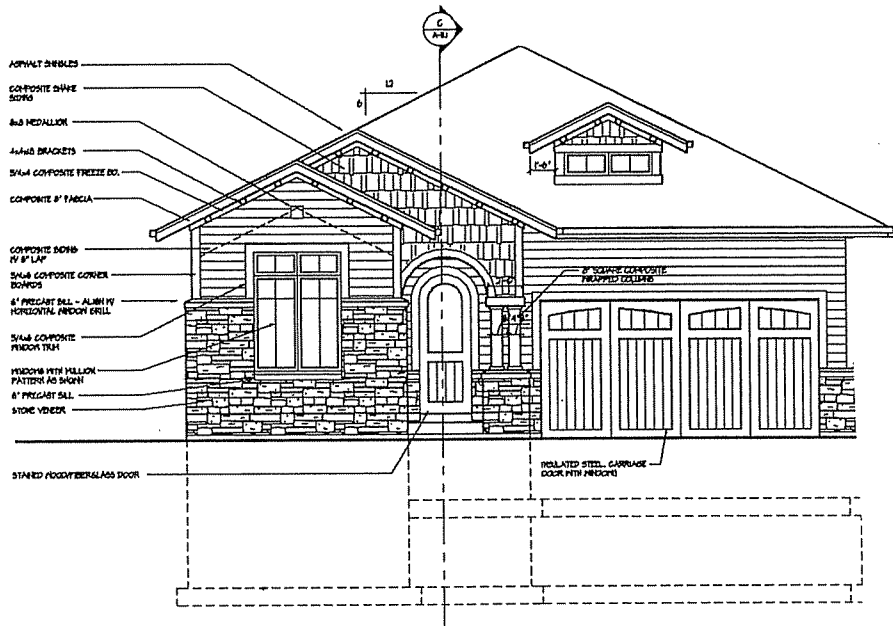

FRONT ELEVATION
 1/4" = 1'-0"

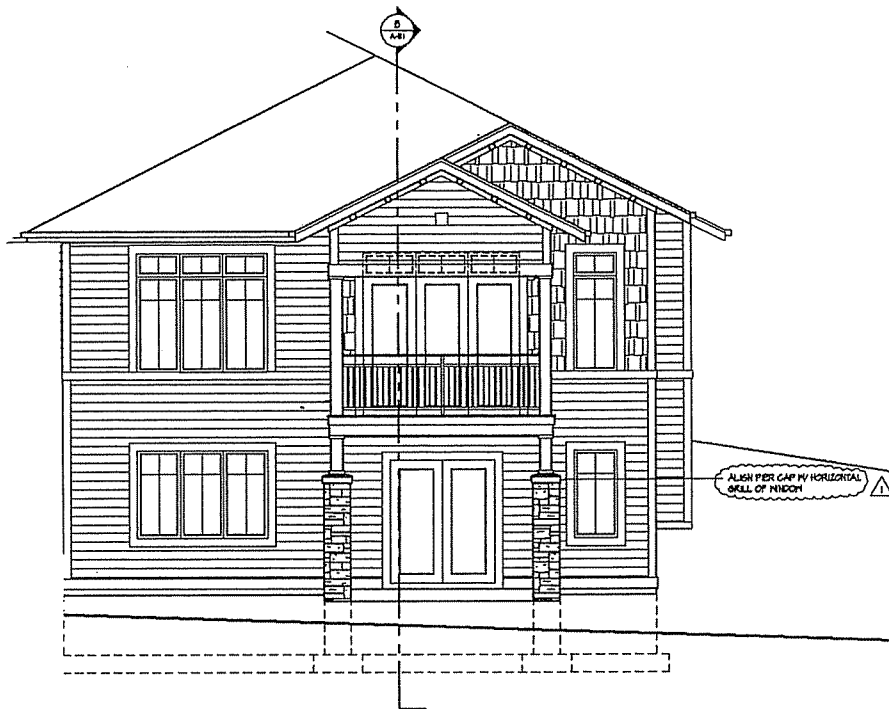

Revisions
 Preliminary Pricing 7,200
 Issued For Construction - June 24, 2010
 Issued For Plan Review - October 24, 2010

△ Roland Mauney Vanceer Height - November 2, 2010
 Project Title
Hanks Reserve
 Lot 53

9005 & 9007
 Royal Oaks Circle
 Drawing Title
Elevations

Project No. Drawing No.
0922 A-2.1

This document is the property of the architect and is not to be reproduced, distributed, used, or modified in any way without the written consent of the architect. The architect shall not be held responsible for any errors or omissions in this document.

