

LABEL RIM STO DB -1 STO DB B STO DB B-2 STO DB C STO DB D-2 STO DB D-3 STO DB D-4

LABEL F STO A-1 STC STO A-2 STO STO B-1 STO STO B-2 STO I STO B-2.1 STO STO B-3 STO STO B-4 STO STO C-1 STO STO C-2 STO STO D-1 STO STO D-1.1 STO STO D-2 STO I STO D-2.1 STO STO D-3 STO I STO D-3.1 STO STO D-4 STO I STO D-5 STO STO E-1 STO

Engberg Anderson
ARCHITECTS

MILWAUKEE | MADISON | CHICAGO



WARNER PARK COMMUNITY **RECREATION CENTER** EXPANSION

1625 NORTHPORT DRIVE MADISON, WI 53704

CITY OF MADISON PARKS DIVISION CITY-COUNTY BUILDING, ROOM 104 210 MARTIN LUTHER KING JR. BLVD MADISON, WI 53703

PROJECT NUMBER

223471.00

ISSUED FOR:	
BID SET	05/16/2024
REVISION FOR:	
NO. DESCRIPTION	DATE
1 ADDENDUM 2	6/14/2024
2 ADDENDUM 3	6/18/2024

DRAWN BY	CHG/MRA
CHECKED BY	KJY

C500


UTILITY PLAN

PRC	PROPOSED STORM SEWER STRUCTURE TABLE			
/ EL. (FT)	INVERT EL. (FT)	DEPTH (FT)	STRUCTURE DESC.	FRAME & GRATE
868.95	N INV: 866.52 (10") S INV: 866.52 (8") E INV: 866.52 (8")	2.4	24 IN DB	ADS DRAIN WITH BEEHIVE GRATE
861.24	E INV: 858.20 (6")	3.0	24 IN DB	ADS DRAIN WITH BEEHIVE GRATE
861.31	W INV: 858.68 (6") E INV: 858.68 (6") N INV: 858.68 (6")	2.6	24 IN DB	ADS DRAIN WITH BEEHIVE GRATE
861.99	E INV: 859.13 (6") W INV: 859.13 (6")	2.9	24 IN DB	ADS DRAIN WITH BEEHIVE GRATE
869.23	W INV: 866.76 (8") E INV: 866.76 (8") S INV: 866.76 (8")	2.5	24 IN DB	ADS DRAIN WITH BEEHIVE GRATE
872.22	W INV: 867.42 (8") SE INV: 867.42 (8") S INV: 867.42 (8")	4.8	24 IN DB	ADS DRAIN WITH BEEHIVE GRATE
874.44	NW INV: 868.13 (8") S INV: 868.13 (8")	6.3	12 IN DB	ADS DRAIN WITH BEEHIVE GRATE
861.44	N INV: 858.70 (6")	2.7	24 IN DB	ADS DRAIN WITH BEEHIVE GRATE

PROPOSED STORM SEWER PIPE TABLE

ТО	LENGTH	INVERT EL. (FT)	DISCHARGE EL. (FT)	SLOPE	SIZE & MATERIAL
STO A	168'	864.00	862.00	1.19%	6 IN HDPE
STO A-1	56'	864.00	864.00	0.00%	6 IN HDPE
STO DB B	19'	858.39	858.20	1.00%	6 IN HDPE
STO B-1	29'	858.68	858.39	1.00%	6 IN HDPE
STO DB B-2	14'	858.82	858.68	1.00%	6 IN HDPE
STO DB B-2	49'	859.17	858.68	1.00%	6 IN HDPE
STO B-3	16'	859.40	859.17	1.50%	6 IN HDPE
STO DB C	17'	859.30	859.13	1.00%	6 IN HDPE
STO DB C	3'	859.16	859.13	1.00%	6 IN HDPE
STO D	70'	866.52	866.00	0.75%	10 IN HDPE
STO DB -1	6'	866.57	866.52	0.75%	8 IN HDPE
STO DB -1	32'	866.76	866.52	0.75%	8 IN HDPE
STO DB D-2	6'	866.81	866.76	0.75%	8 IN HDPE
STO DB D-2	44'	867.42	866.76	1.50%	8 IN HDPE
STO DB D-3	23'	867.76	867.42	1.50%	8 IN HDPE
STO DB D-3	47	868.15	867.42	1.50%	8 IN HDPE
STO DB D-4	6'	868.22	868.13	1.50%	8 IN HDPE
STO DB E	13'	858.95	858.70	2.00%	6 IN HDPE
	STO A STO DB B STO DB B-1 STO DB B-2 STO DB B-2 STO DB C STO DB D-2 STO DB D-3 STO DB D-3 STO DB D-3 STO DB D-4	STO A 168' STO A-1 56' STO DB B 19' STO DB B-1 29' STO DB B-2 14' STO DB B-2 49' STO DB B-2 49' STO DB C 17' STO DB C 3' STO DB C 6' STO DB D-1 6' STO DB D-2 44' STO DB D-3 23' STO DB D-3 47 STO DB D-4 6'	STO A 168' 864.00 STO A-1 56' 864.00 STO DB B 19' 858.39 STO B-1 29' 858.68 STO DB B-2 14' 858.82 STO DB B-2 49' 859.17 STO B-3 16' 859.40 STO DB C 17' 859.30 STO DB C 17' 859.30 STO DB C 3' 859.16 STO DB C 3' 859.16 STO DB C 3' 859.16 STO DB C 3' 866.52 STO DB -1 6' 866.57 STO DB -1 32' 866.76 STO DB D-2 6' 866.81 STO DB D-2 6' 866.81 STO DB D-3 23' 867.76 STO DB D-3 47 868.15 STO DB D-4 6' 868.22	STO A168'864.00862.00STO A-156'864.00864.00STO DB B19'858.39858.20STO B-129'858.68858.39STO DB B-214'858.82858.68STO DB B-249'859.17858.68STO DB B-249'859.40859.17STO DB C17'859.30859.13STO DB C3'859.16859.13STO DB C3'866.52866.00STO DB -16'866.57866.52STO DB -16'866.76866.52STO DB D-26'866.76866.76STO DB D-244'867.42866.76STO DB D-323'867.76867.42STO DB D-46'868.13867.42STO DB D-46'868.13867.42	STO A168'864.00862.001.19%STO A-156'864.00864.000.00%STO DB B19'858.39858.201.00%STO B-129'858.68858.391.00%STO DB B-214'858.82858.681.00%STO DB B-249'859.17858.681.00%STO DB B-249'859.17858.681.00%STO DB B-249'859.171.50%STO DB C17'859.30859.131.00%STO DB C3'859.16859.131.00%STO DB C3'859.16859.131.00%STO DB C3'866.52866.000.75%STO DB -16'866.57866.520.75%STO DB -132'866.76866.760.75%STO DB D-26'866.81866.761.50%STO DB D-323'867.76867.421.50%STO DB D-347868.13867.421.50%STO DB D-46'868.22868.131.50%

north

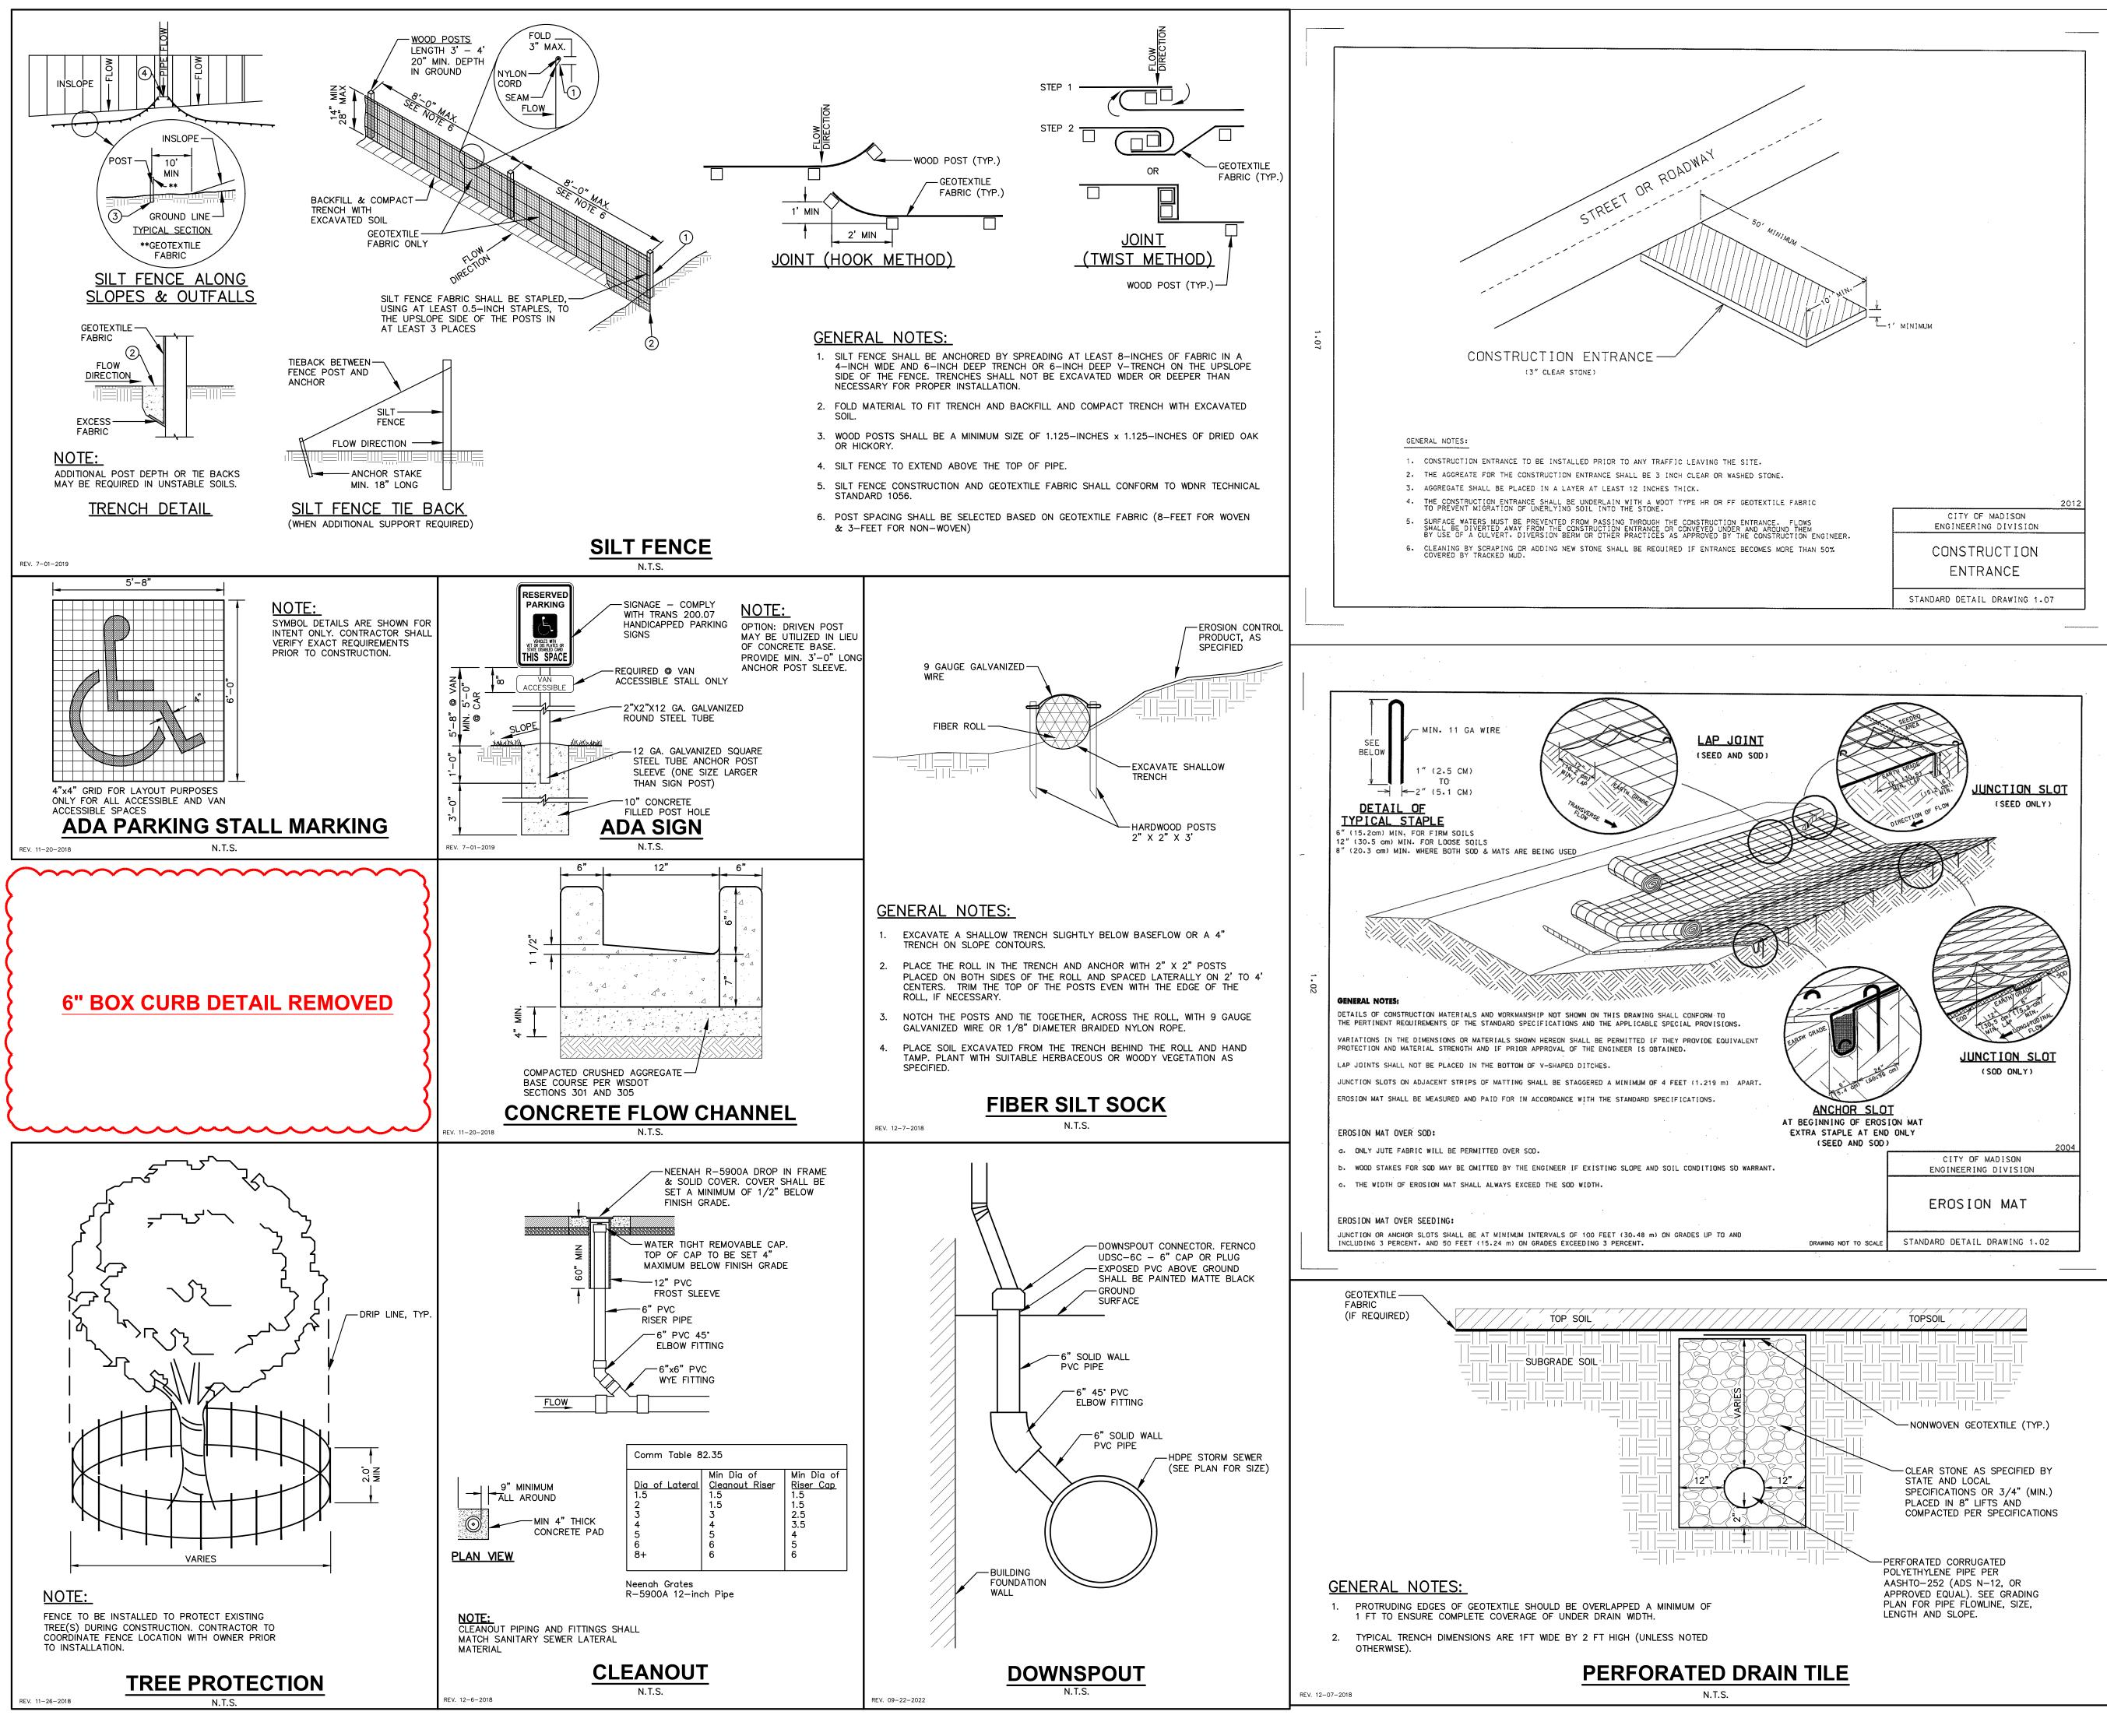



MADISON REGIONAL OFFICE 161 HORIZON DRIVE, SUITE 101 VERONA, WISCONSIN 53593 P. 608.848.5060


WARNER PARK COMMUNITY **RECREATION CENTER EXPANSION**

1625 NORTHPORT DRIVE MADISON, WI 53704

CITY OF MADISON PARKS DIVISION CITY-COUNTY BUILDING, ROOM 104 210 MARTIN LUTHER KING JR. BLVD MADISON, WI 53703

PROJECT NUMBER


223471.00

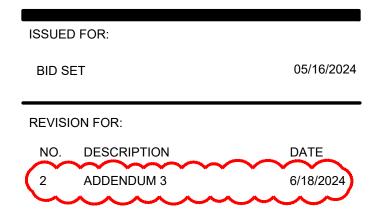

DRAWN BY	CHG/MRA
CHECKED BY	KJY


DETAILS

C600

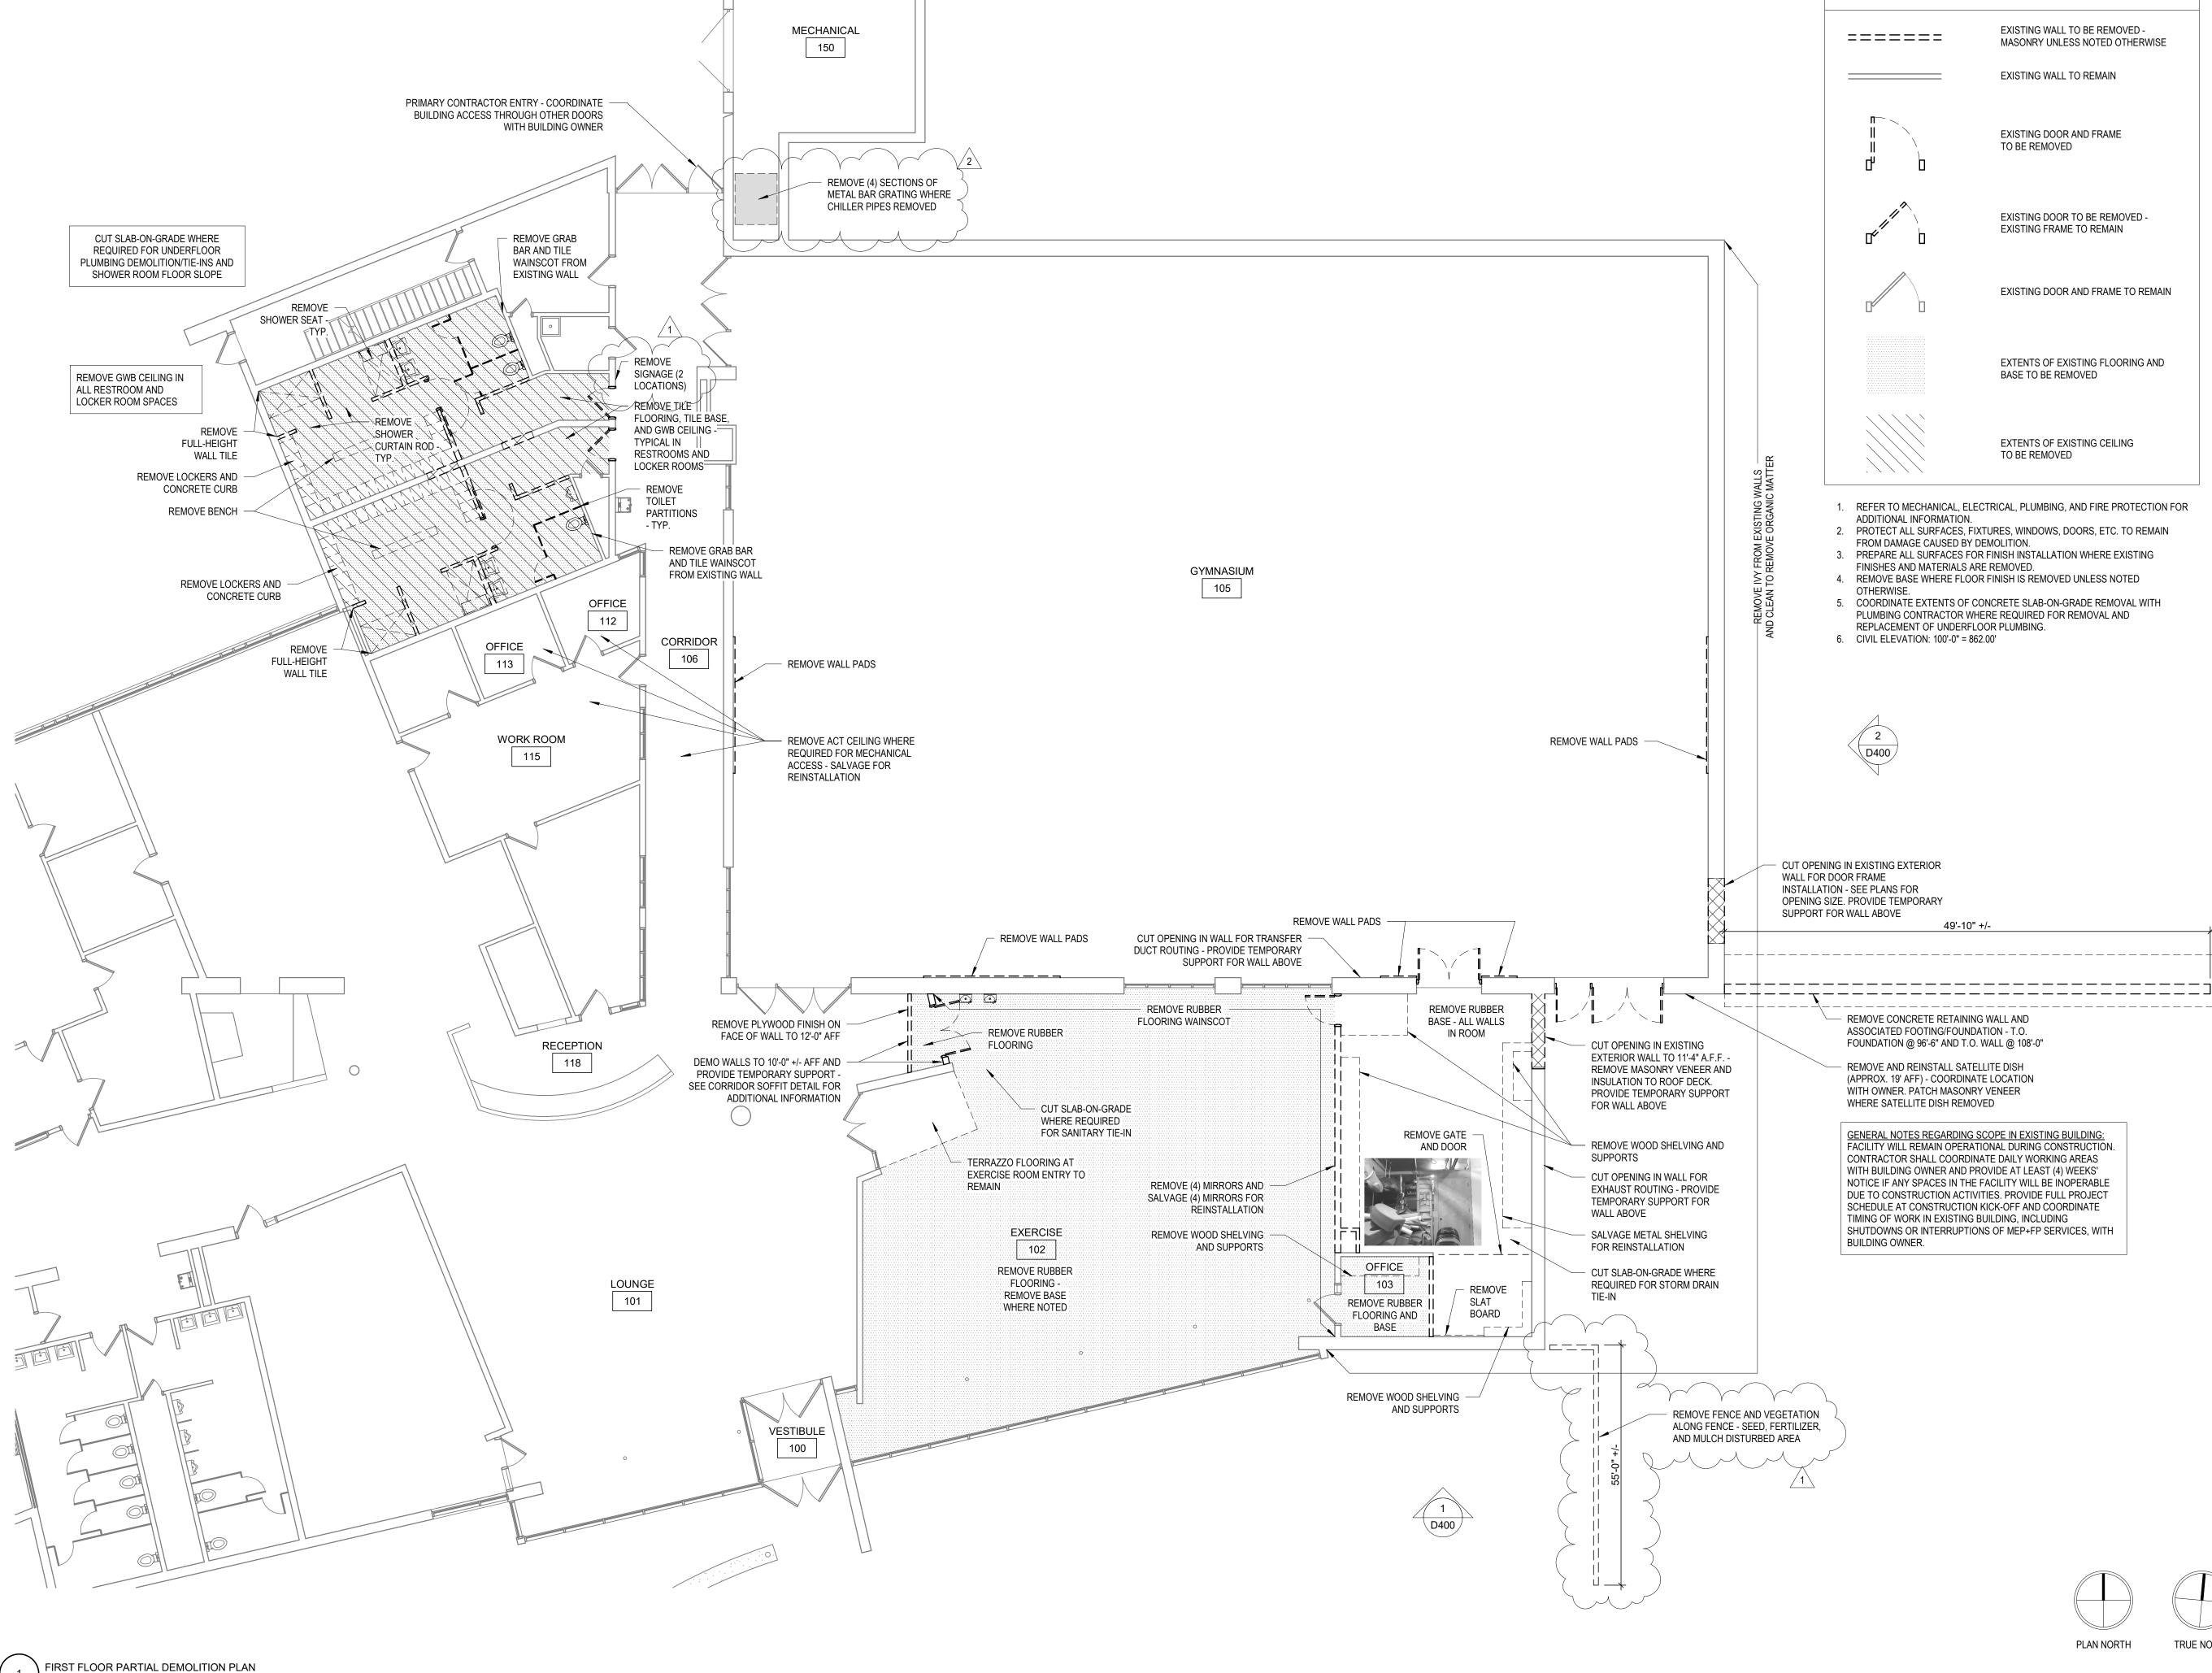


SCALE: 1/8" = 1'-0"

GENERAL NOTES - DEMOLITION

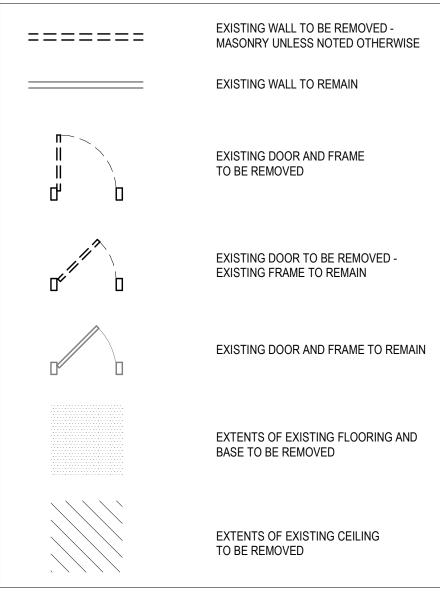

- 1. REFER TO MECHANICAL, ELECTRICAL, PLUMBING, AND FIRE PROTECTION FOR ADDITIONAL INFORMATION.
- 2. PROTECT ALL SURFACES, FIXTURES, WINDOWS, DOORS, ETC. TO REMAIN FROM DAMAGE CAUSED BY DEMOLITION.
- 3. PREPARE ALL SURFACES FOR FINISH INSTALLATION WHERE EXISTING
- FINISHES AND MATERIALS ARE REMOVED. 4. REMOVE BASE WHERE FLOOR FINISH IS REMOVED UNLESS NOTED
- OTHERWISE.
- 5. COORDINATE EXTENTS OF CONCRETE SLAB-ON-GRADE REMOVAL WITH PLUMBING CONTRACTOR WHERE REQUIRED FOR REMOVAL AND REPLACEMENT OF UNDERFLOOR PLUMBING.
- 6. CIVIL ELEVATION: 100'-0" = 862.00'

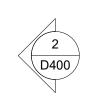

- CUT OPENING IN EXISTING EXTERIOR WALL FOR DOOR FRAME INSTALLATION - SEE PLANS FOR OPENING SIZE. PROVIDE TEMPORARY SUPPORT FOR WALL ABOVE

49'-10" +/-

_____ — REMOVE CONCRETE RETAINING WALL AND ASSOCIATED FOOTING/FOUNDATION - T.O. FOUNDATION @ 96'-6" AND T.O. WALL @ 108'-0"

REMOVE AND REINSTALL SATELLITE DISH (APPROX. 19' AFF) - COORDINATE LOCATION WITH OWNER. PATCH MASONRY VENEER WHERE SATELLITE DISH REMOVED

GENERAL NOTES REGARDING SCOPE IN EXISTING BUILDING: FACILITY WILL REMAIN OPERATIONAL DURING CONSTRUCTION. CONTRACTOR SHALL COORDINATE DAILY WORKING AREAS WITH BUILDING OWNER AND PROVIDE AT LEAST (4) WEEKS' NOTICE IF ANY SPACES IN THE FACILITY WILL BE INOPERABLE DUE TO CONSTRUCTION ACTIVITIES. PROVIDE FULL PROJECT SCHEDULE AT CONSTRUCTION KICK-OFF AND COORDINATE TIMING OF WORK IN EXISTING BUILDING, INCLUDING SHUTDOWNS OR INTERRUPTIONS OF MEP+FP SERVICES, WITH BUILDING OWNER.



MILWAUKEE | MADISON | CHICAGO

WARNER PARK COMMUNITY RECREATION CENTER EXPANSION

1625 NORTHPORT DRIVE MADISON, WI 53704 CITY OF MADISON PARKS DIVISION 330 EAST LAKESIDE STREET MADISON, WI 53715

PROJECT NUMBER

223471.00

ISSUE) FOR:	
BID SI	ET	5/16/2024
REVISI	ON FOR:	
NO.	DESCRIPTION	DATE
1 2	ADDENDUM #2 ADDENDUM #3	6/14/2024 6/18/2024


DRAWN BY	DKB
CHECKED BY	JMH
	01111


DEMOLITION PLAN





D101

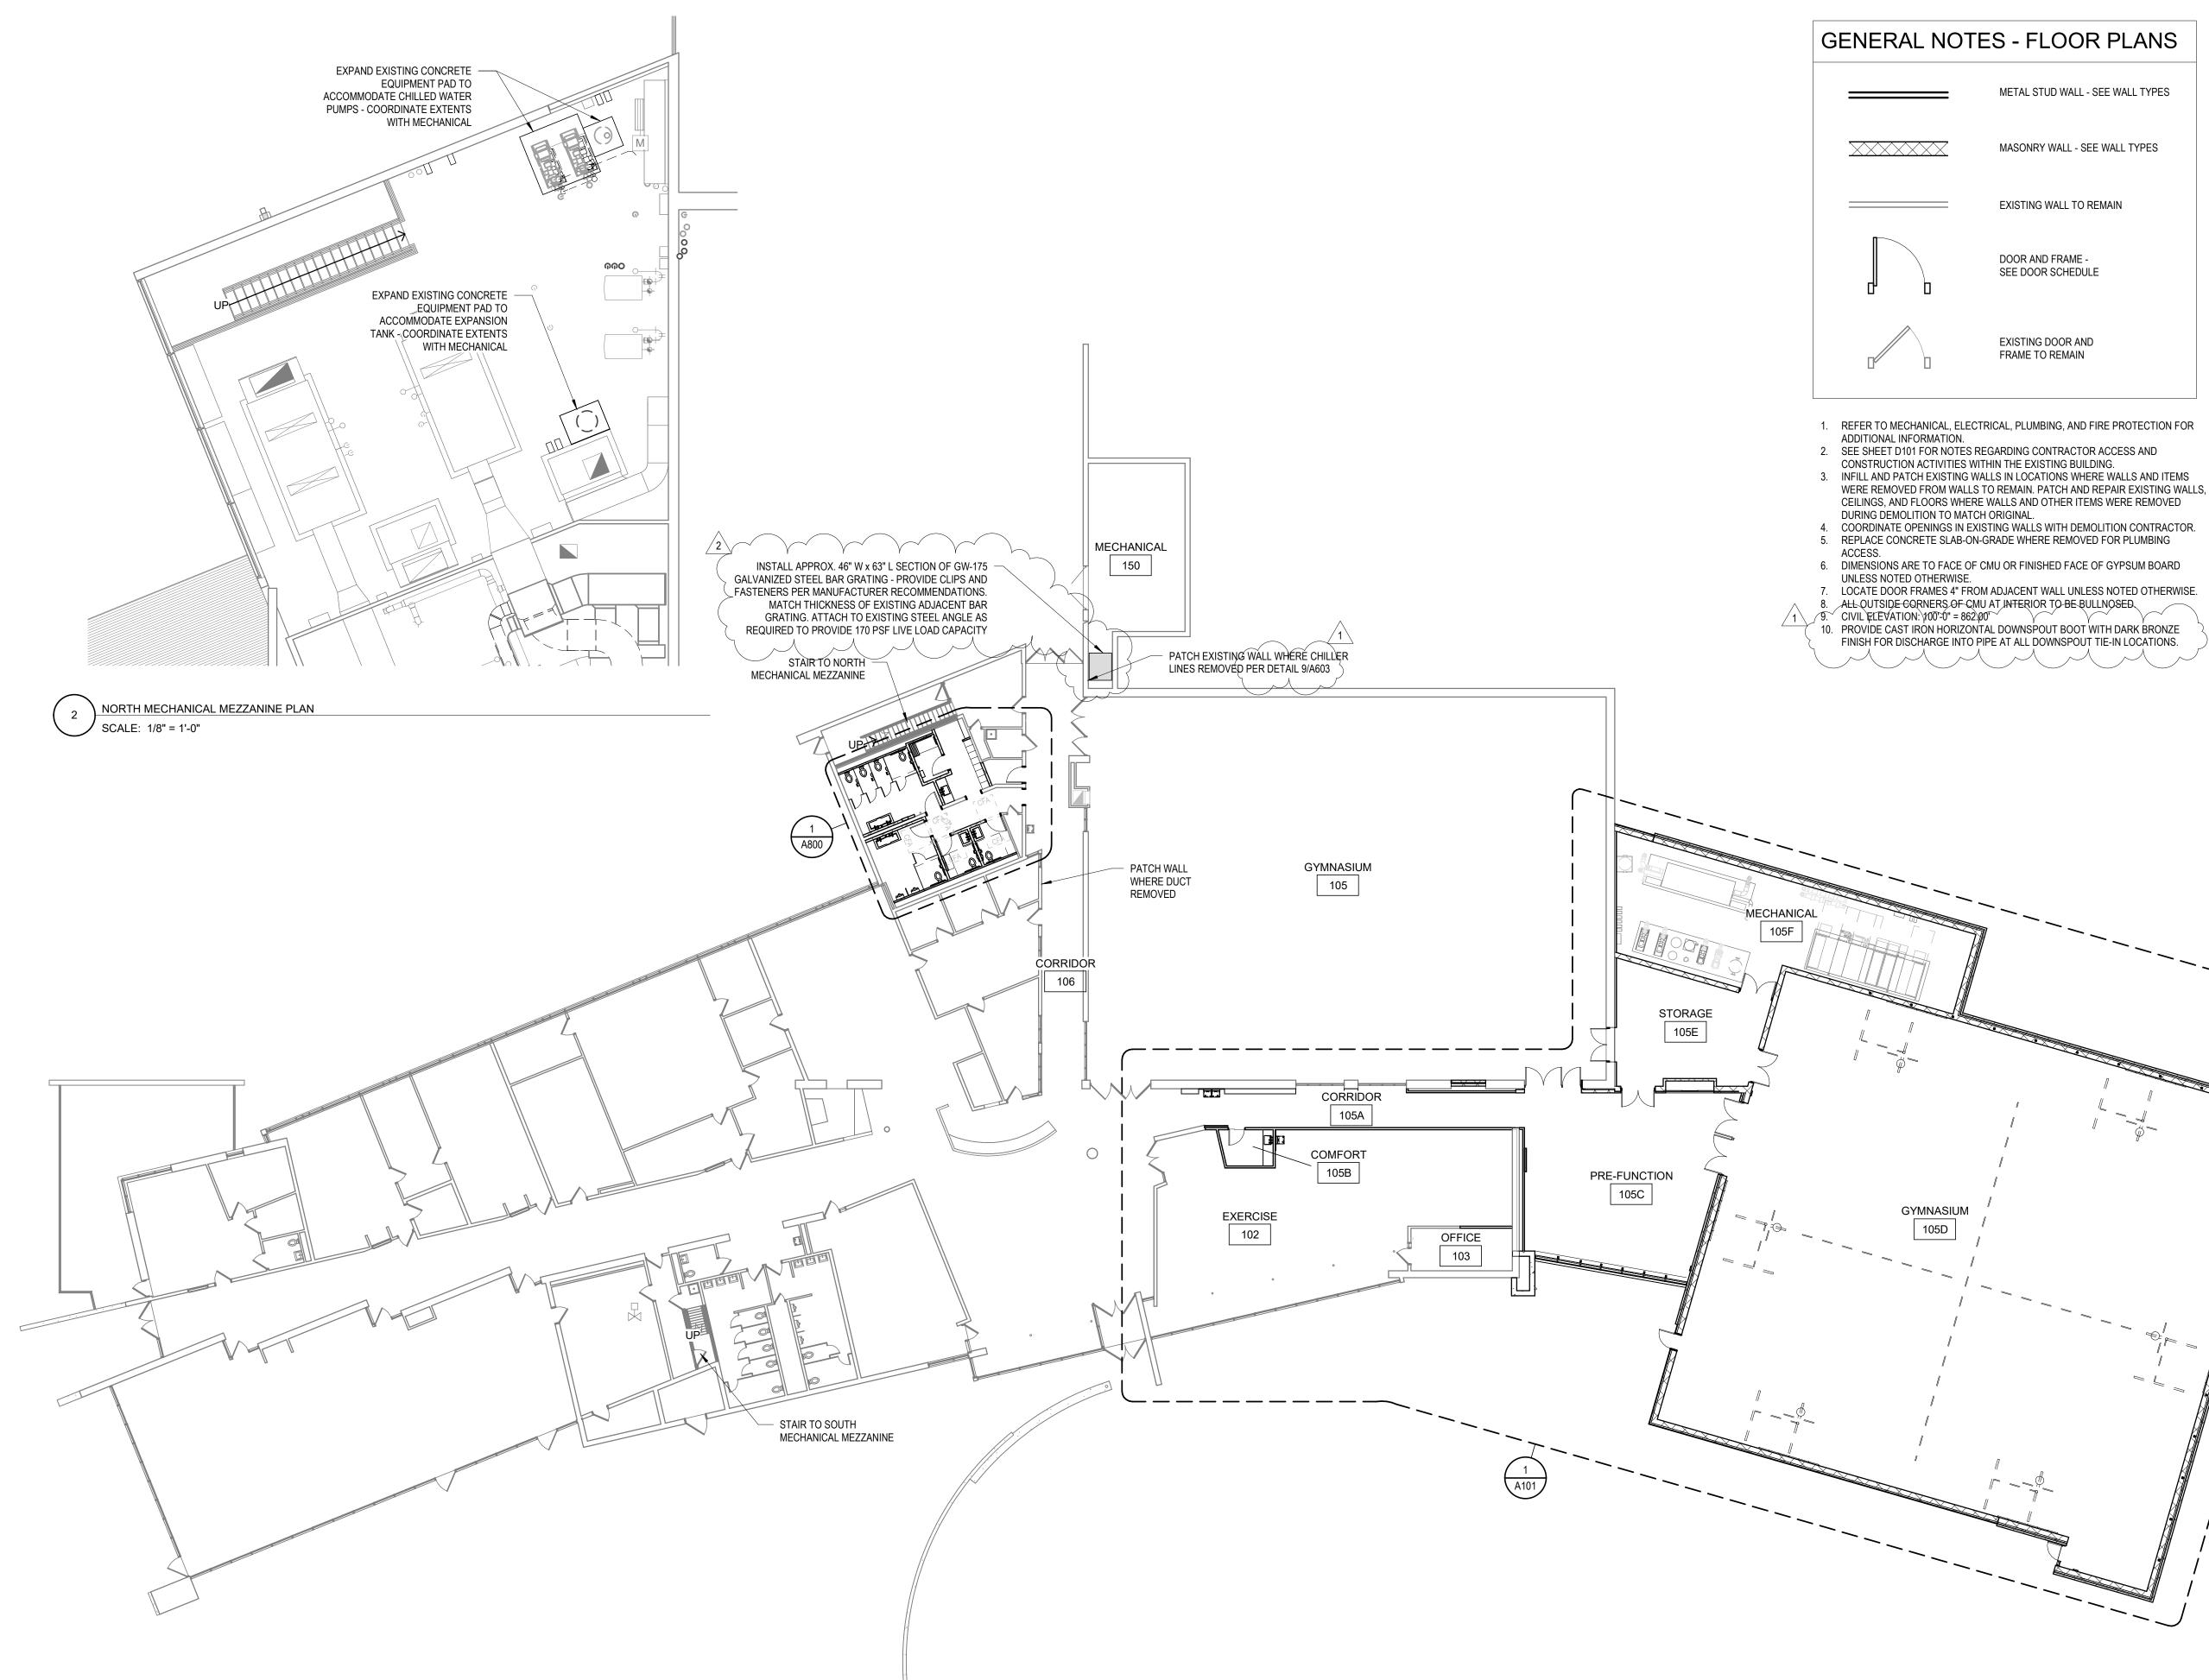

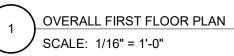



WARNER PARK COMMUNITY RECREATION CENTER EXPANSION

1625 NORTHPORT DRIVE MADISON, WI 53704 CITY OF MADISON PARKS DIVISION 330 EAST LAKESIDE STREET MADISON, WI 53715

PROJECT NUMBER

223471.00

ISSUE) FOR:	
BID SI	ET	5/16/2024
REVISI	ON FOR:	
NO.	DESCRIPTION	DATE
1 2	ADDENDUM #2 ADDENDUM #3	6/14/2024 6/18/2024


DRAWN BY	DK	B
CHECKED BY	WL	Ή

OVERALL FLOOR PLAN








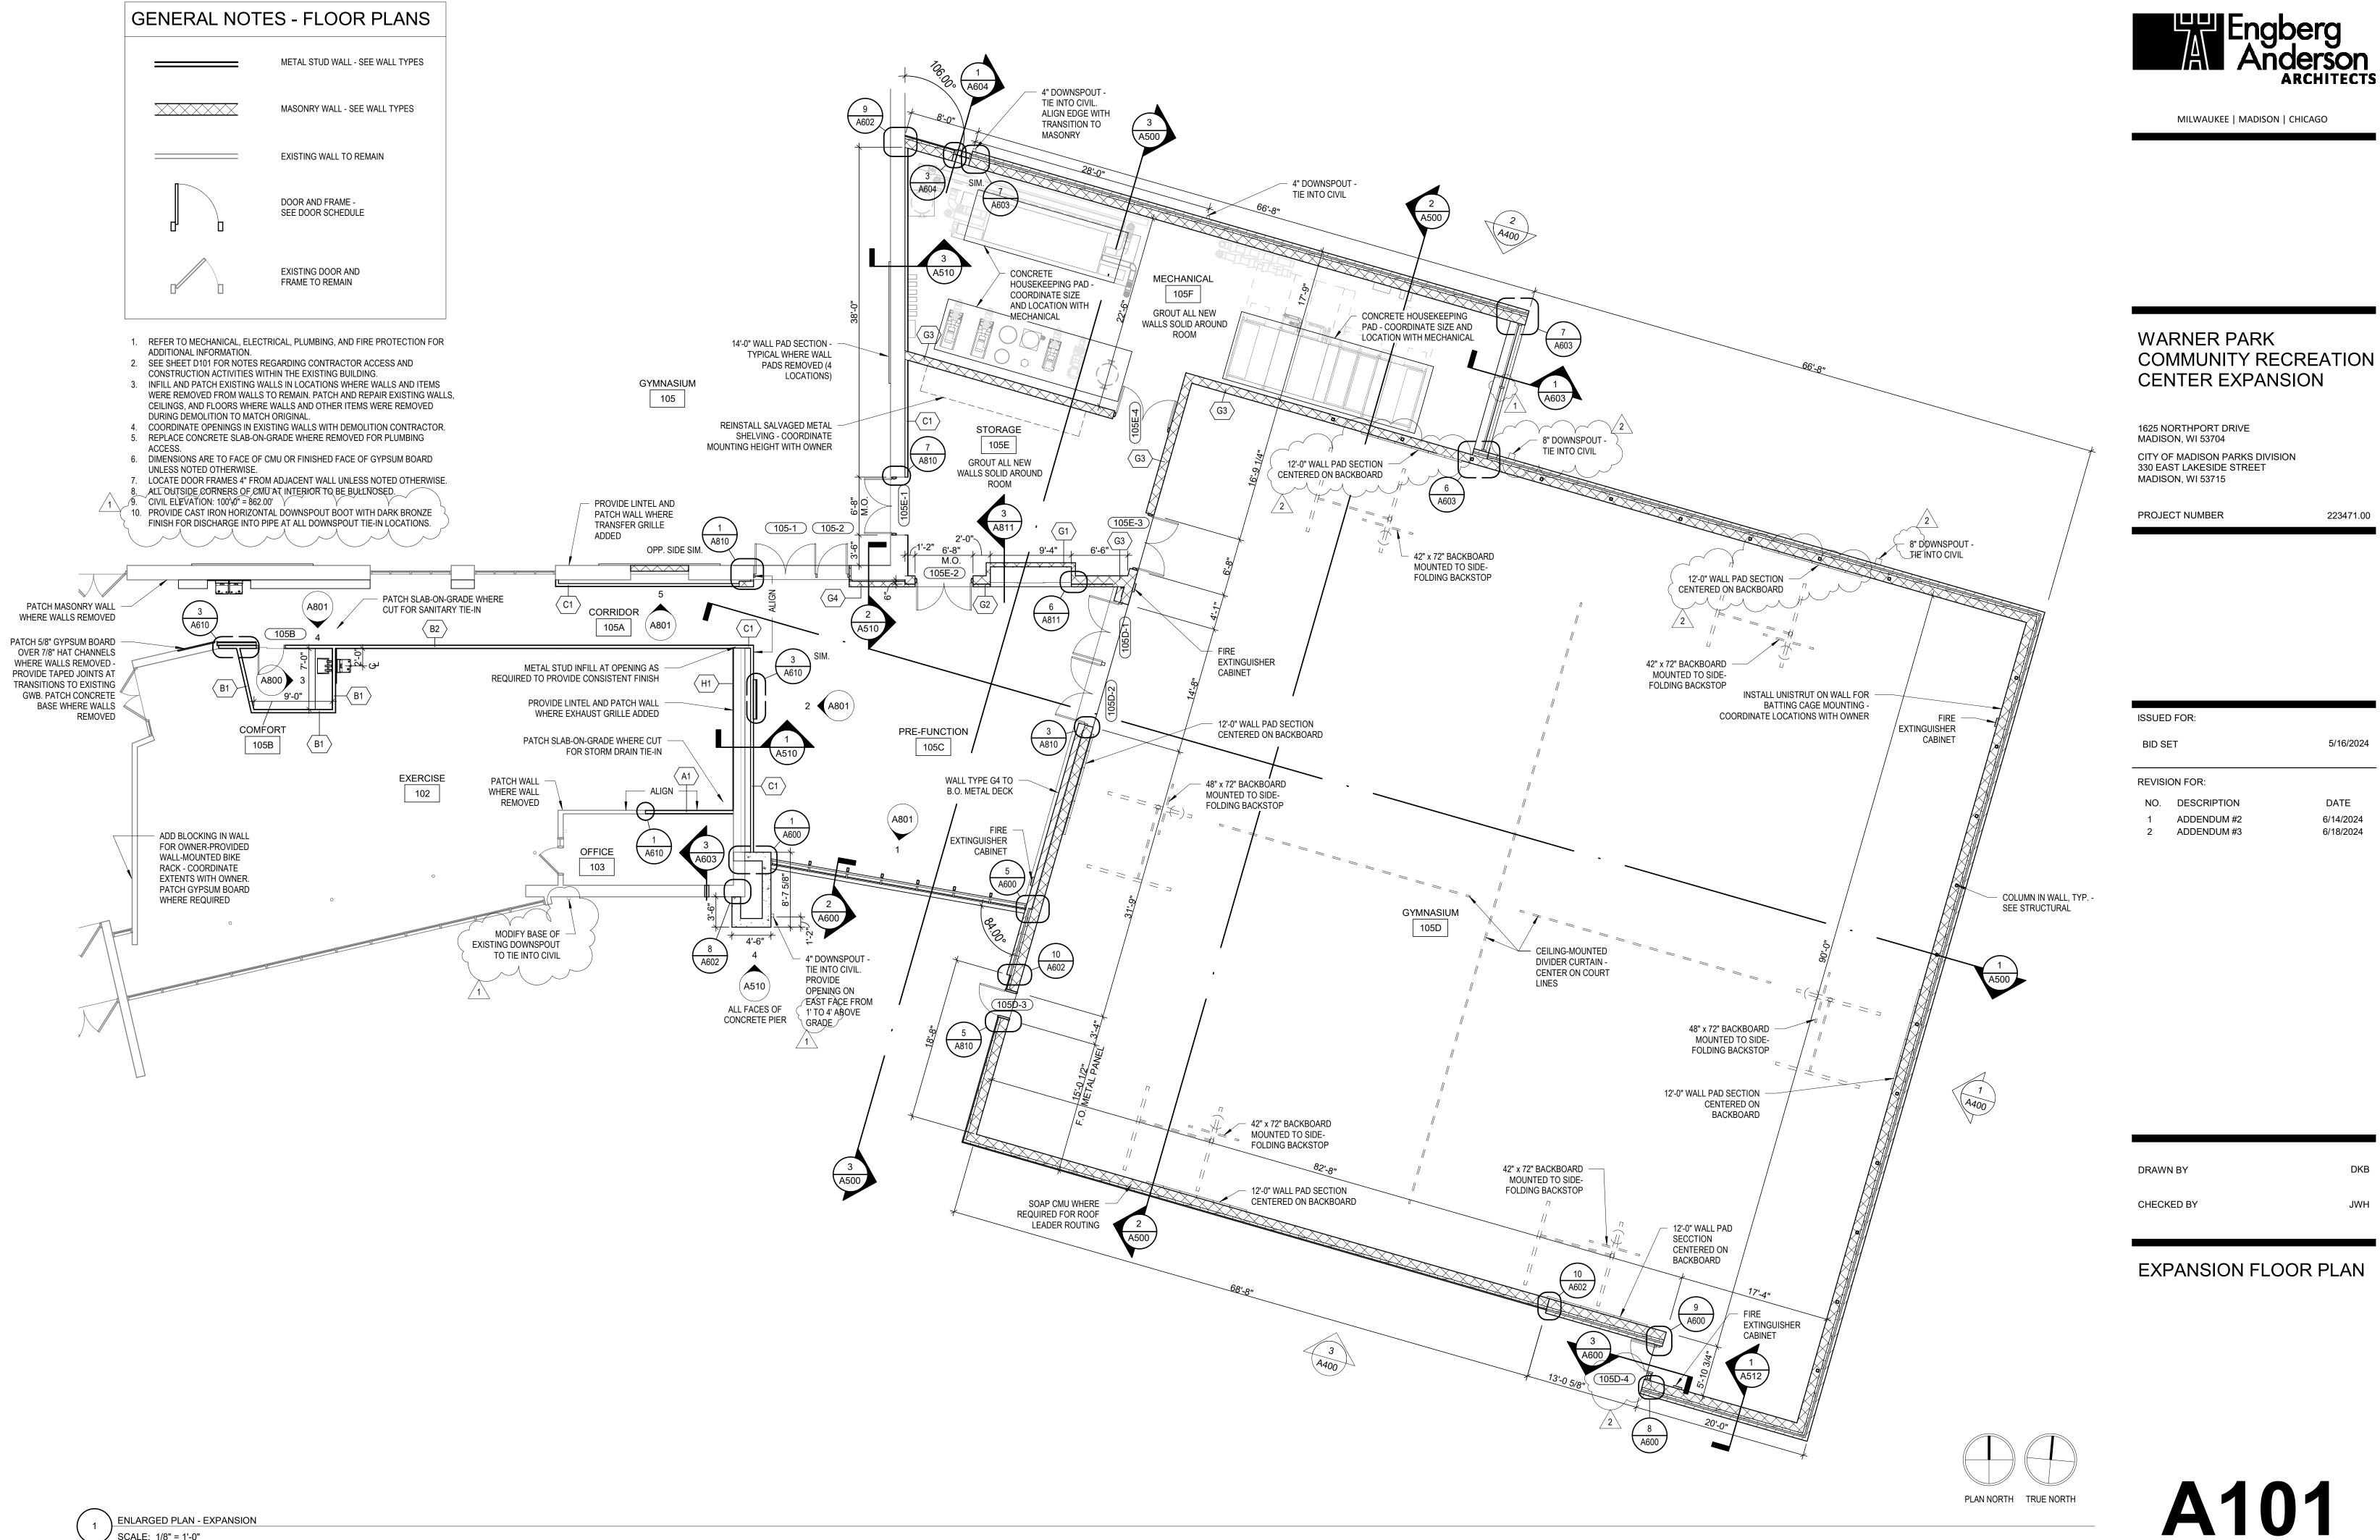





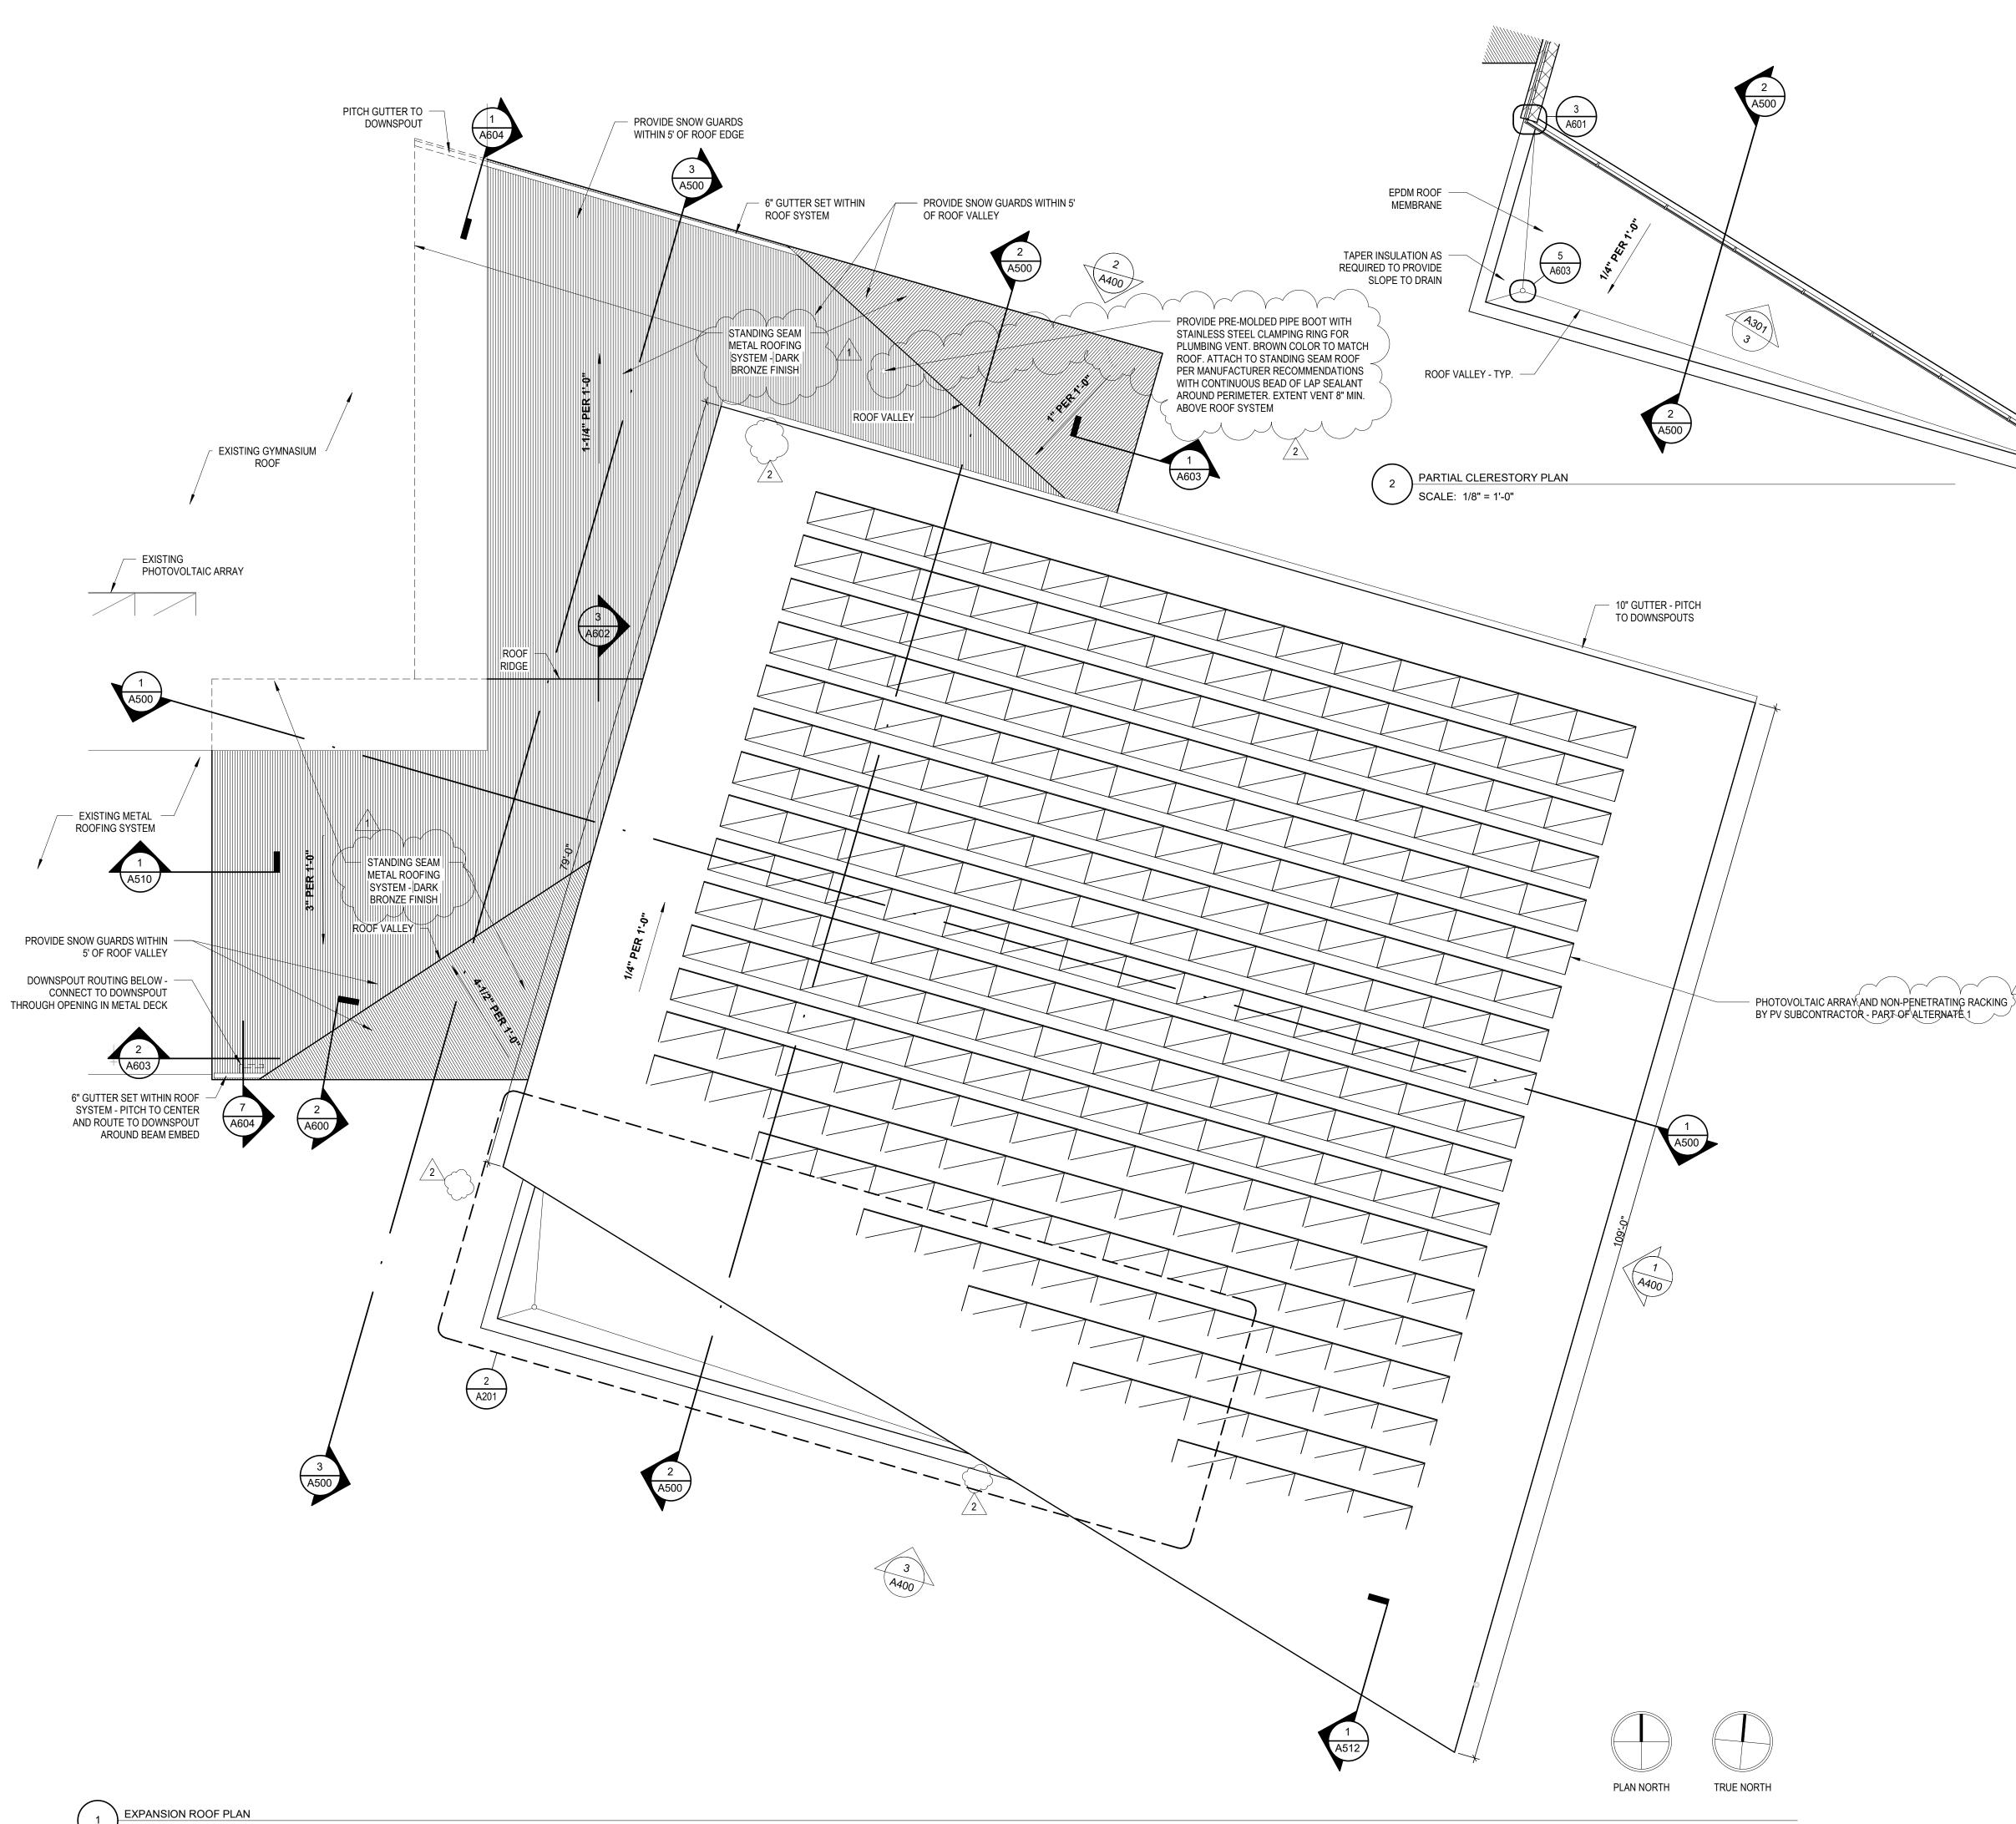





4 A601

WARNER PARK COMMUNITY RECREATION CENTER EXPANSION

1625 NORTHPORT DRIVE MADISON, WI 53704 CITY OF MADISON PARKS DIVISION 330 EAST LAKESIDE STREET MADISON, WI 53715

PROJECT NUMBER


223471.00

ISSUE) FOR:	
BID SI	ΞT	5/16/2024
REVISI	ON FOR:	
NO.	DESCRIPTION	DATE
		6/14/2024

DRAWN BY	DKB
CHECKED BY	JWH

EXPANSION ROOF PLAN



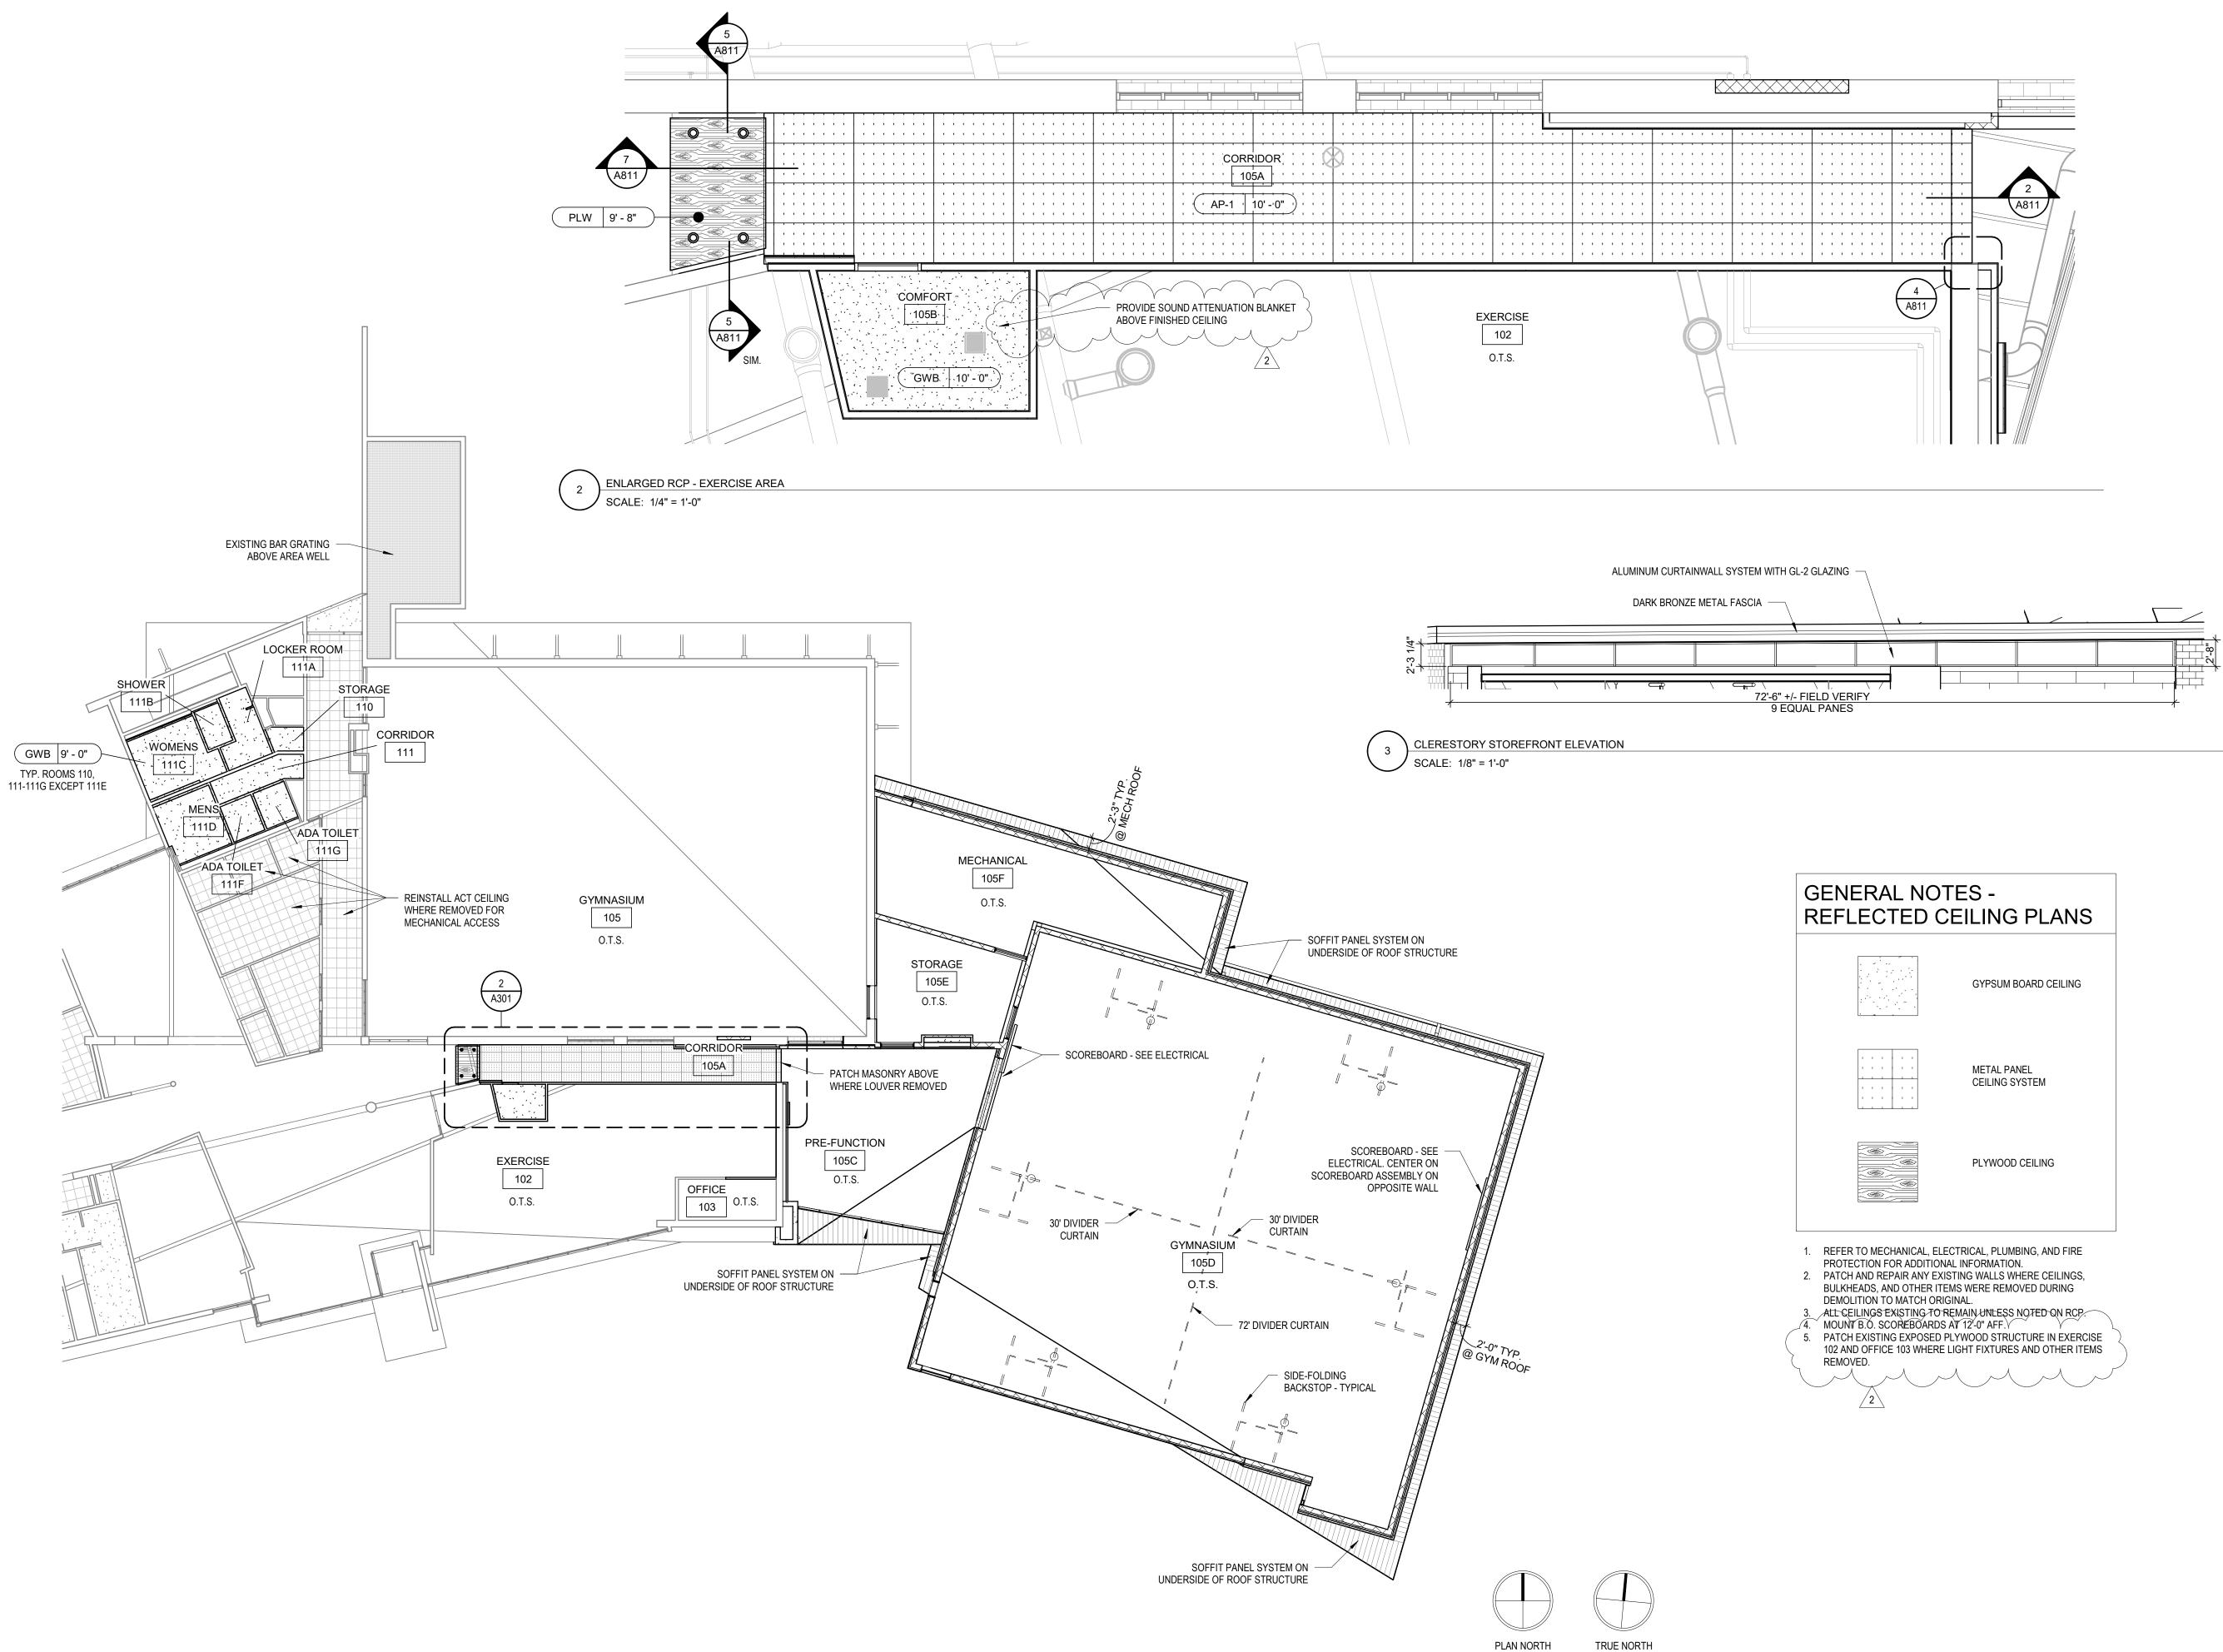





WARNER PARK COMMUNITY RECREATION CENTER EXPANSION

1625 NORTHPORT DRIVE MADISON, WI 53704 CITY OF MADISON PARKS DIVISION 330 EAST LAKESIDE STREET MADISON, WI 53715

PROJECT NUMBER


223471.00


ISSUED FOR:				
ISSUEL	JFUR.			
BID S	ET	5/16/2024		
REVISI	ON FOR:			
NO.	DESCRIPTION	DATE		
2	ADDENDUM #3	6/18/2024		


DRAWN BY	DKB
CHECKED BY	JWH

EXPANSION REFLECTED **CEILING PLAN**



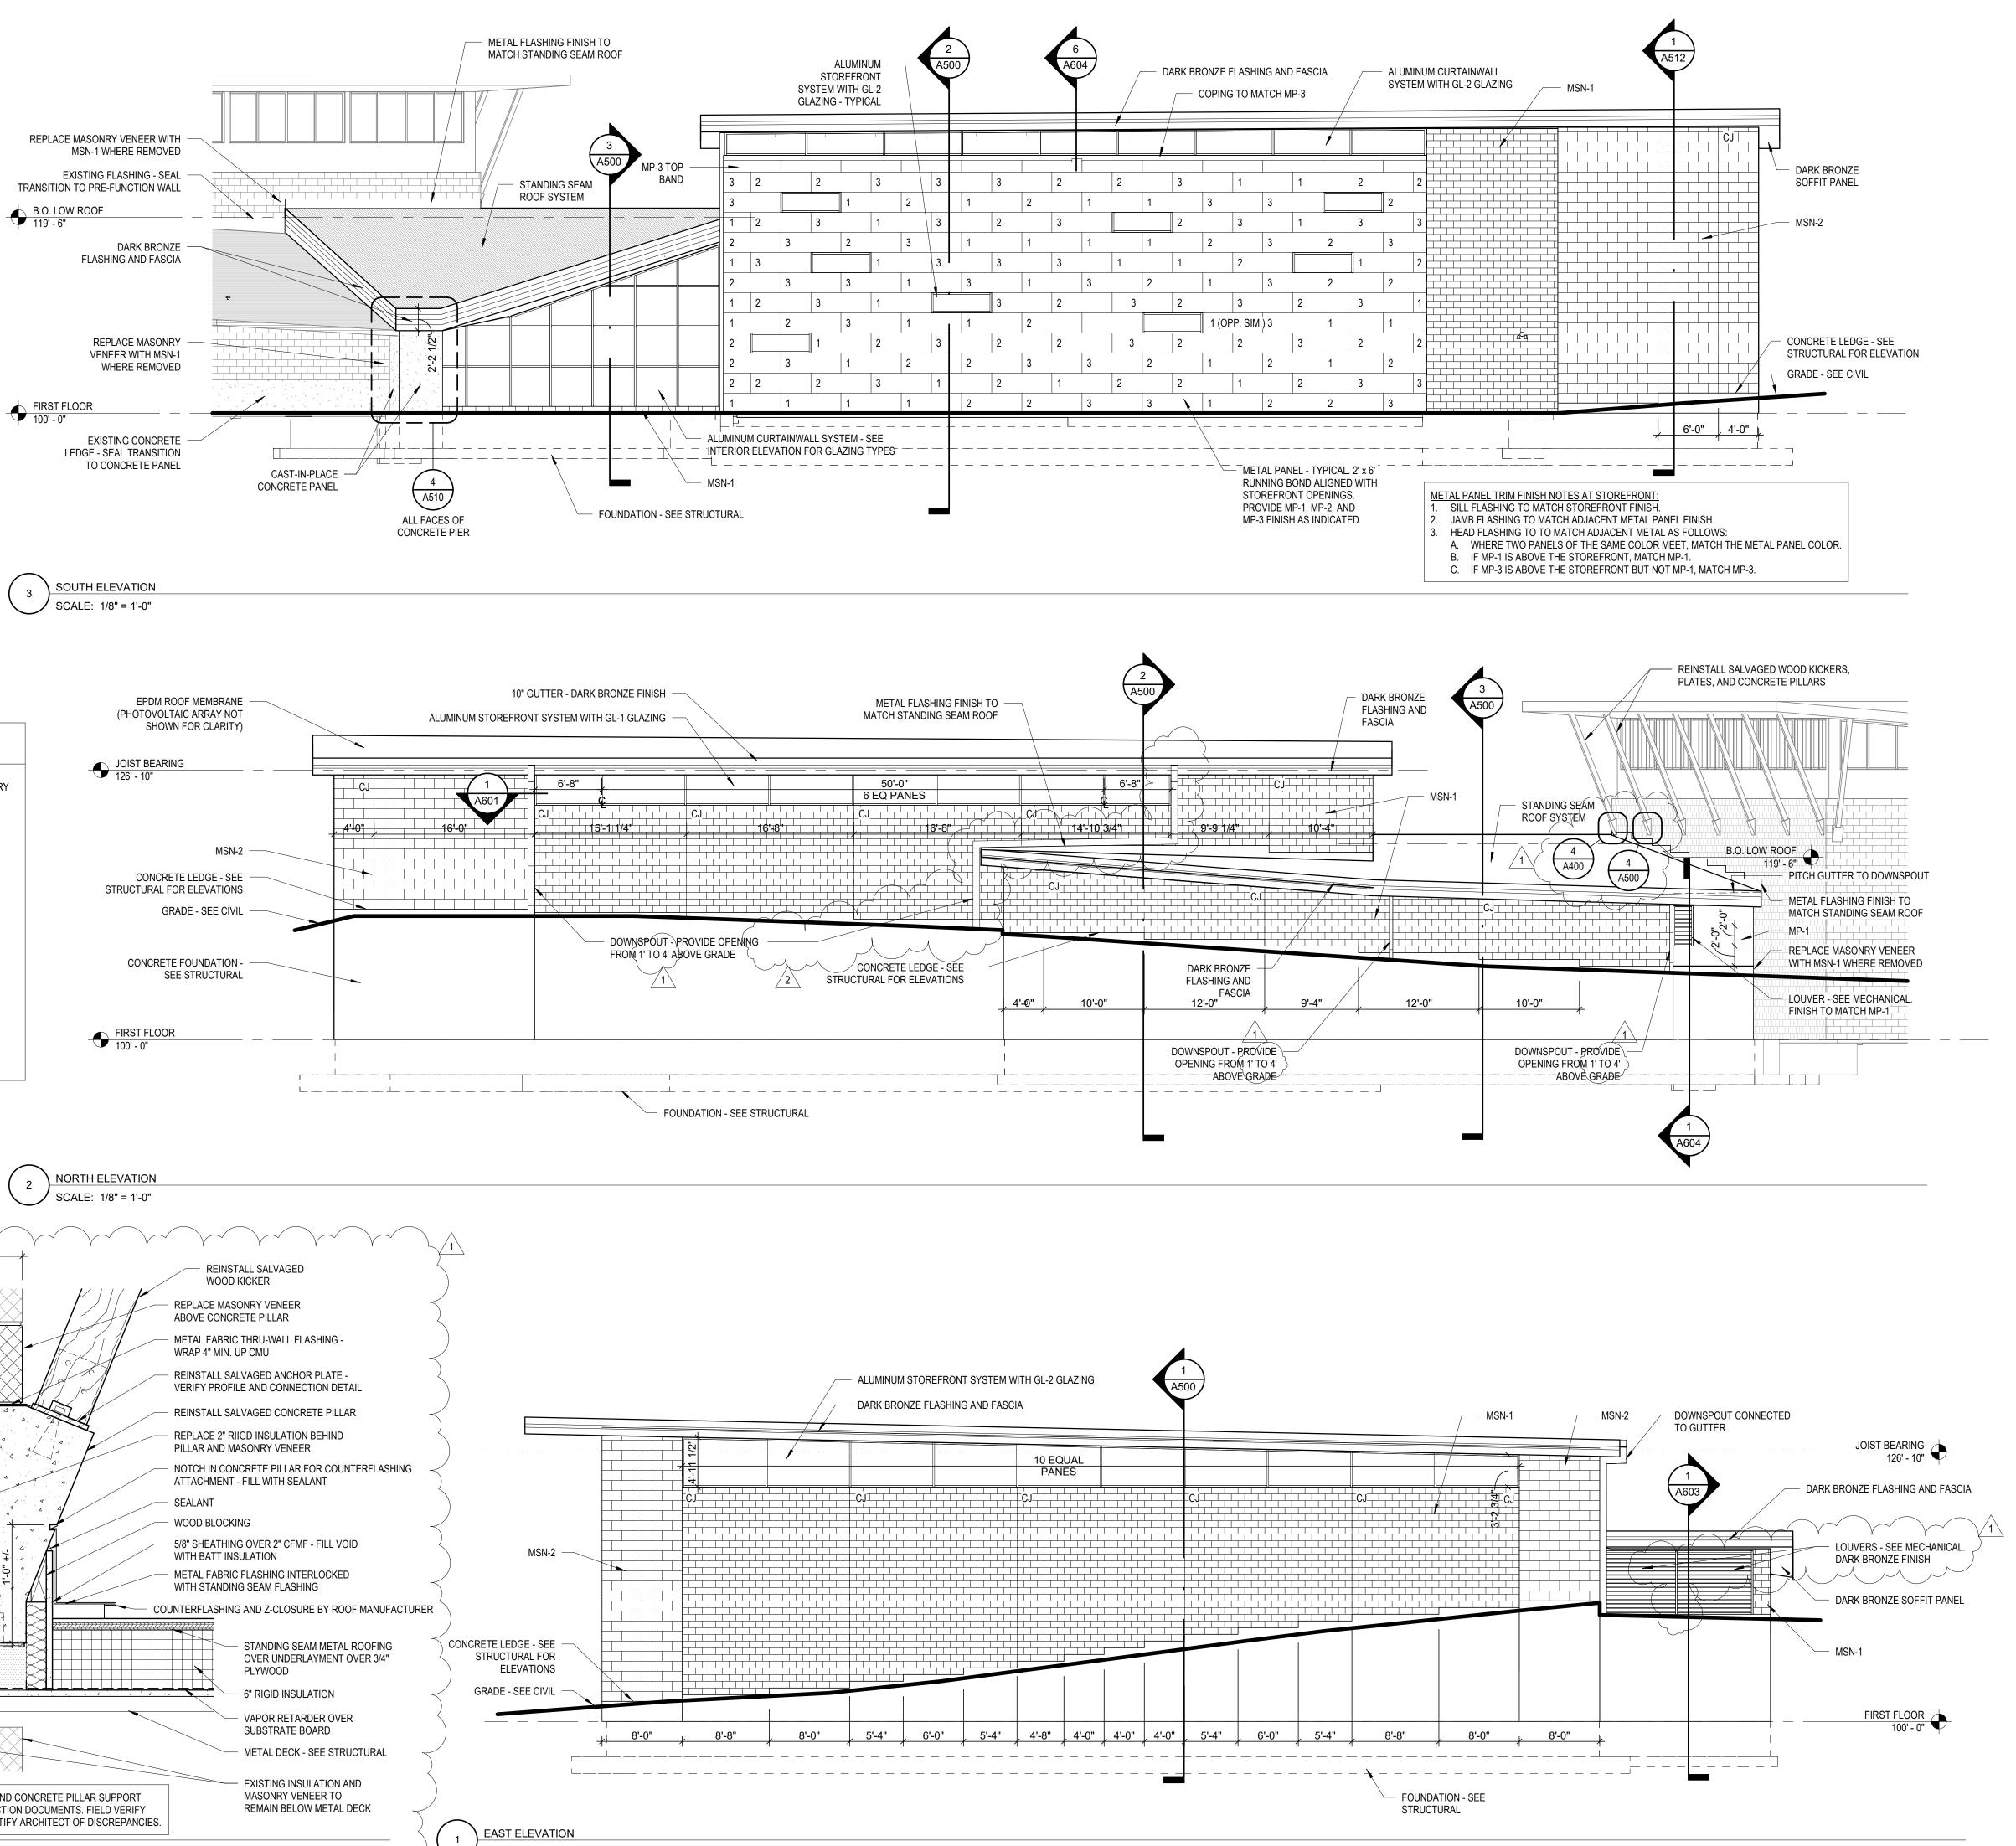

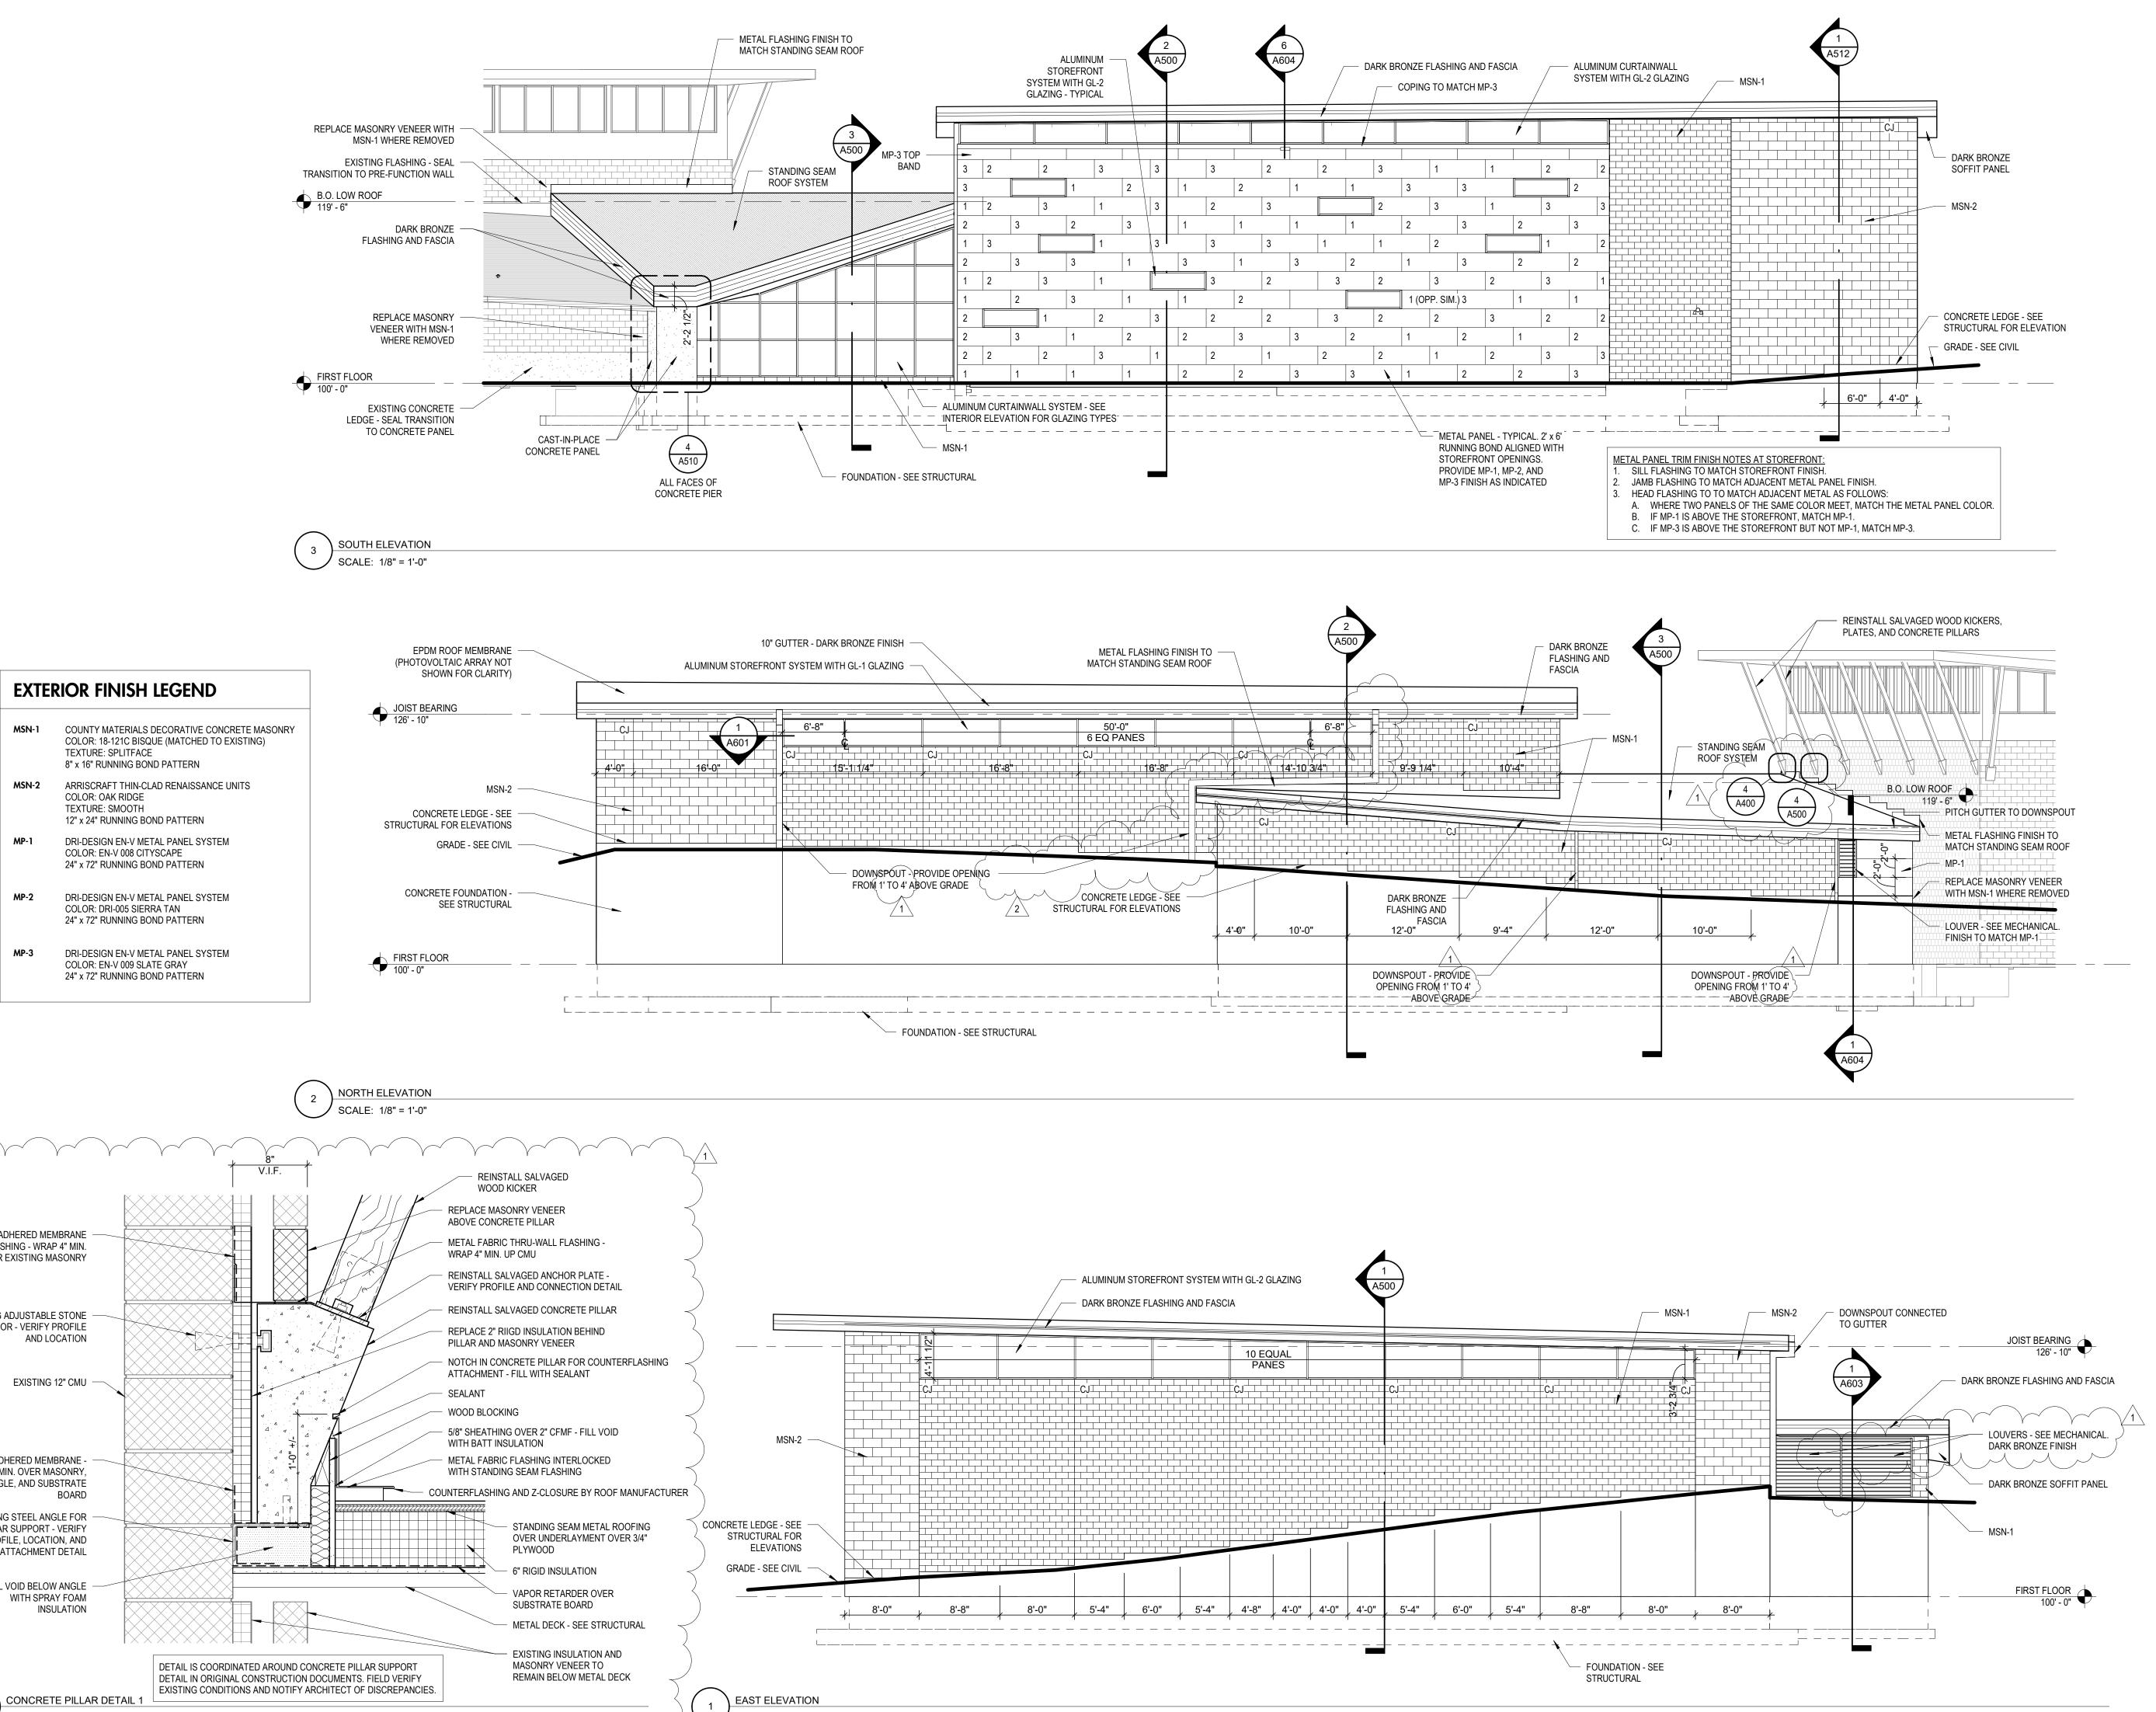

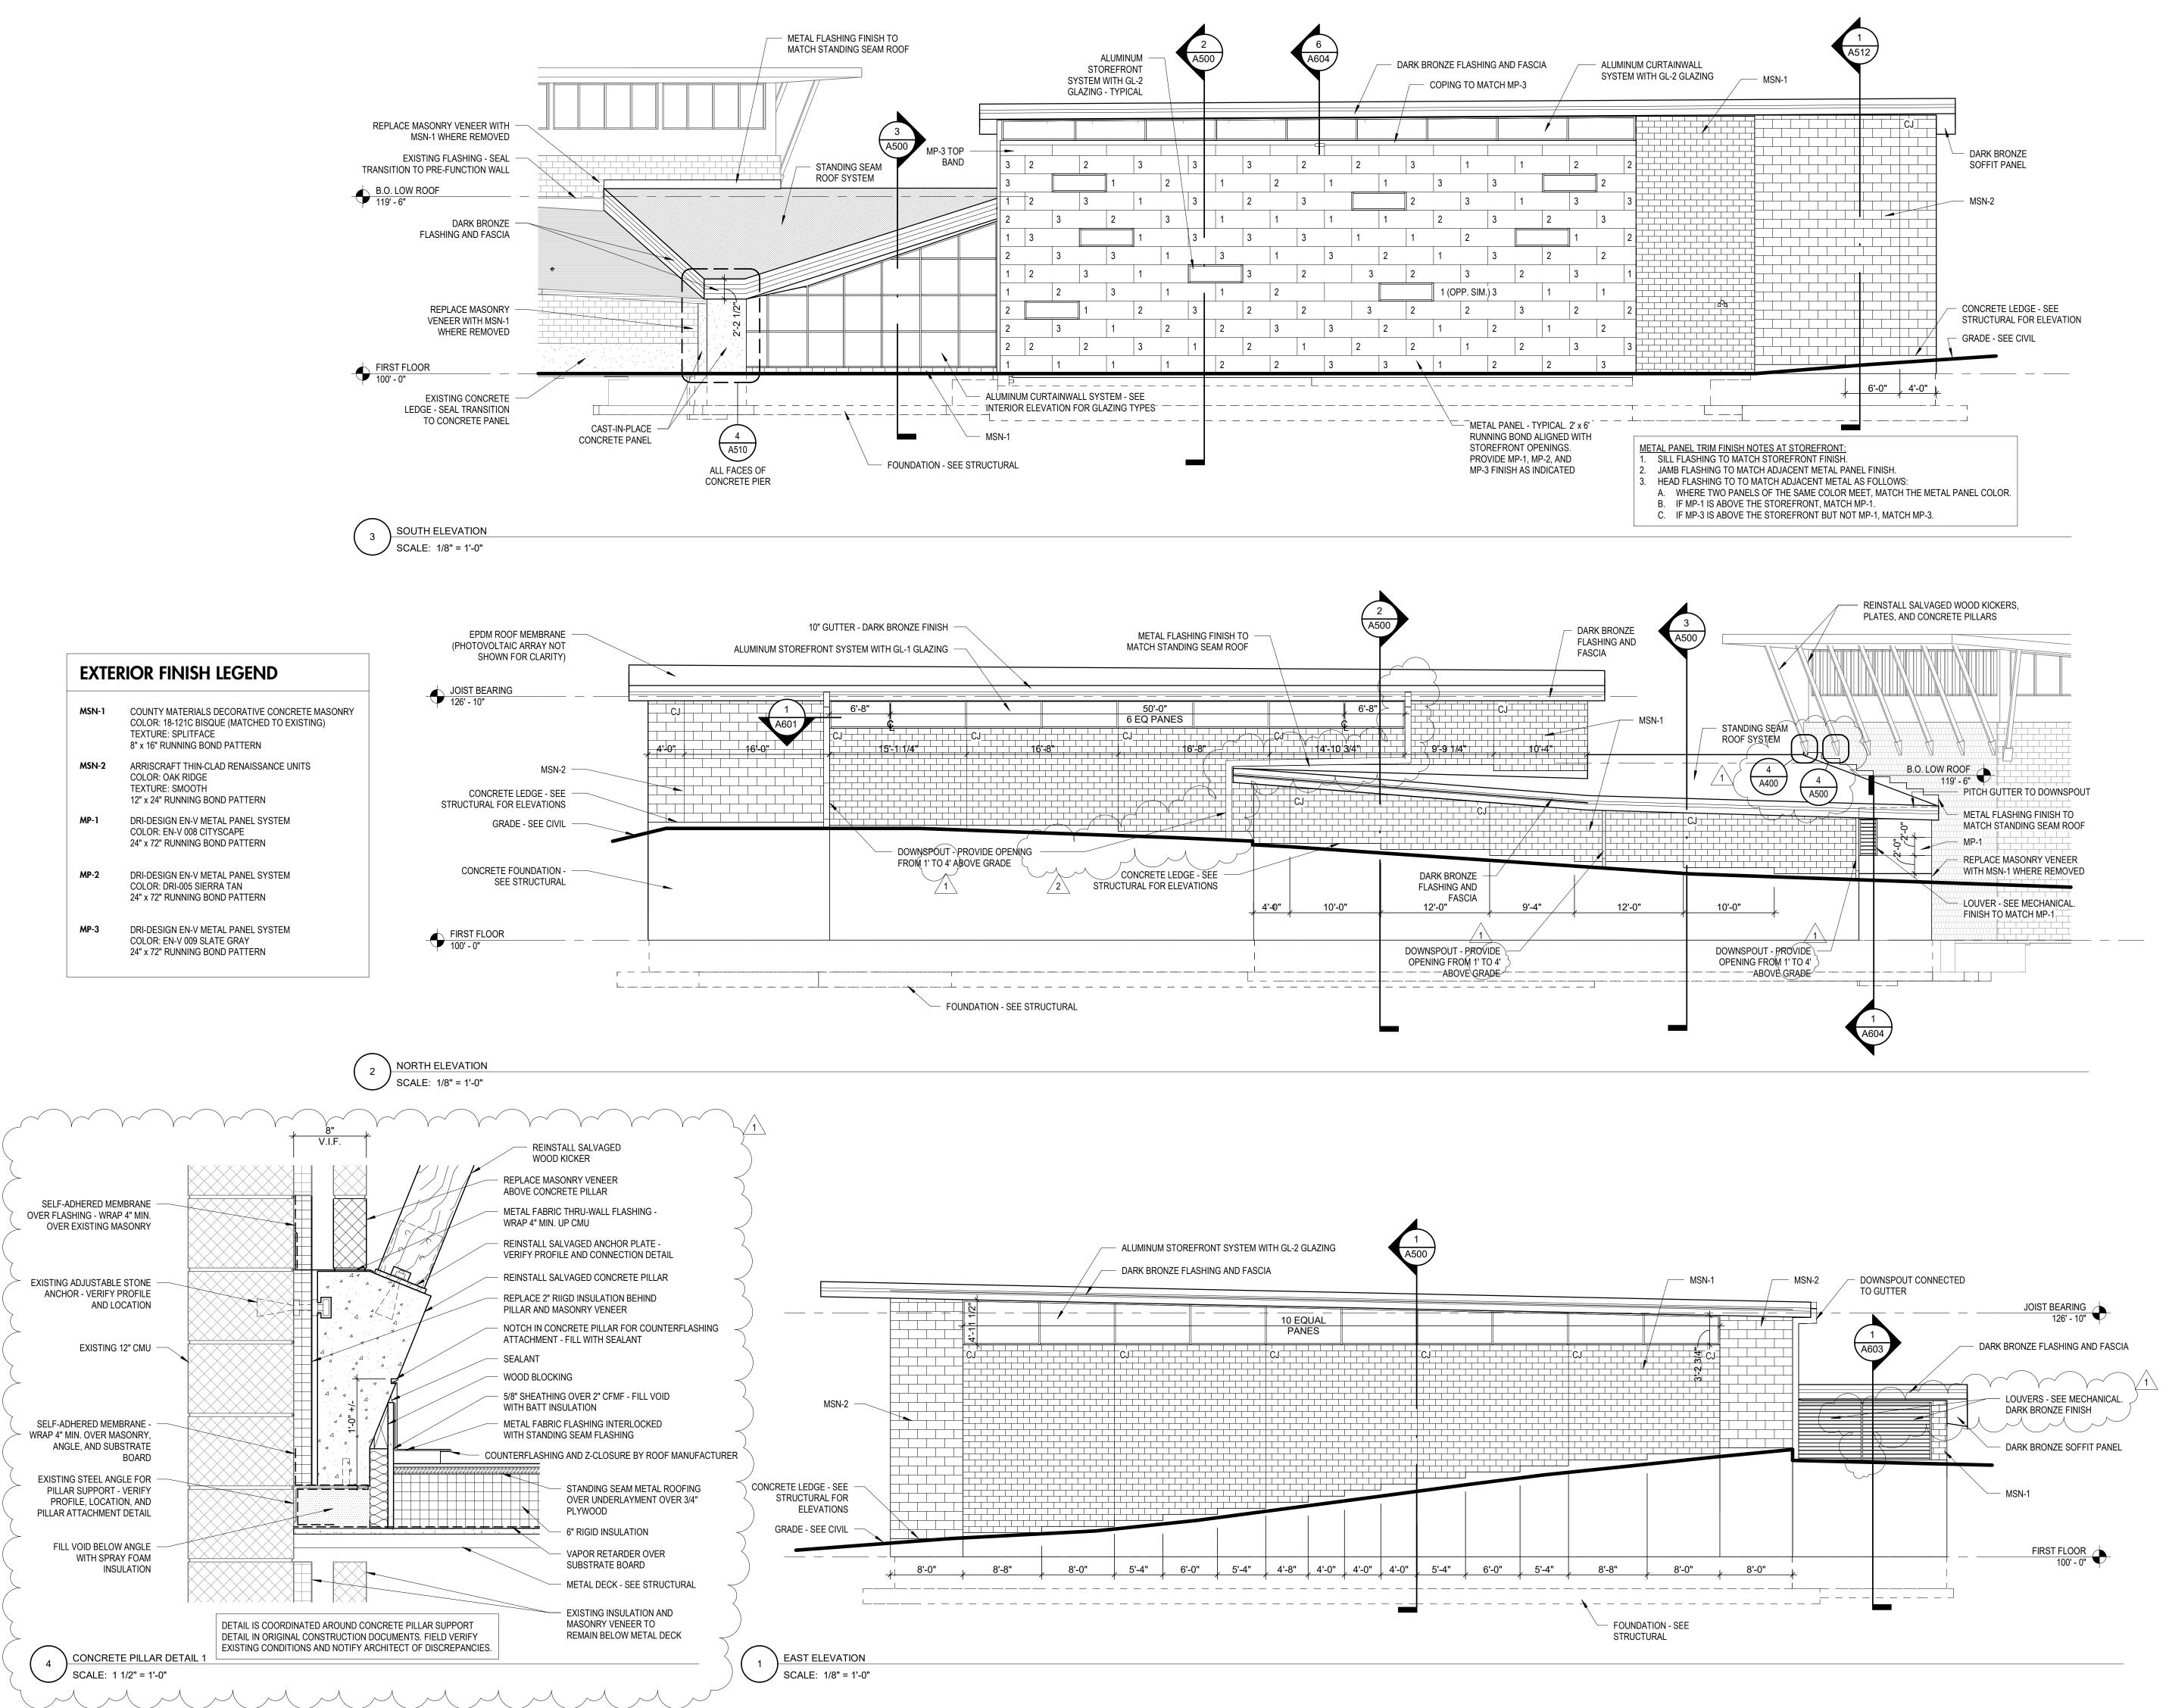




WARNER PARK COMMUNITY RECREATION **CENTER EXPANSION**

1625 NORTHPORT DRIVE MADISON, WI 53704 CITY OF MADISON PARKS DIVISION 330 EAST LAKESIDE STREET MADISON, WI 53715

PROJECT NUMBER


223471.00

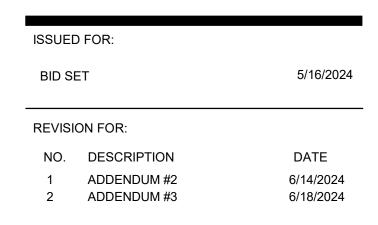




EXTERIOR ELEVATIONS



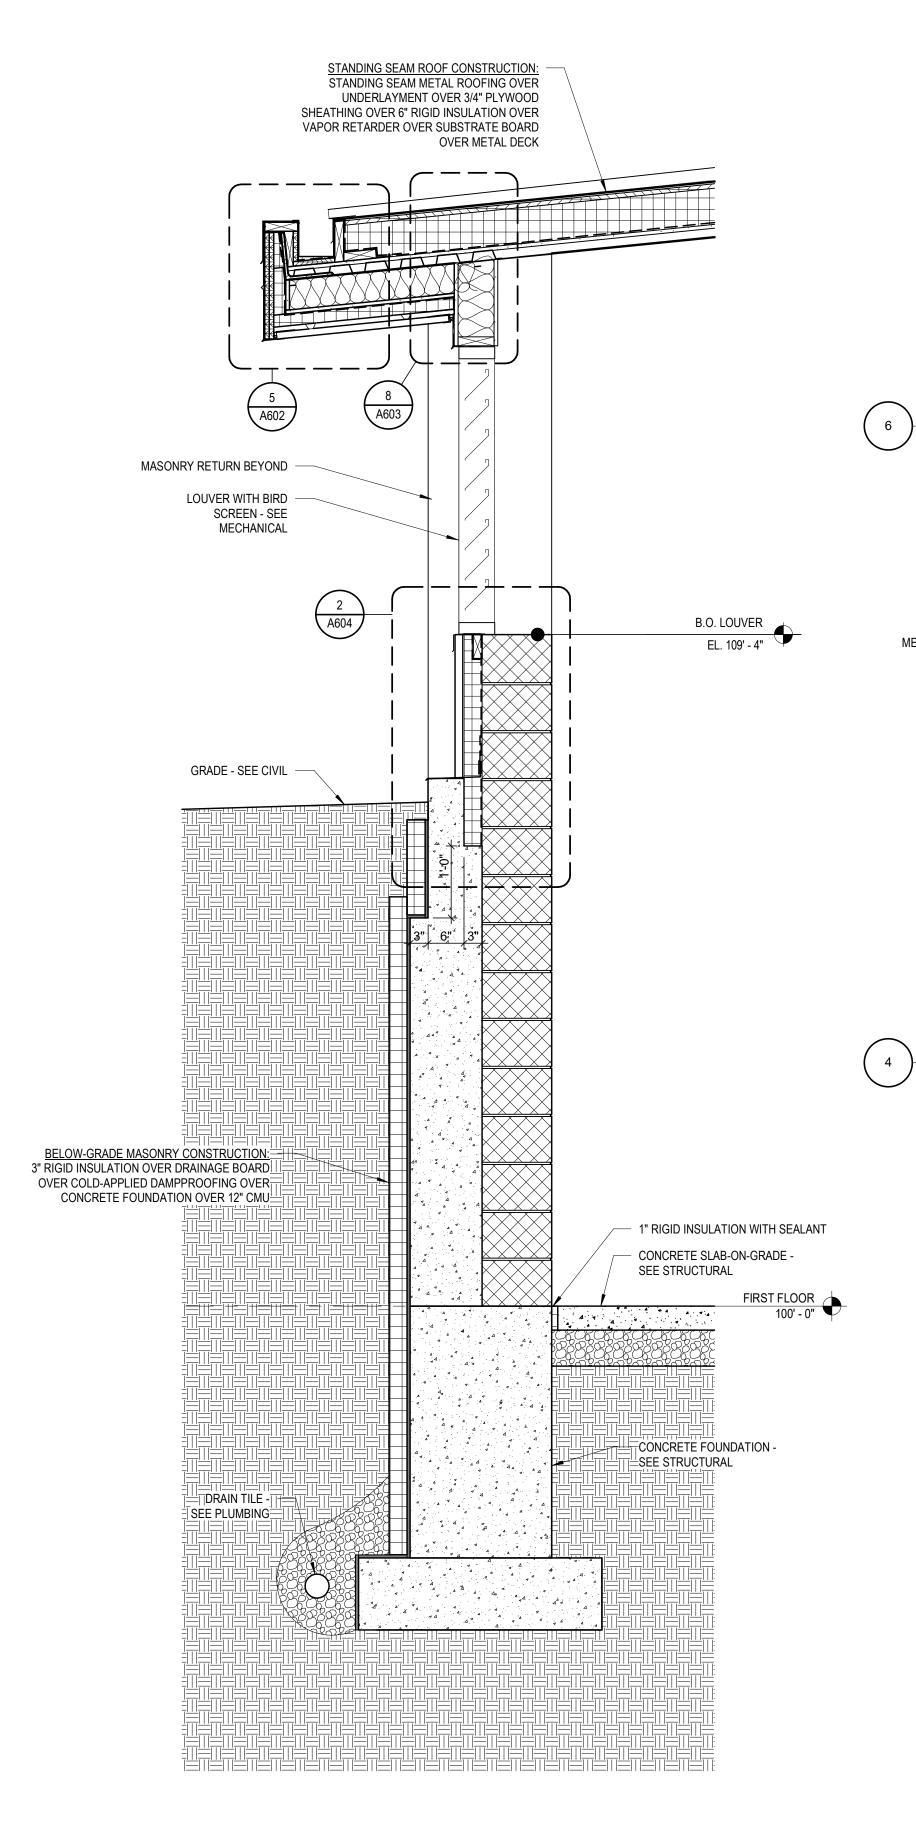



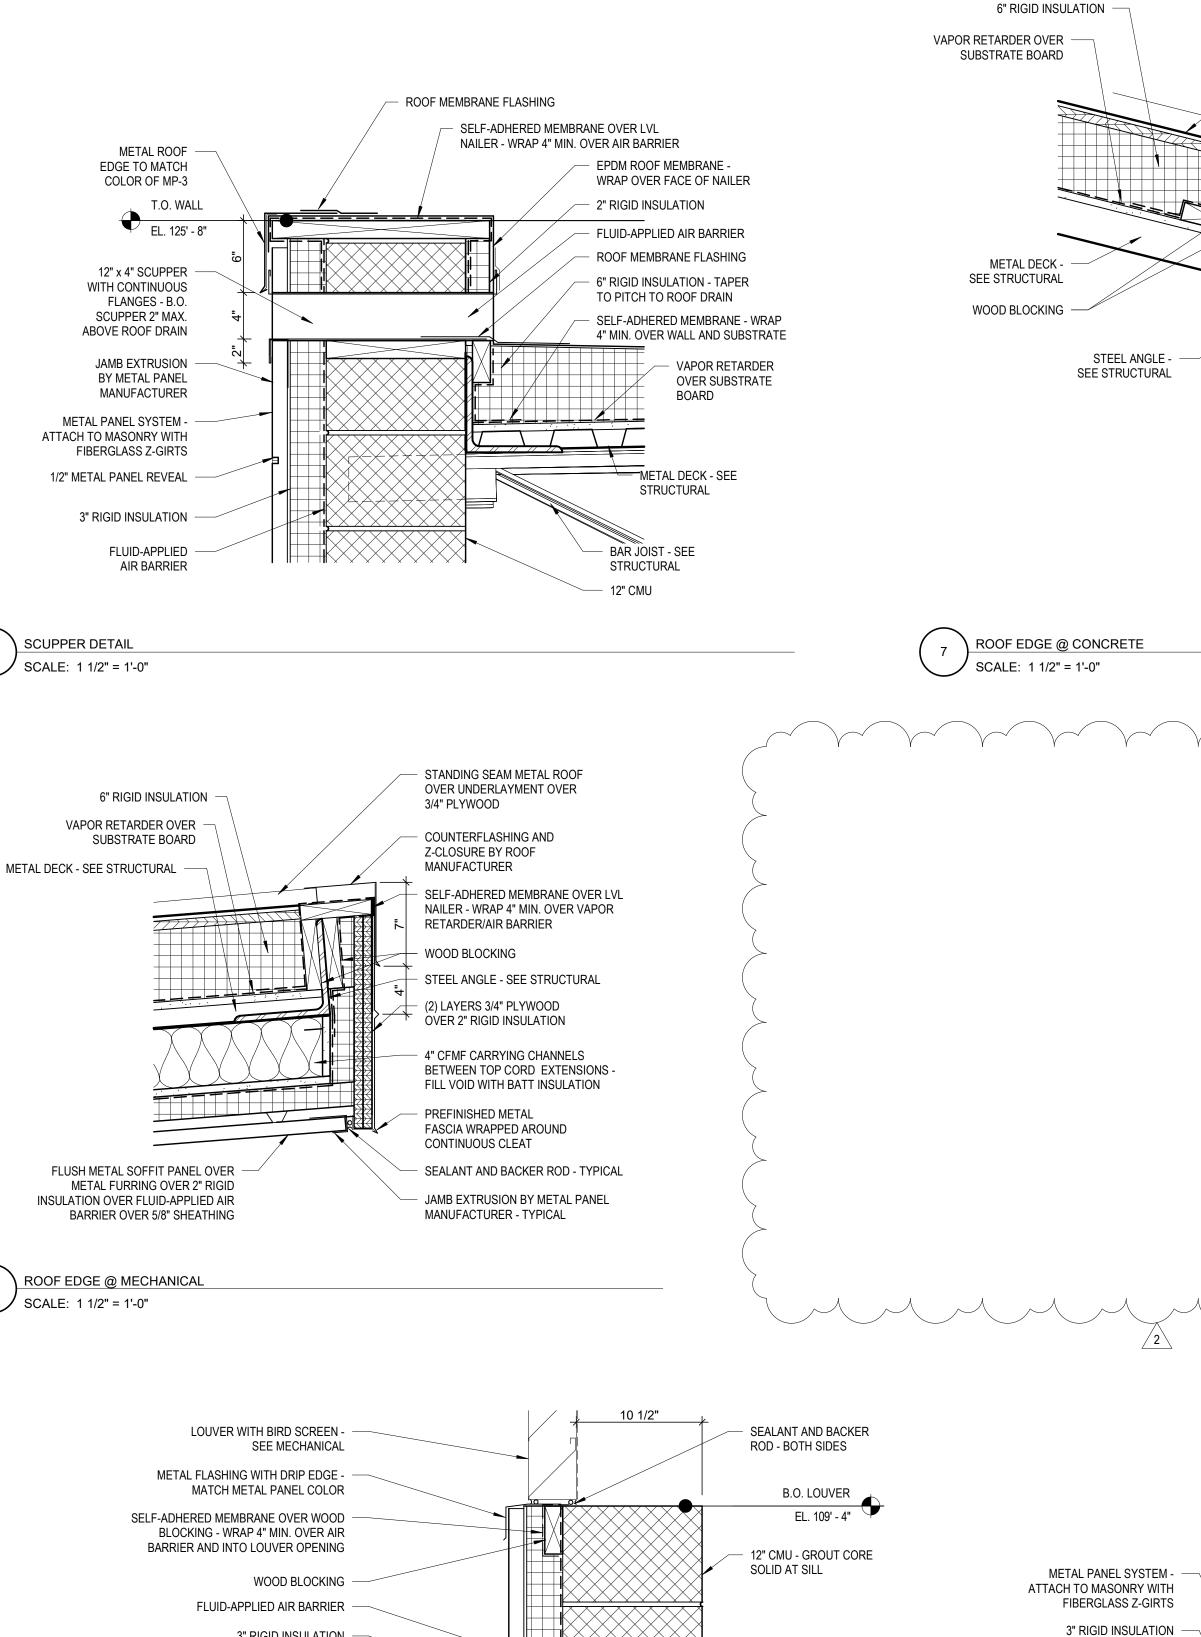

3" RIGID INSULATION METAL PANEL SYSTEM - ATTACH TO -

MASONRY WITH FIBERGLASS Z-GIRTS SELF-ADHERED MEMBRANE OVER METAL FLASHING - WRAP 4" MIN. OVER AIR BARRIER

METAL SILL FLASHING - SLOPE AWAY FROM -BUILDING. EXTEND UP MASONRY 4" MIN.


CONCRETE FOUNDATION WALL - SEE STRUCTURAL. SLOPE AWAY FROM BUILDING GRADE - SEE CIVIL


3" RIGID INSULATION

DRAINAGE BOARD

COLD-APPLIED DAMPPROOFING 4 1/2"-


4 1/2"

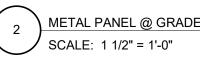

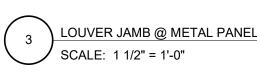

FLUID-APPLIED -

AIR BARRIER

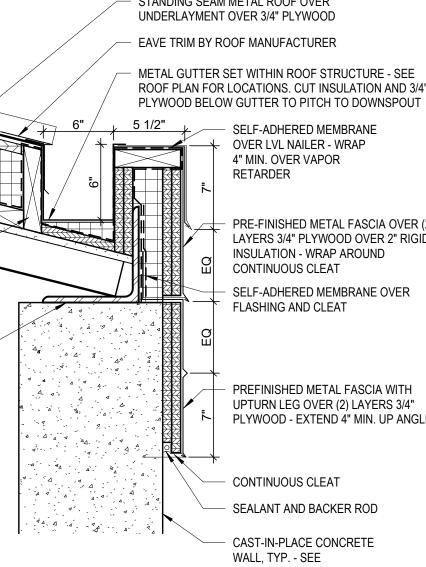

STANDING SEAM METAL ROOF OVER

METAL GUTTER SET WITHIN ROOF STRUCTURE - SEE ROOF PLAN FOR LOCATIONS. CUT INSULATION AND 3/4"

PRE-FINISHED METAL FASCIA OVER (2) LAYERS 3/4" PLYWOOD OVER 2" RIGID INSULATION - WRAP AROUND - SELF-ADHERED MEMBRANE OVER

PREFINISHED METAL FASCIA WITH UPTURN LEG OVER (2) LAYERS 3/4" PLYWOOD - EXTEND 4" MIN. UP ANGLE

- CAST-IN-PLACE CONCRETE ELEVATIONS FOR LEDGE HEIGHTS AND LOCATIONS

SELF-ADHERED MEMBRANE - WRAP OVER

JAMB EXTRUSION BY METAL

PANEL MANUFACTURER

ATTACH TO BLOCKING

- METAL CLOSURE FLASHING

- LOUVER WITH BIRD

SCREEN - SEE MECHANICAL

WOOD BLOCKING AND METAL FLASHING

AND 4" MIN. OVER AIR BARRIER

2x4 WOOD BLOCKING

SEALANT AND BACKER ROD -

BOTH SIDES



MILWAUKEE | MADISON | CHICAGO

WARNER PARK COMMUNITY RECREATION CENTER EXPANSION

1625 NORTHPORT DRIVE MADISON, WI 53704

CITY OF MADISON PARKS DIVISION 330 EAST LAKESIDE STREET MADISON, WI 53715

PROJECT NUMBER

223471.00


BID SI	ΞT	5/16/2024
REVISI	ON FOR:	
NO.	DESCRIPTION	DATE
2	ADDENDUM #3	6/18/2024


DRAWN BY	DKB
CHECKED BY	JWH


EXTERIOR DETAILS





12" CMU

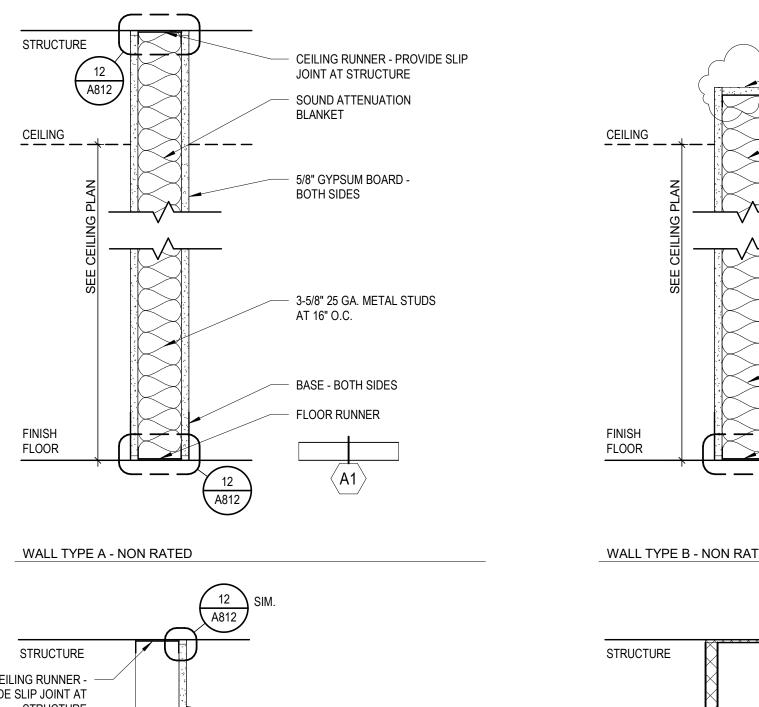


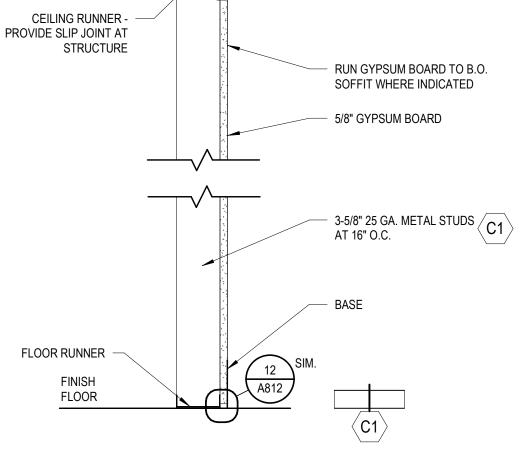


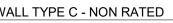

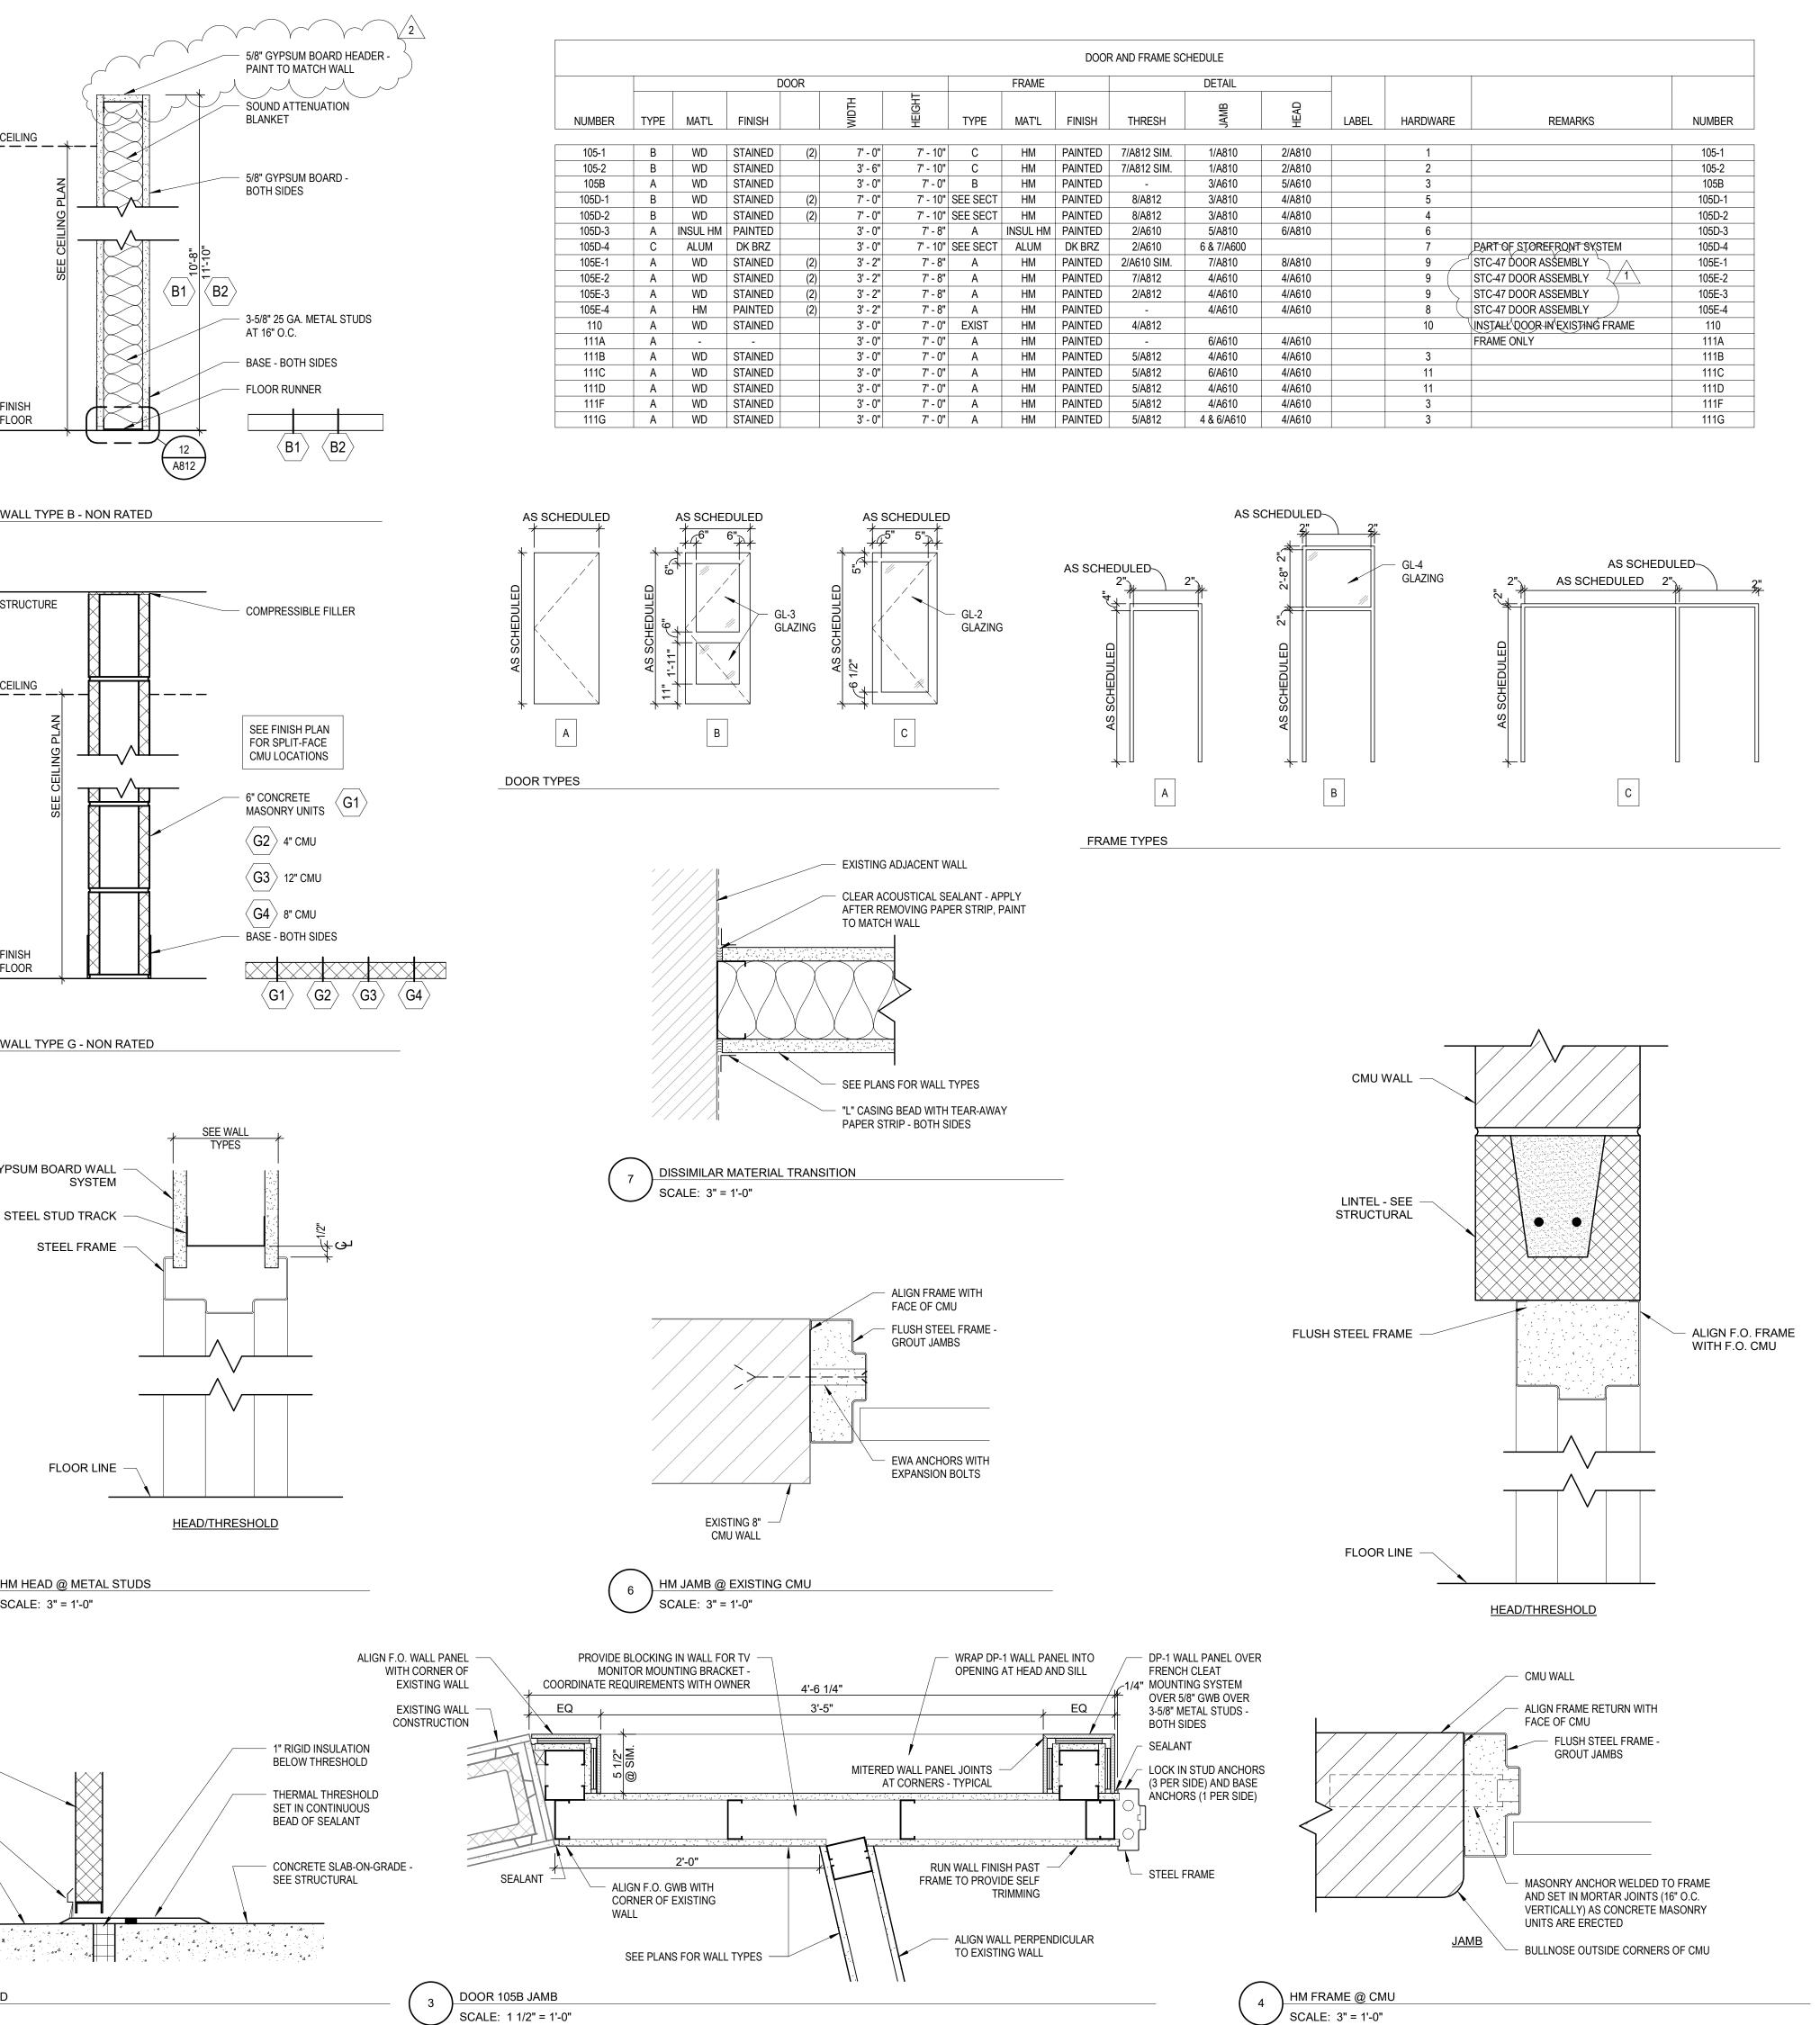

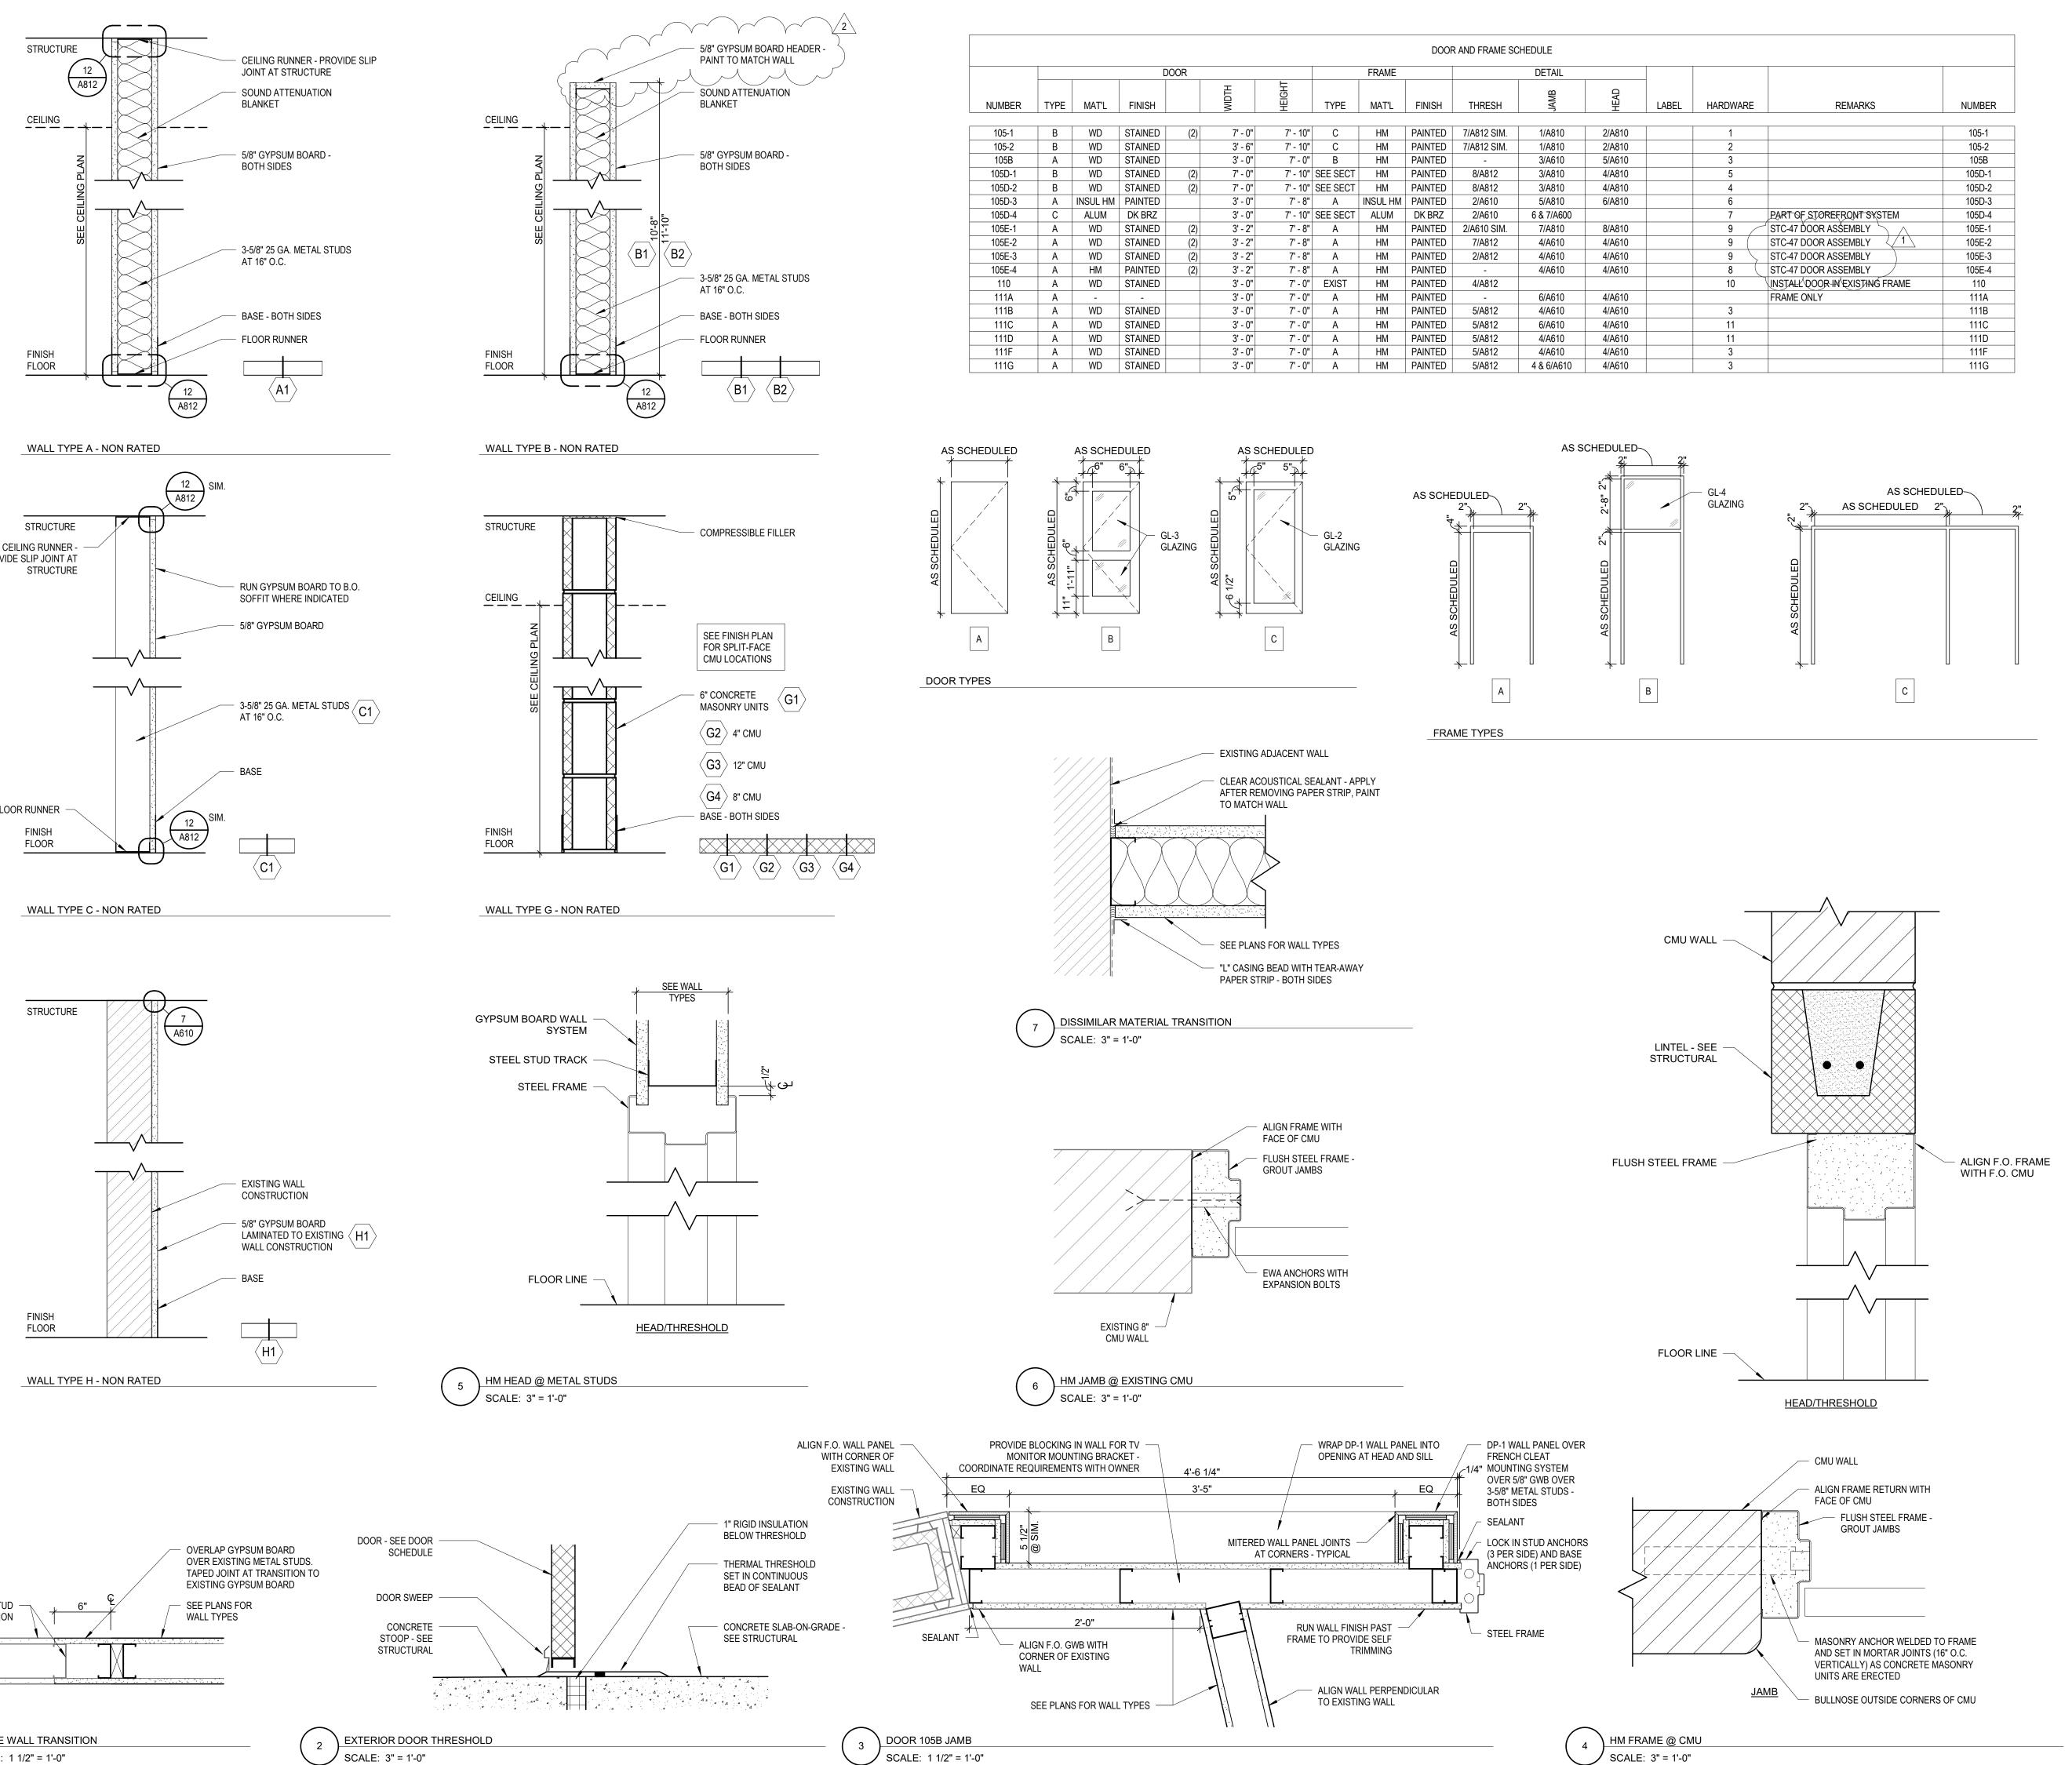

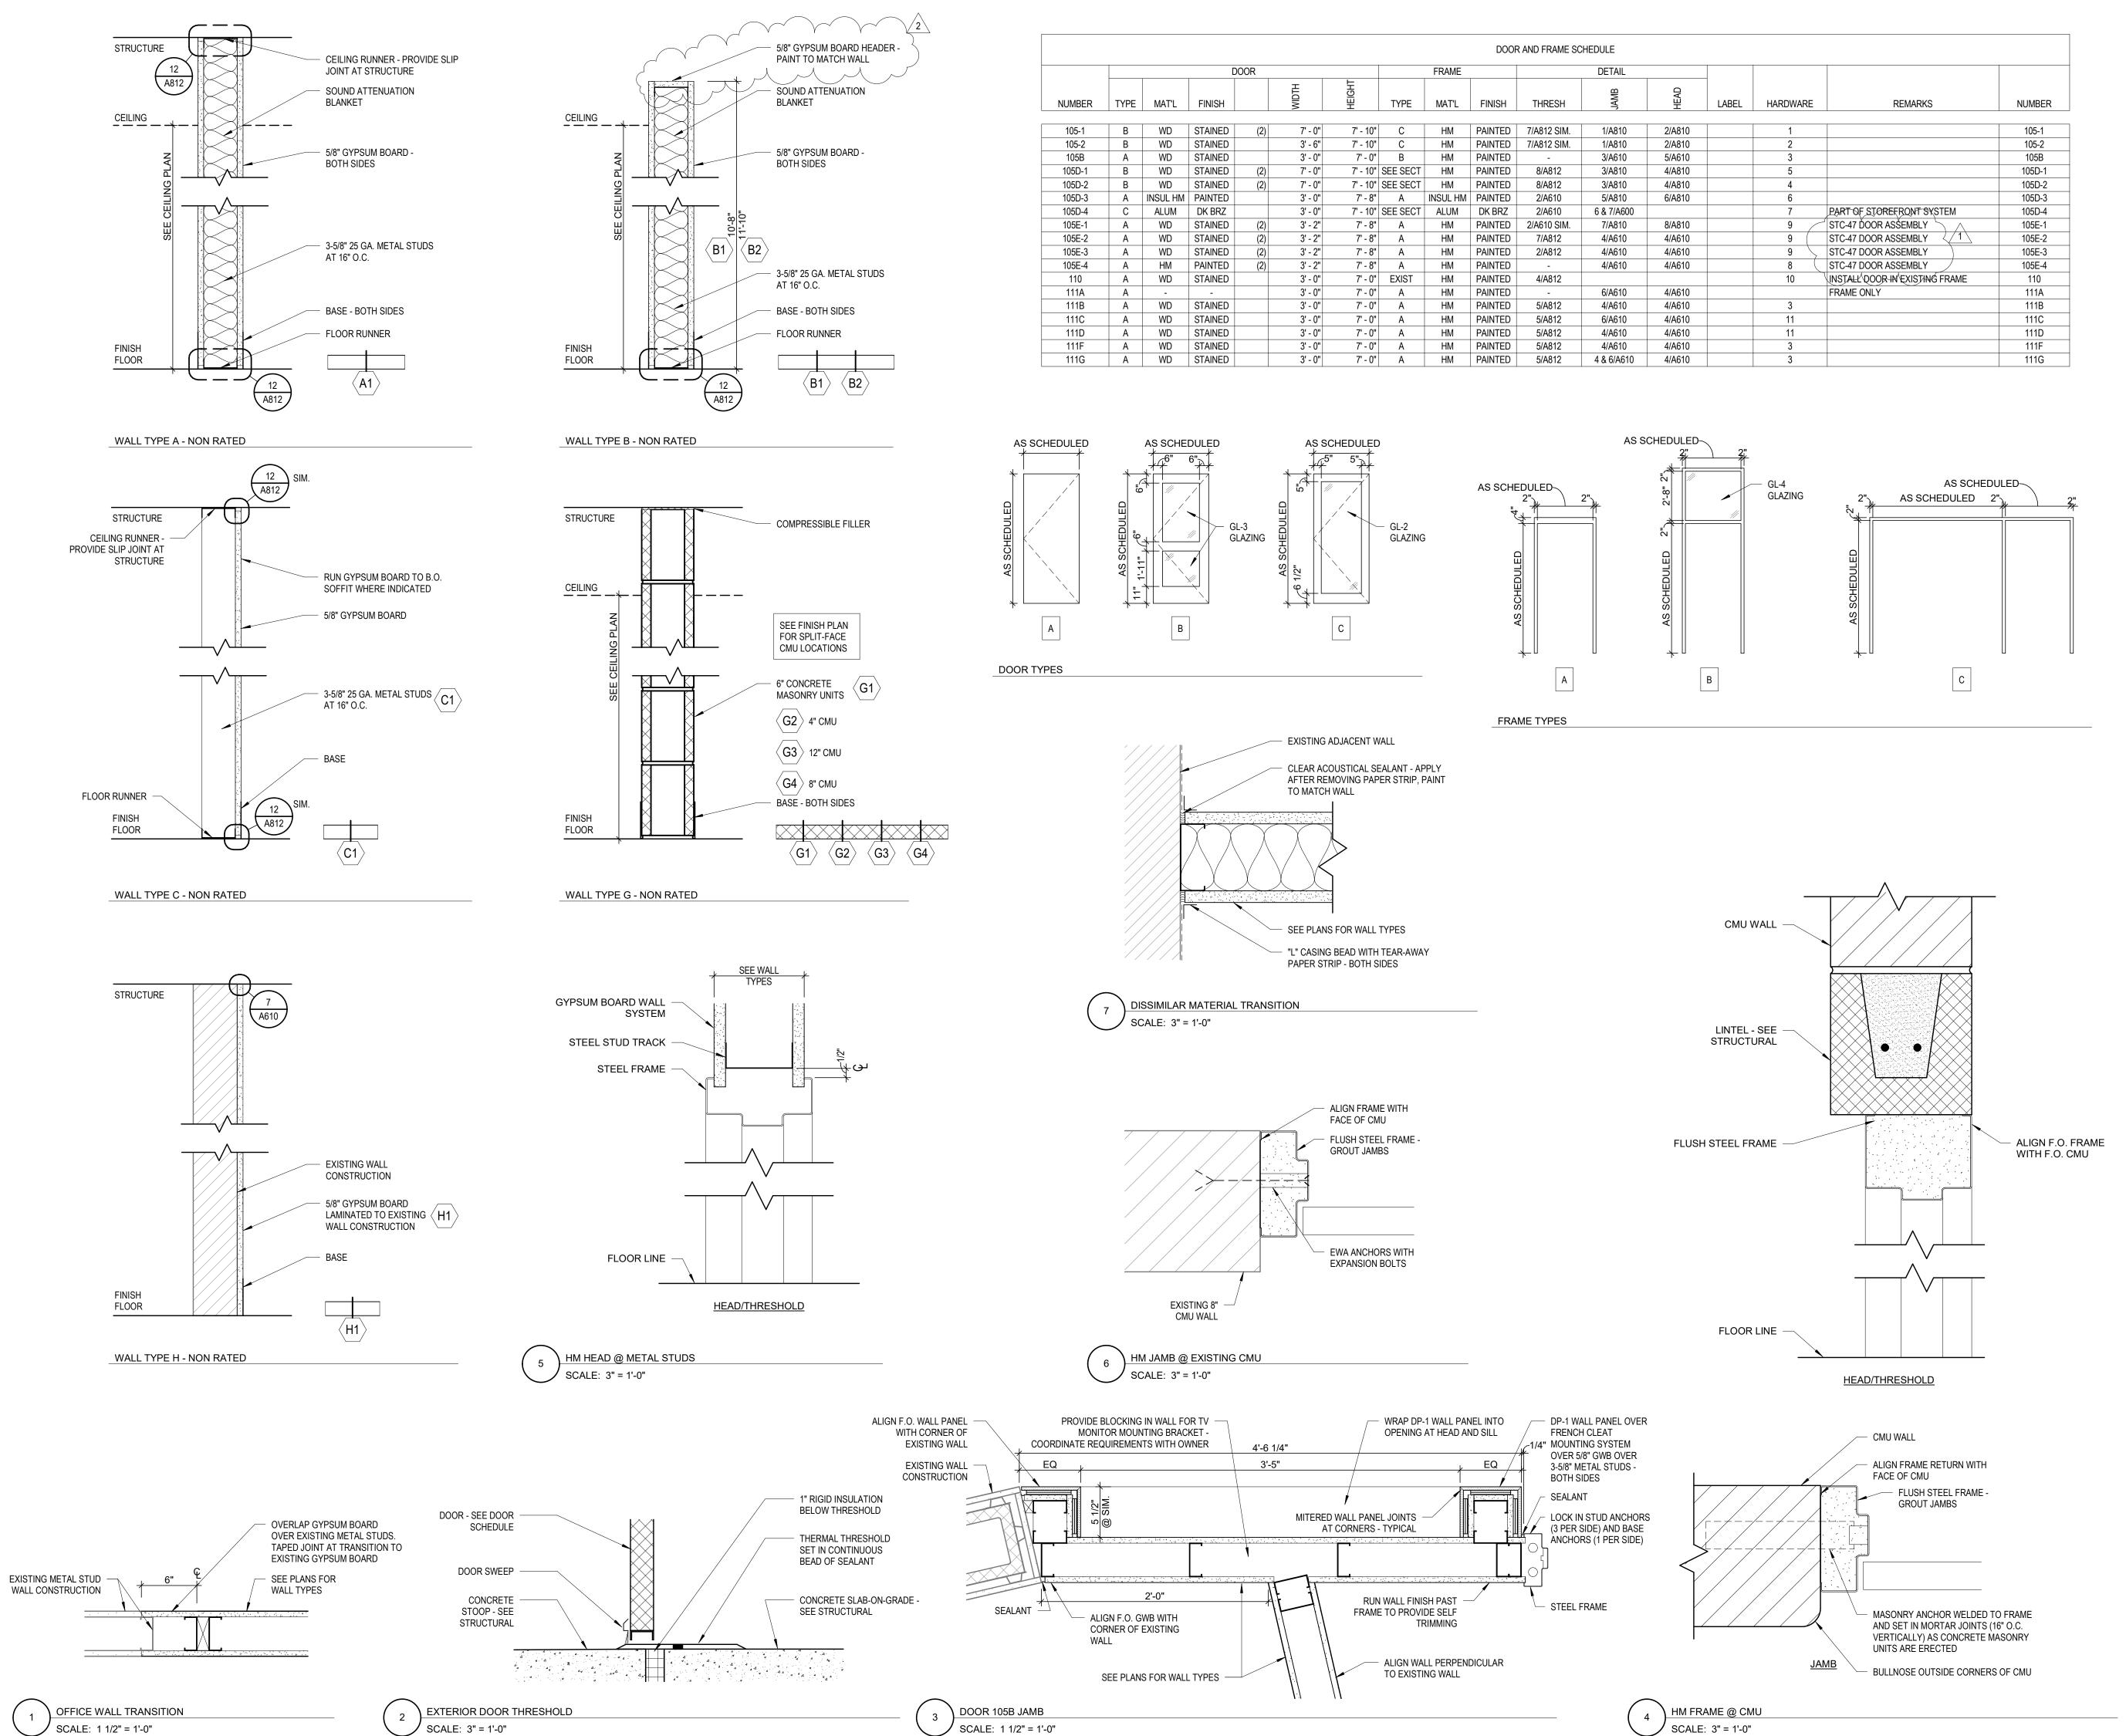

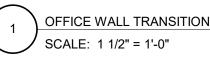



1	-			
HEAD	LABEL	HARDWARE	REMARKS	NUMBER
1			1	
2/A810		1		105-1
2/A810		2		105-2
5/A610		3		105B
4/A810		5		105D-1
4/A810		4		105D-2
6/A810		6		105D-3
		7	PART OF STOREFRONT SYSTEM	105D-4
8/A810		9	STC-47 ĎOOR ASŠEMBLY	105E-1
4/A610		9 (STC-47 DOOR ASSEMBLY	105E-2
4/A610		9 \	STC-47 DOOR ASSEMBLY	105E-3
4/A610		8	STC-47 DOOR ASSEMBLY	105E-4
		10	INSTALL DOOR IN EXISTING FRAME	110
4/A610			FRAME ONLY	111A
4/A610		3		111B
4/A610		11		111C
4/A610		11		111D
4/A610		3		111F
4/A610		3		111G



WARNER PARK COMMUNITY RECREATION CENTER EXPANSION

1625 NORTHPORT DRIVE MADISON, WI 53704 CITY OF MADISON PARKS DIVISION 330 EAST LAKESIDE STREET MADISON, WI 53715

PROJECT NUMBER

223471.00

ISSUED FOR:				
BID SI	ET	5/16/2024		
REVISI	ON FOR:			
NO.	DESCRIPTION	DATE		
1 2	ADDENDUM #2 ADDENDUM #3	6/14/2024 6/18/2024		




DOOR SCHEDULE & WALL TYPES

A610

				I	FINISH SCHEDULE				
		FLOORS	BASE		WALL I	FINISH		CEILING	
			_	NORTH	EAST	SOUTH	WEST		
RM#	ROOM NAME	FINISH	2 FINISH	FINISH	FINISH	FINISH	FINISH	FINISH	REMARKS
102	EXERCISE	RF-1/RF-2	RF-1/RF-2	PT-1/PT-2	PT-7	EX/PT-7	PT-5	OTS/EX	PAINT EXPOSED STRUCTURE AND UTILITIES TO MATCH EXISTING
103	OFFICE	RF-2	RB-1	PT-1	PT-1	PT-1	PT-1	OTS/EX	PAINT EXPOSED STRUCTURE AND UTILITIES TO MATCH EXISTING
105A	CORRIDOR	EX/CPT-3/CPT-4	SEE PLAN	EX/PT-4/DP-1	NA	PT-6/DP-1	NA	PLW/AP-1	
105B	COMFORT	CPT-3	RB-1	PT-1	PT-6	PT-1	PT-1	GWB/PT-10	
105C	PRE-FUNCTION	TZ-1/TZ-2/TZ-3	SEE PLAN	SEE PLAN	SEE PLAN	SEE PLAN	DP-1/PT-2/PT-6	OTS/PT-11	
105D	GYMNASIUM	RSF-1/RSF-2	RB-1	CMU-1	CMU-1	CMU-1	CMU-1	OTS/PT-11	PAINT HEADWALLS ABOVE STOREFRONT TO MATCH METAL DECK
105E	STORAGE	SC-1	RB-1	PT-1	PT-1	PT-1	PT-1	OTS	
105F	MECHANICAL	SC-1	RB-1	PT-1	PT-1	PT-1	PT-1	OTS	
110	STORAGE	CPT-1	2 RB-1	PT-1	PT-1	PT-1	PT-1	GWB/PT-9	
111	CORRIDOR	CPT-1/CPT-2	RB-1	PT-2	PT-1	PT-3	PT-2	GWB/PT-10	
111A	LOCKER ROOM	CPT-1/CPT-2	RB-1	PT-3/PT-1	PT-3/PT-1	PT-1	PT-1/PT-3/CT-4	GWB/PT-9	SEE ELEVATIONS
111B	SHOWER	CT-2	CTB-1	SS-1	SS-1/PT-1	PT-1	SS-1/PT-1	GWB/PT-9	SEE ELEVATIONS
111C	WOMENS	CT-1	CTB-1	CT-3	PT-1	CT-3/CT-4	CT-3	GWB/PT-9	SEE ELEVATIONS
111D	MENS	CT-1	CTB-1	CT-3/CT-4	PT-1	CT-3	CT-3	GWB/PT-9	SEE ELEVATIONS
111F	ADA TOILET	CT-1	CTB-1	PT-1	CT-3/CT-4	CT-3	PT-1	GWB/PT-9	SEE ELEVATIONS
111G	ADA TOILET	CT-1	CTB-1	PT-1	PT-1	CT-3	CT-3/CT-4	GWB/PT-9	SEE ELEVATIONS

GENERAL NOTES - FINISHES

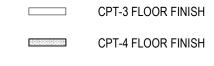


TZ-1 FLOOR FINISH

TZ-2 FLOOR FINISH

- ADJACENT WALL OR CEILING. PATCH AND PAINT EXISTING
- OTHER ITEMS REMOVED.

FINISH TAG	FINISH DESCRIPTION
CMU-1	CMU
CMU-2	CMU
CPT	CARPET TILE
DP	DECORATIVE PANEL
PLW	PLYWOOD
RSF	RESILIENT SPORTS FLOOR
ACT	ACOUSTICAL CEILING TILE
AP	ACOUSTICAL PANEL
CT	CERAMIC TILE
EX	EXISTING
GL	GLASS
GWB	PAINTED GYP BOARD CEILING
MP	METAL PANEL
OTS	OPEN TO STRUCTURE
PLAM	PLASTIC LAMINATE
PT	PAINT
RB	RUBBER BASE / RESILIENT BASE
RF	RESILIENT FLOOR
RWP	RIGID WALL PROTECTION
SC	SEALED CONCRETE
SS	SOLID SURFACE
TZ	TERAZZO
WD	WOOD

GYMNASIUM 105

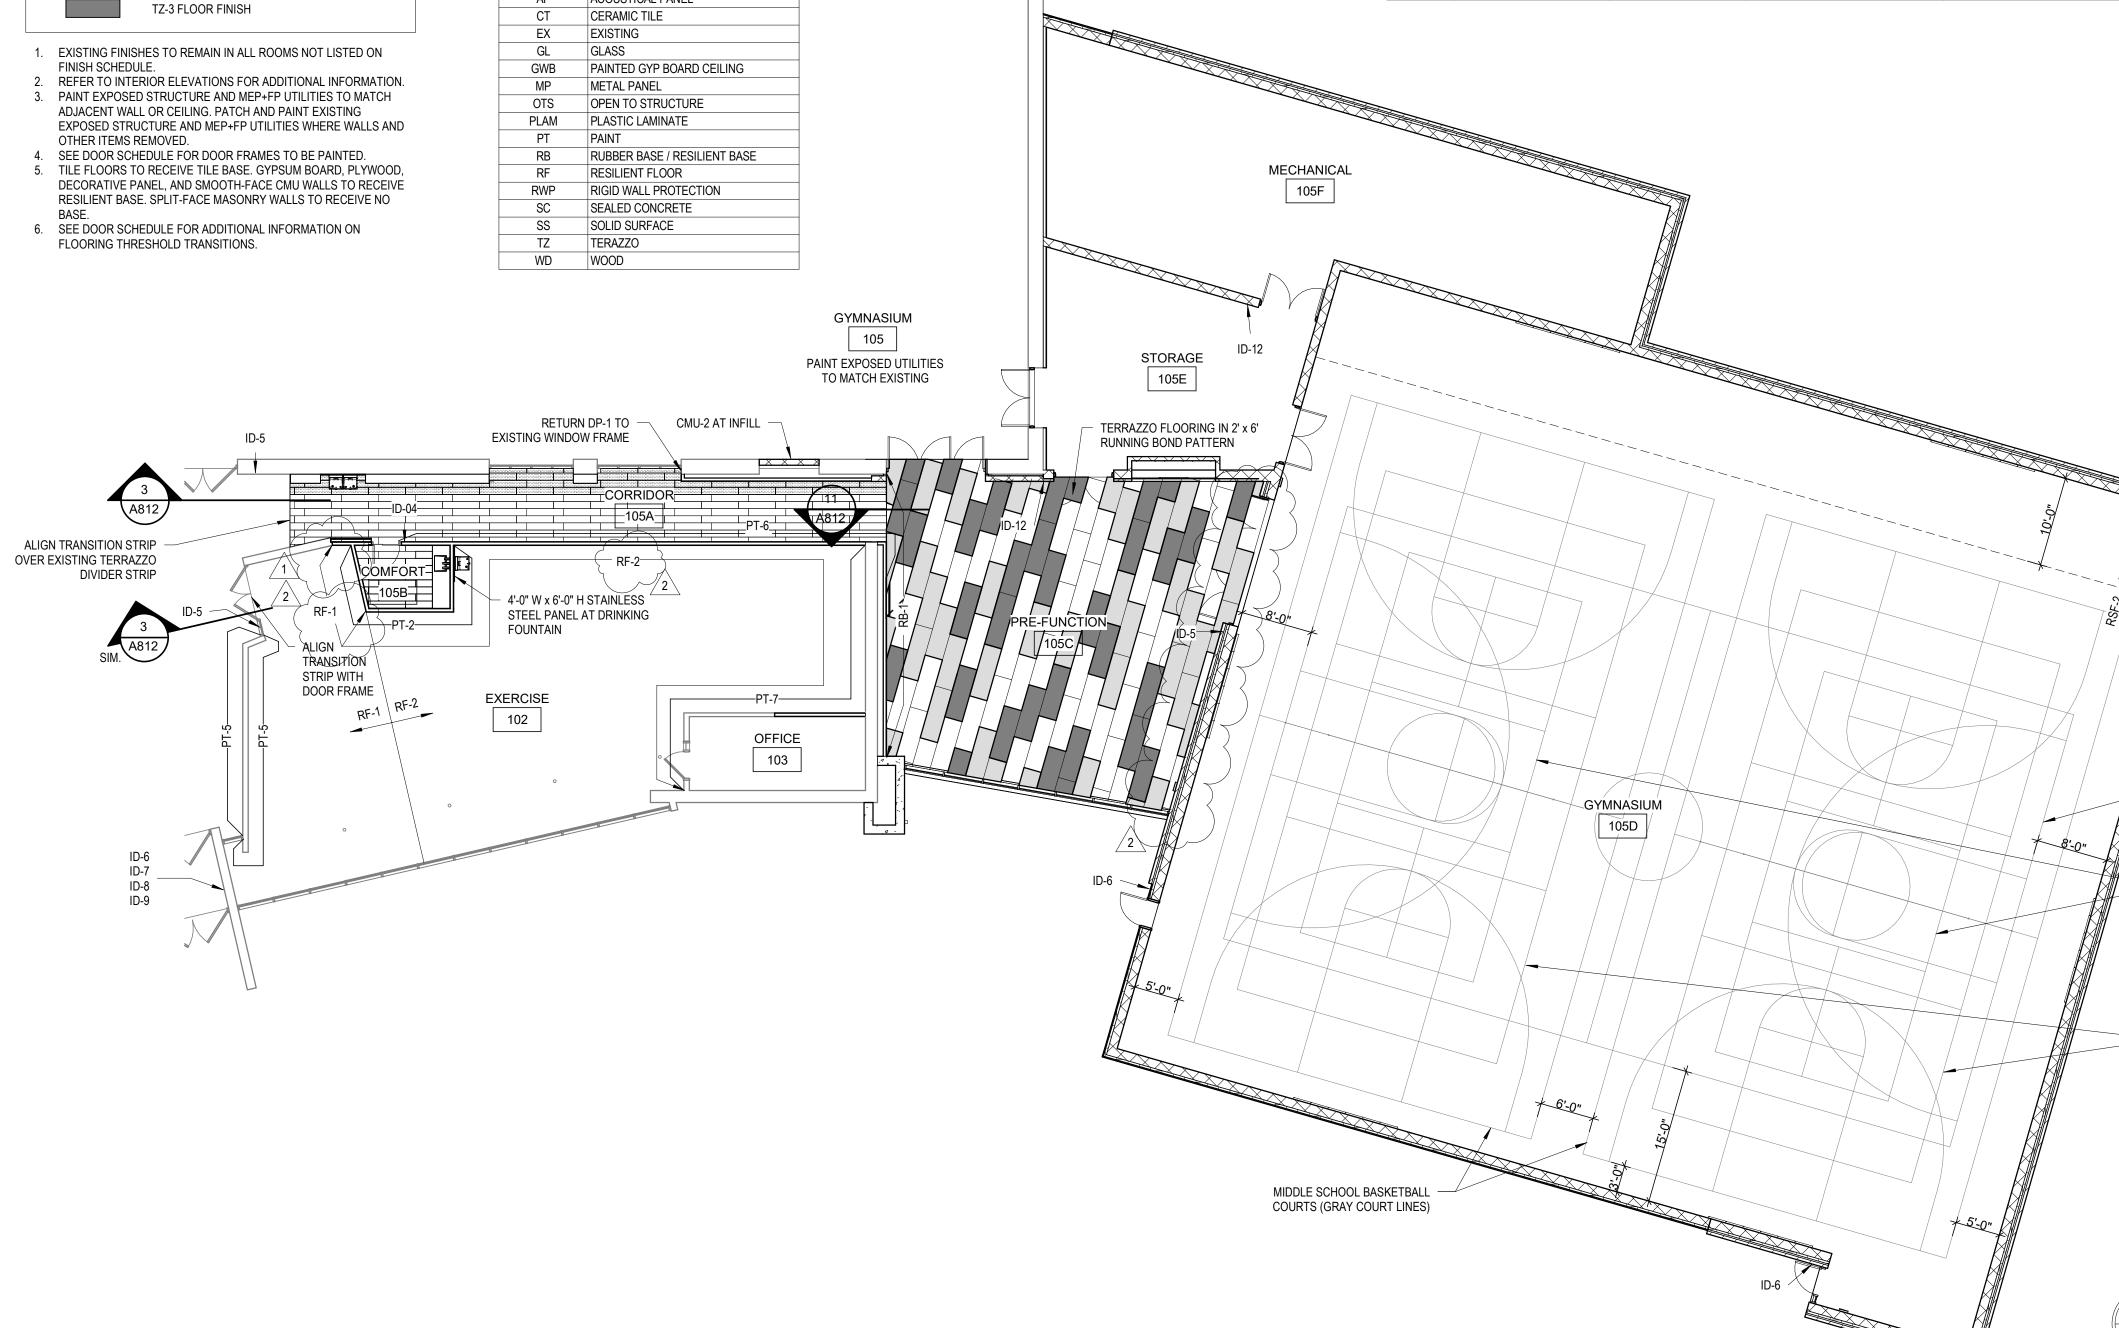

				FINISH KEY
TAG	PRODUCT	MANUFACTURER	COLLECTION/STYLE	COLOR
AP-1	ACOUSTIC PANEL	ARKTURA	VAPOR TRAIL	ARKTURA WHITE
CMU-1	CONCRETE MASONRY LINIT COUNTY MATERIALS SE		SPLITFACE/SMOOTHFACE	SANDSTONE 18-314C
CMU-2	CONCRETE MASONRY UNIT	COUNTY MATERIALS CORP.	PREMIER ULTRA BURNISHED	NORTH STAR 63-222B
CPT-1	CARPET TILE	FORBO	FLOTEX/SEAGRASS	ALMOND 111003
CPT-2	CARPET TILE	FORBO	FLOTEX/SEAGRASS	CHARCOAL 111004
CPT-3	CARPET TILE	FORBO	FLOTEX/SEAGRASS	WALNUT 111005
CPT-4	CARPET TILE	FORBO	FLOTEX/SEAGRASS	LIQUORICE 111006
CT-1	CERAMIC TILE	DALTILE	FABRIC ART/MODERN LINEAR	TAUPE ML62
CT-2	CERAMIC TILE	DALTILE	FABRIC ART/MODERN TEXTILE	TAUPE MT52
CT-3	CERAMIC TILE	DALTILE	FABRIQUE	BLANC LINEN P685
CT-4	CERAMIC TILE	CAESAR CERAMICHE	COCOON/CADENCE TILE	GLEE
CTB-1	CERAMIC TILE BASE	DALTILE	FABRIC ART/MODERN LINEAR	TAUPE ML62
DP-1	DECORATIVE PANEL	ACROVYN	ACROVYN BY DESIGN METALLICS	MEDIUM BRONZE #18172
PT-1	PAINT	BENJAMIN MOORE	WALL PAINT	CLOUD WHITE 967
PT-2	PAINT	BENJAMIN MOORE	ACCENT PAINT	EDGECOMB GRAY HC-173
PT-3	PAINT	SHERWIN WILLIAMS	ACCENT PAINT	REFUGE SW6228
PT-4	PAINT	SHERWIN WILLIAMS	ACCENT PAINT	CURIO GRAY SW0024
PT-5	PAINT	SHERWIN WILLIAMS	ACCENT PAINT	STILL WATER SW6223
PT-6	PAINT	SHERWIN WILLIAMS	ACCENT PAINT	INTERESTING AQUA SW6220
PT-7	PAINT	BENJAMIN MOORE	ACCENT PAINT	GRENADA GREEN 432
PT-8	PAINT	BENJAMIN MOORE	DOOR FRAME PAINT	DEVONSHIRE GREEN 1489
PT-9	PAINT	SHERWIN WILLIAMS	CEILING PAINT	HIGH REFLECTIVE WHITE SW7757
PT-10	PAINT	SHERWIN WILLIAMS	CEILING PAINT	HIGH REFLECTIVE WHITE SW7757
PT-11	PAINT	BENJAMIN MOORE	CEILING PAINT	DUNE WHITE 968
RB-1	RESILIENT BASE	TARKETT	THERMOSET RUBBER	BURNT UMBER 63
RF-1	RESILIENT FLOOR	TARKETT SPORTS	DROPZONE ELITE	DARK GREY DZ502
RF-2	RESILIENT FLOOR	TARKETT SPORTS	DROPZONE ELITE	MED GREY DZ504
RSF-1	RESILIENT SPORTS FLOOR	TARKETT SPORTS	OMNISPORTS HPL7	GOLDEN MAPLE
RSF-2	RESILIENT SPORTS FLOOR	TARKETT SPORTS	OMNISPORTS ACTIVE+	GOLDEN MAPLE
SC-1	SEALED CONCRETE	-	-	-
SS-1	SOLID SURFACE	FORMICA	EVERFORM SOLID SURFACE	FROST 103
SS-2	SOLID SURFACE	FORMICA	EVERFORM SOLID SURFACE	WHITE SPEX 931
TZ-1	TERRAZZO	WISCONSIN TERRAZZO	RESINOUS MIX	WISCONSIN TERRAZZO #3591-E
TZ-2	TERRAZZO	WISCONSIN TERRAZZO	RESINOUS MIX	WISCONSIN TERRAZZO #3590-E
TZ-3	TERRAZZO	WISCONSIN TERRAZZO	RESINOUS MIX	WISCONSIN TERRAZZO #3605-E

FINISH	SIZE	NOTES
MATTE	24" X 48"	
SMOOTH	8" X 16"	
SMOOTH	8" X 16"	
 STANDARD	9.5"X 39.4"	BRICK PATTERN INSTALLATION/50% OF COLOR MIX
STANDARD	9.5"X 39.4"	BRICK PATTERN INSTALLATION/50% OF COLOR MIX
STANDARD	9.5"X 39.4"	BRICK PATTERN INSTALLATION
STANDARD	9.5"X 39.4"	BRICK PATTERN INSTALLATION
MATTE	12" X 24"	
MATTE	1" X 3" MOSAIC	
MATTE	12" X 24"	
MATTE	8" X 48"	
MATTE	6" X 12"	
METALLIC		
SEMI-GLOSS	-	
SEMI-GLOSS	-	
SEMI-GLOSS	-	
EGGSHELL	-	
SEMI-GLOSS	-	
SEMI-GLOSS	-	
FLAT	-	
 SEMI-GLOSS		\frown
SOLID	4" HIGH 2	
STANDARD	48" W ROLL	24" HIGH W/ EDGE TRIM WHERE INSTALLED AS BASE
STANDARD	48" W ROLL	24" HIGH W/ EDGE TRIM WHERE INSTALLED AS BASE
STANDARD	66" W ROLL	CLASS 1 SYSTEM
STANDARD	66" W ROLL	CLASS 3 SYSTEM
-	-	
MATTE	SEE DETAILS	
MATTE	SEE DETAILS	
POLISHED	CUSTOM	
POLISHED	CUSTOM	
POLISHED	CUSTOM	



MILWAUKEE | MADISON | CHICAGO

WARNER PARK COMMUNITY RECREATION CENTER EXPANSION

1625 NORTHPORT DRIVE MADISON, WI 53704

CITY OF MADISON PARKS DIVISION 330 EAST LAKESIDE STREET MADISON, WI 53715

PROJECT NUMBER


223471.00

ISSUED FOR:					
BID SI	ΞT	5/16/2024			
REVISION FOR:					
NO.	DESCRIPTION	DATE			
1	ADDENDUM #2	6/14/2024			
2	ADDENDUM #3	6/18/2024			

DKB DRAWN BY CHECKED BY JWH


FINISH PLANS & SCHEDULE




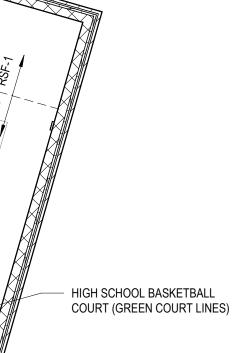


 PICKLEBALL COURT (BLUE COURT LINES) - CENTER WITHIN MIDDLE SCHOOL BASKETBALL COURT. PROVIDE FLOOR SOCKETS FOR COURT NETTING

 VOLLEYBALL COURT (RED COURT LINES) - CENTER WITHIN MIDDLE SCHOOL BASKETBALL COURT. PROVIDE FLOOR SOCKETS FOR COURT NETTING

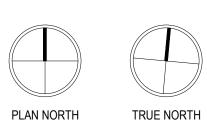

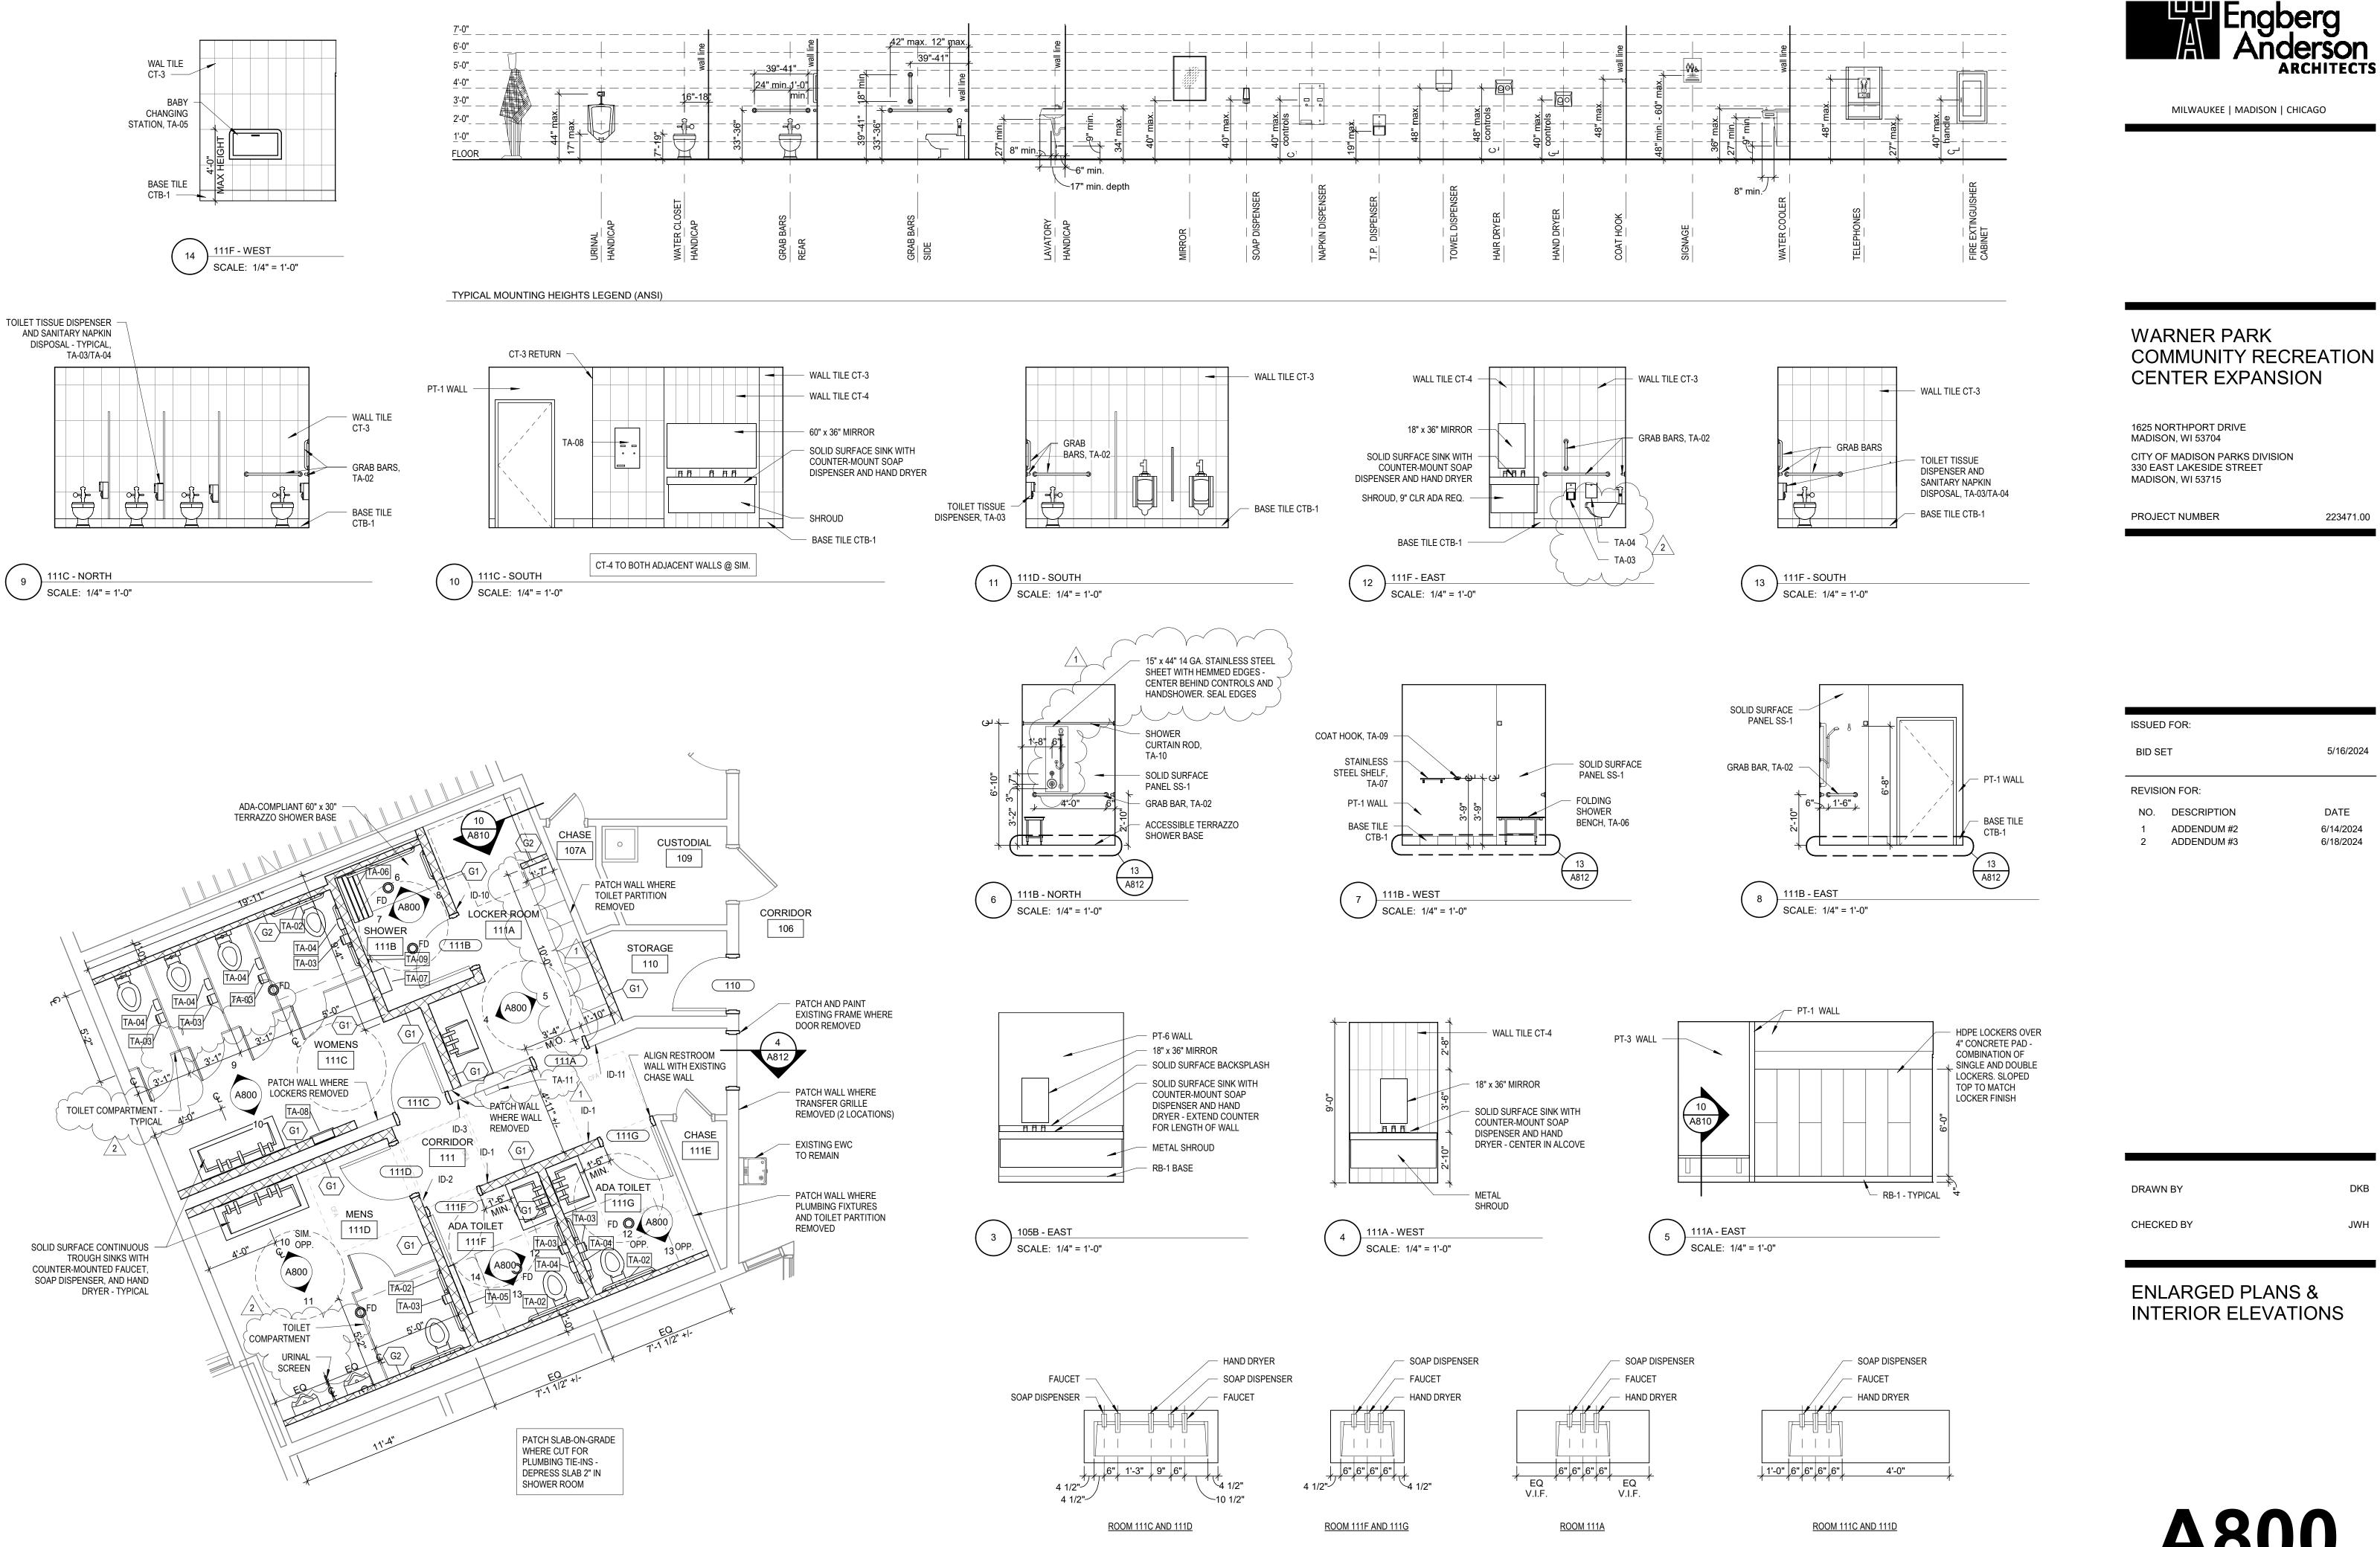

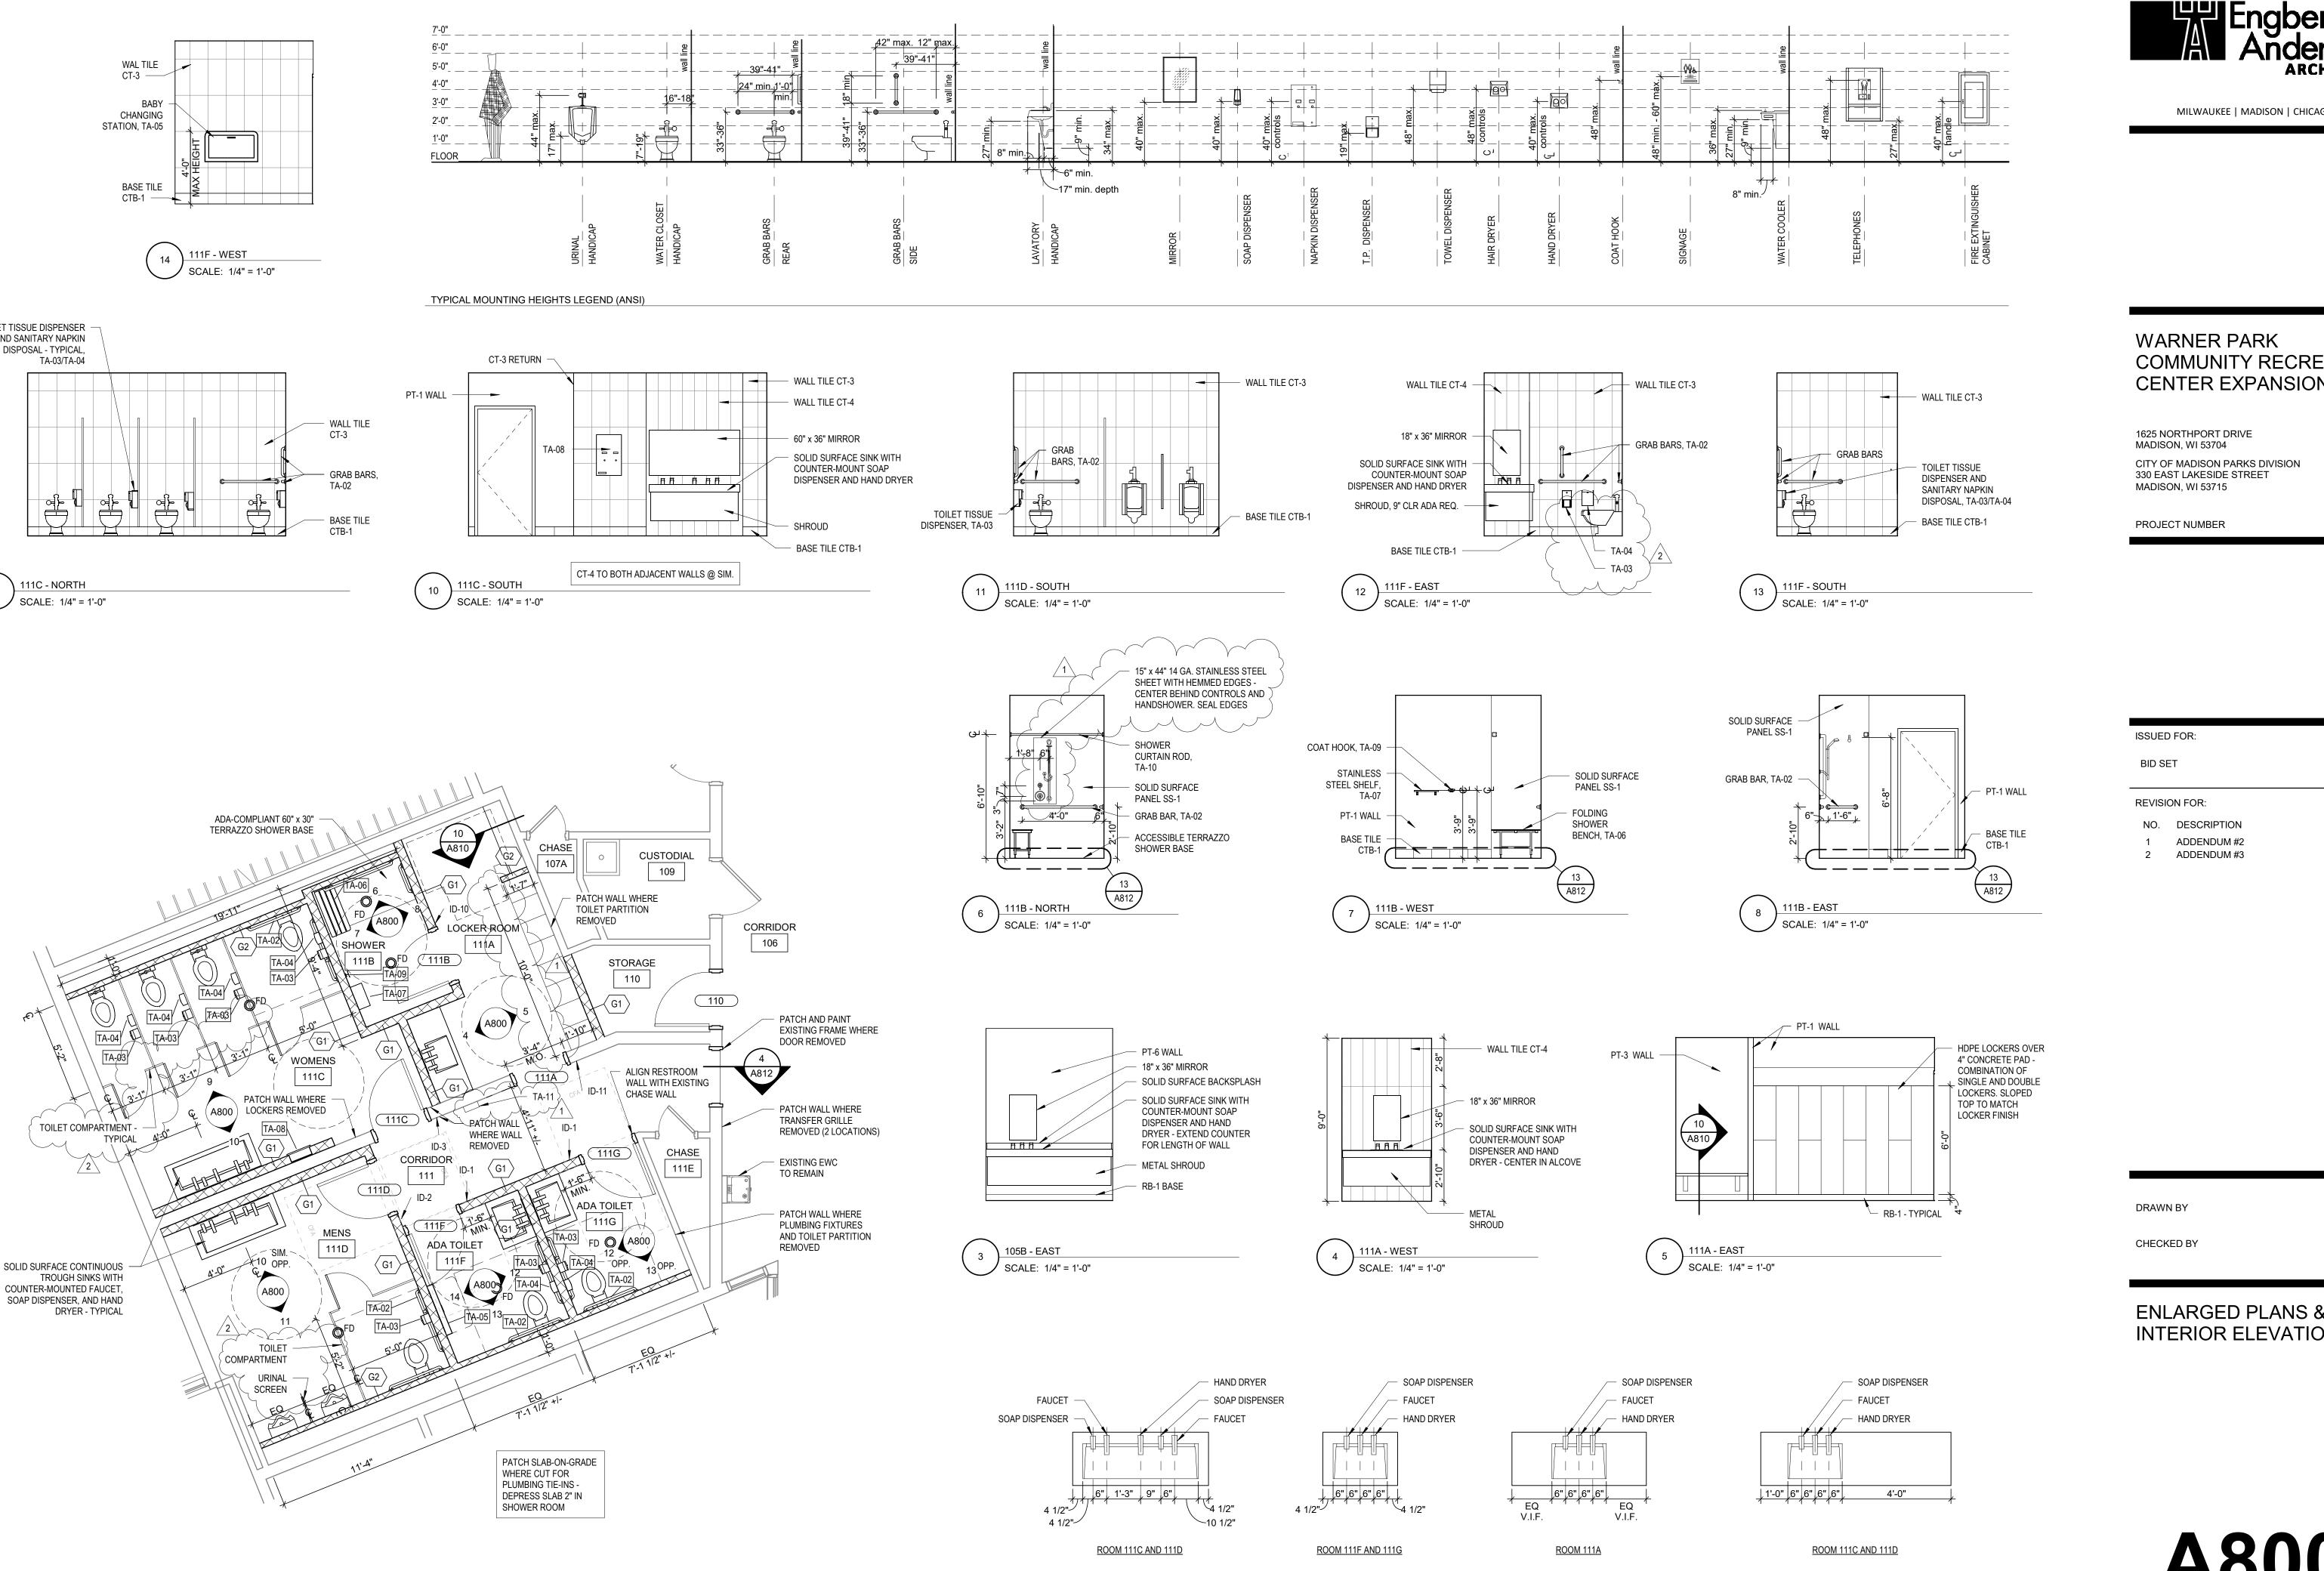

ENLARGED PLAN - RESTROOMS SCALE: 1/4" = 1'-0"



SEE PLUMBING FOR ADDITIONAL INFORMATION

A800


223471.00

5/16/2024

DATE

DKB

JWH

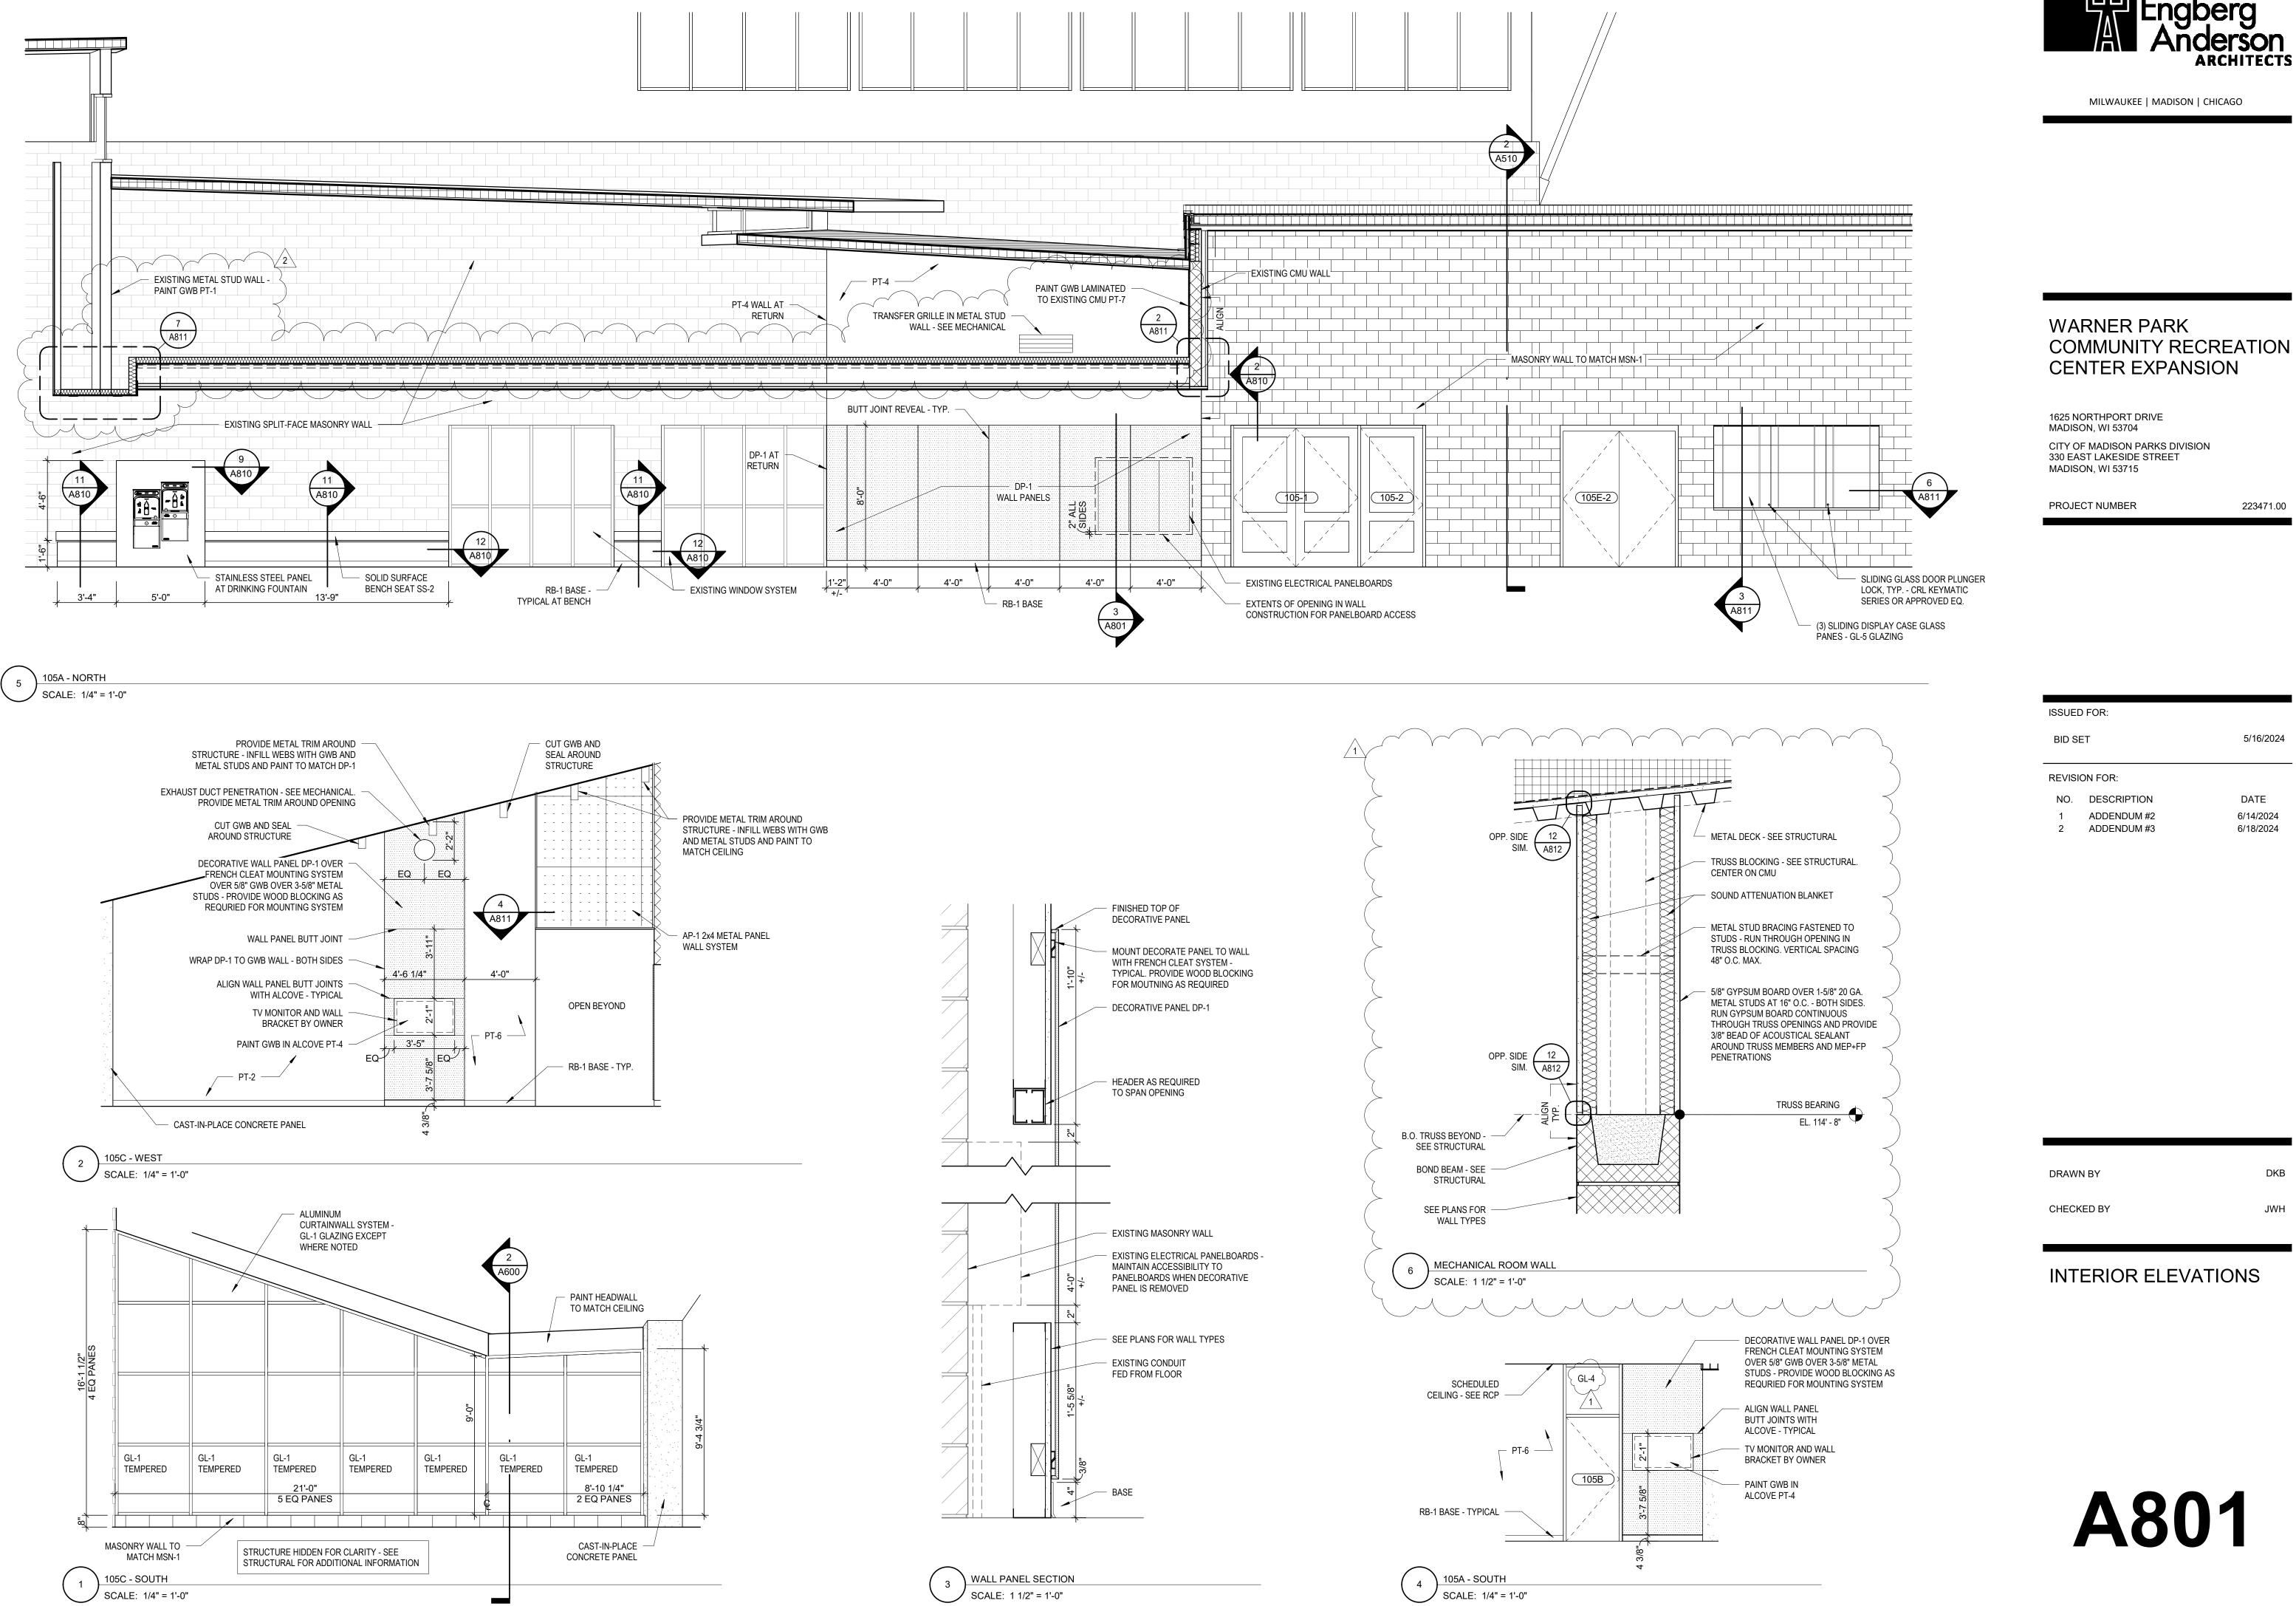


COMMUNITY RECREATION

223471.00

ISSUEI	D FOR:			
BID S	ET	5/16/2024		
REVISION FOR:				
NO.	DESCRIPTION	DATE		
1 2	ADDENDUM #2 ADDENDUM #3	6/14/2024 6/18/2024		

DRAWN BY	DKB
CHECKED BY	JWH

INTERIOR ELEVATIONS

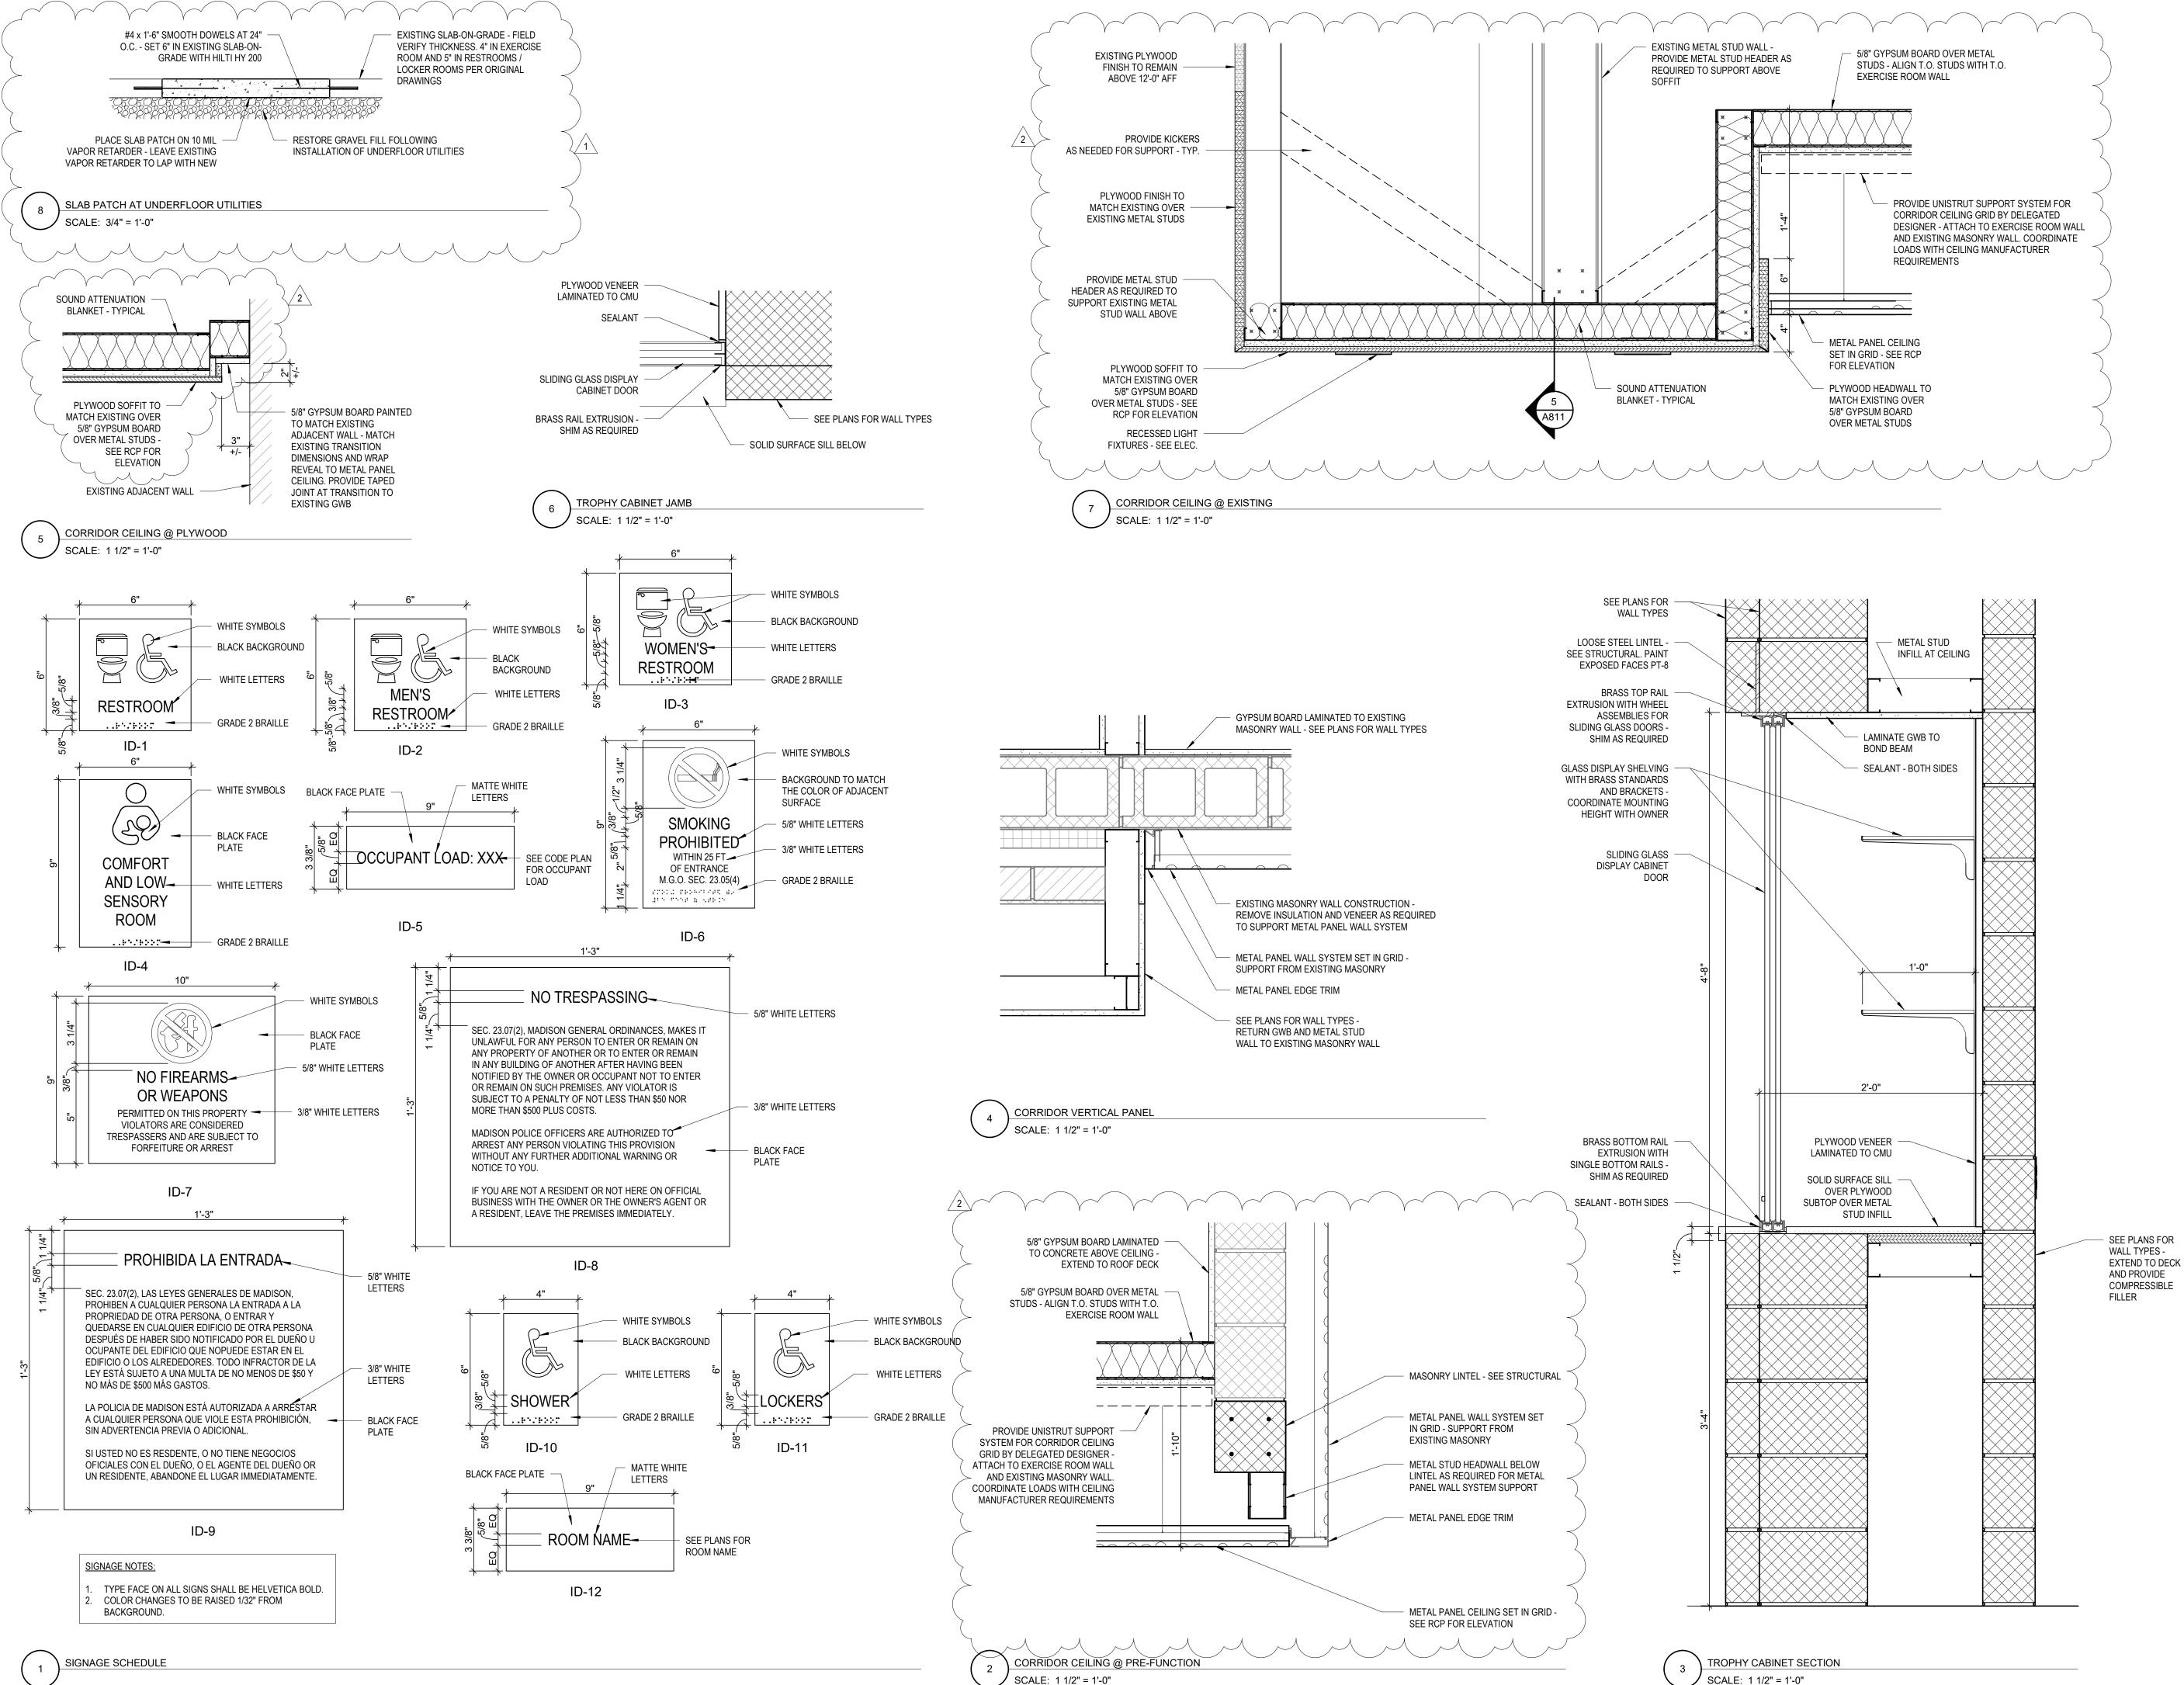

SCALE: 1 1/2" = 1'-0"



MILWAUKEE | MADISON | CHICAGO

WARNER PARK COMMUNITY RECREATION **CENTER EXPANSION**

1625 NORTHPORT DRIVE MADISON, WI 53704 CITY OF MADISON PARKS DIVISION 330 EAST LAKESIDE STREET MADISON, WI 53715

PROJECT NUMBER

223471.00

ISSUED FOR:					
BID S	ET	5/16/2024			
REVISION FOR:					
NO.	DESCRIPTION	DATE			
1 2	ADDENDUM #2 ADDENDUM #3	6/14/2024 6/18/2024			

DRAWN BY	DKB
CHECKED BY	JWH

INTERIOR DETAILS



ABBREVIATION LIST

ABANCHOR BOLT (ROD)AHUAIR HANDLING UNITALTALTERNATEARCHARCHITECTURALBLDGBUILDINGBRGBEARINGBP(##)BASE PLATE CALL-OUTCFCOLD-FORMEDCIPCAST-IN-PLACECJCONTROL JOINTCLCENTER LINECLRCLEAR (DISTANCE)CMUCONCRETE MASONRY UNITCOLCOLUMNCONCCONCRETECONTCONTINUOUSDBADEFORMED BAR ANCHORDEMODEMOLITION / DEMOLISHDIADIAMETERDWGDRAWINGEODEDGE OF DECKEOSEDGE OF SLABEFEACH FACEEJEXPANSION JOINTELEVELEVATIONEQEQUALEWEACH WAYEWEFEACH WAYEWEFEACH WAYEXTGEXISTINGFDFLOOR DRAINFLRFLOORFVFIELD VERIFYF(##)FOOTING CALL-OUTGAGAUGEGALVGALVANIZEDGCGENERAL CONTRACTORGLULAMGLUE-LAMINATED BEAM(S)HKHOOKHORIZHORIZONTALHPHIGH POINTHWSHEADED WELDED STUD(S)IFINSIDE FACE	R
AHUAIR HANDLING UNITALTALTERNATEARCHARCHITECTURALBLDGBUILDINGBRGBEARINGBP(##)BASE PLATE CALL-OUTCFCOLD-FORMEDCIPCAST-IN-PLACECJCONTROL JOINTCLCENTER LINECLRCLEAR (DISTANCE)CMUCONCRETE MASONRY UNITCOLCOLUMNCONCCONCRETECONTCONTINUOUSDBADEFORMED BAR ANCHORDEMODEMOLITION / DEMOLISHDIADIAMETERDWGDRAWINGEODEDGE OF DECKEOSEDGE OF SLABEFEACH FACEEJEXPANSION JOINTELEVELEVATIONEQEQUALEWEACH WAYEWEFEACH WAYEWEFEACH WAYEXTGEXISTINGFDFLOOR DRAINFLRFLOORFVFIELD VERIFYF(##)FOOTING CALL-OUTGAGAUGEGALVGALVANIZEDGCGENERAL CONTRACTORGLULAMGLUE-LAMINATED BEAM(S)HKHOOKHORIZHORIZONTALHPHIGH POINTHWSHEADED WELDED STUD(S)	R
ARCHARCHITECTURALBLDGBUILDINGBRGBEARINGBP(##)BASE PLATE CALL-OUTCFCOLD-FORMEDCIPCAST-IN-PLACECJCONTROL JOINTCLCENTER LINECLRCLEAR (DISTANCE)CMUCONCRETE MASONRY UNITCOLCOLUMNCONCCONCRETECONTCONTINUOUSDBADEFORMED BAR ANCHORDEMODEMOLITION / DEMOLISHDIADIAMETERDWGDRAWINGEODEDGE OF DECKEOSEDGE OF SLABEFEACH FACEEJEXPANSION JOINTELEVELEVATIONEQEQUALEWEACH WAYEWEFEACH WAYEXTGEXISTINGFDFLOOR DRAINFLRFLOORFVFIELD VERIFYF(##)FOOTING CALL-OUTGAGAUGEGALVGALVANIZEDGCGENERAL CONTRACTORGLULAMGLUE-LAMINATED BEAM(S)HKHOOKHORIZHORIZONTALHPHIGH POINTHWSHEADED WELDED STUD(S)	R
BLDGBUILDINGBRGBEARINGBP(##)BASE PLATE CALL-OUTCFCOLD-FORMEDCIPCAST-IN-PLACECJCONTROL JOINTCLCENTER LINECLRCLEAR (DISTANCE)CMUCONCRETE MASONRY UNITCOLCOLUMNCONCCONCRETECONTCONTINUOUSDBADEFORMED BAR ANCHORDEMODEMOLITION / DEMOLISHDIADIAMETERDWGDRAWINGEODEDGE OF DECKEOSEDGE OF SLABEFEACH FACEEJEXPANSION JOINTELEVELEVATIONEQEQUALEWEACH WAYEWEFEACH WAY EACH FACEEXTGEXISTINGFDFLOOR DRAINFLRFLOORFVFIELD VERIFYF(##)FOOTING CALL-OUTGAGAUGEGALVGALVANIZEDGCGENERAL CONTRACTORGLULAMGLUE-LAMINATED BEAM(S)HKHOOKHORIZHORIZONTALHPHIGH POINTHWSHEADED WELDED STUD(S)	R
BRGBEARINGBP(##)BASE PLATE CALL-OUTCFCOLD-FORMEDCIPCAST-IN-PLACECJCONTROL JOINTCLCENTER LINECLRCLEAR (DISTANCE)CMUCONCRETE MASONRY UNITCOLCOLUMNCONCCONCRETECONTCONTINUOUSDBADEFORMED BAR ANCHORDEMODEMOLITION / DEMOLISHDIADIAMETERDWGDRAWINGEODEDGE OF DECKEOSEDGE OF SLABEFEACH FACEEJEXPANSION JOINTELEVELEVATIONEQEQUALEWEACH WAYEWEFEACH WAYEWEFEACH WAYEXTGEXISTINGFDFLOOR DRAINFLRFLOORFVFIELD VERIFYF(##)FOOTING CALL-OUTGAGAUGEGALVGALVANIZEDGCGENERAL CONTRACTORGLULAMGLUE-LAMINATED BEAM(S)HKHOOKHORIZHORIZONTALHPHIGH POINTHWSHEADED WELDED STUD(S)	R
BP(##)BASE PLATE CALL-OUTCFCOLD-FORMEDCIPCAST-IN-PLACECJCONTROL JOINTCLCENTER LINECLRCLEAR (DISTANCE)CMUCONCRETE MASONRY UNITCOLCOLUMNCONCCONCRETECONTCONTINUOUSDBADEFORMED BAR ANCHORDEMODEMOLITION / DEMOLISHDIADIAMETERDWGDRAWINGEODEDGE OF DECKEOSEDGE OF SLABEFEACH FACEEJEXPANSION JOINTELEVELEVATIONEQEQUALEWEACH WAYEWEFEACH WAYEXTEXTERIOREXTGEXISTINGFDFLOOR DRAINFLRFLOORFVFIELD VERIFYF(##)FOOTING CALL-OUTGAGAUGEGALVGALVANIZEDGCGENERAL CONTRACTORGLULAMGLUE-LAMINATED BEAM(S)HKHOOKHORIZHORIZONTALHPHIGH POINTHWSHEADED WELDED STUD(S)	R
CFCOLD-FORMEDCIPCAST-IN-PLACECJCONTROL JOINTCLCENTER LINECLRCLEAR (DISTANCE)CMUCONCRETE MASONRY UNITCOLCOLUMNCONCCONCRETECONTCONTINUOUSDBADEFORMED BAR ANCHORDEMODEMOLITION / DEMOLISHDIADIAMETERDWGDRAWINGEODEDGE OF DECKEOSEDGE OF SLABEFEACH FACEEJEXPANSION JOINTELEVELEVATIONEQEQUALEWEACH WAYEWEFEACH WAYEWEFEACH WAYEXTEXTERIOREXTGEXISTINGFDFLOOR DRAINFLRFLOORFVFIELD VERIFYF(##)FOOTING CALL-OUTGAGAUGEGALVGALVANIZEDGCGENERAL CONTRACTORGLULAMGLUE-LAMINATED BEAM(S)HKHOOKHORIZHORIZONTALHPHIGH POINTHWSHEADED WELDED STUD(S)	R
CIPCAST-IN-PLACECJCONTROL JOINTCLCENTER LINECLRCLEAR (DISTANCE)CMUCONCRETE MASONRY UNITCOLCOLUMNCONCCONCRETECONTCONTINUOUSDBADEFORMED BAR ANCHORDEMODEMOLITION / DEMOLISHDIADIAMETERDWGDRAWINGEODEDGE OF DECKEOSEDGE OF SLABEFEACH FACEEJEXPANSION JOINTELEVELEVATIONEQEQUALEWEACH WAYEWEFEACH WAY EACH FACEEXTGEXISTINGFDFLOOR DRAINFLRFLOORFVFIELD VERIFYF(##)FOOTING CALL-OUTGAGAUGEGALVGALVANIZEDGCGENERAL CONTRACTORGLULAMGLUE-LAMINATED BEAM(S)HKHOOKHORIZHORIZONTALHPHIGH POINTHWSHEADED WELDED STUD(S)	R
CJ CONTROL JOINT CL CENTER LINE CLR CLEAR (DISTANCE) CMU CONCRETE MASONRY UNIT COL COLUMN CONC CONCRETE CONT CONTINUOUS DBA DEFORMED BAR ANCHOR DEMO DEMOLITION / DEMOLISH DIA DIAMETER DWG DRAWING EOD EDGE OF DECK EOS EDGE OF SLAB EF EACH FACE EJ EXPANSION JOINT ELEV ELEVATION EQ EQUAL EW EACH WAY EWEF EACH WAY EACH FACE EXP EXPANSION EXT EXTERIOR EXTG EXISTING FD FLOOR DRAIN FLR FLOOR FV FIELD VERIFY F(##) FOOTING CALL-OUT GA GAUGE GALV GALVANIZED GC GENERAL CONTRACTOR GLULAM GLUE-LAMINATED BEAM(S) HK HOOK HORIZ HORIZONTAL HP HIGH POINT HWS HEADED WELDED STUD(S)	R
CLCENTER LINECLRCLEAR (DISTANCE)CMUCONCRETE MASONRY UNITCOLCOLUMNCONCCONCRETECONTCONTINUOUSDBADEFORMED BAR ANCHORDEMODEMOLITION / DEMOLISHDIADIAMETERDWGDRAWINGEODEDGE OF DECKEOSEDGE OF SLABEFEACH FACEEJEXPANSION JOINTELEVELEVATIONEQEQUALEWEACH WAYEWEFEACH WAY EACH FACEEXPEXTGREXTGEXISTINGFDFLOOR DRAINFLRFLOOR DRAINFLRFLOORFVFIELD VERIFYF(##)FOOTING CALL-OUTGAGAUGEGALVGALVANIZEDGCGENERAL CONTRACTORGLULAMGLUE-LAMINATED BEAM(S)HKHOOKHORIZHORIZONTALHPHIGH POINTHWSHEADED WELDED STUD(S)	R
CLRCLEAR (DISTANCE)CMUCONCRETE MASONRY UNITCOLCOLUMNCONCCONCRETECONTCONTINUOUSDBADEFORMED BAR ANCHORDEMODEMOLITION / DEMOLISHDIADIAMETERDWGDRAWINGEODEDGE OF DECKEOSEDGE OF SLABEFEACH FACEEJEXPANSION JOINTELEVELEVATIONEQEQUALEWEACH WAYEWEFEACH WAY EACH FACEEXPEXTANSIONEXTEXTERIOREXTGEXISTINGFDFLOOR DRAINFLRFLOORFVFIELD VERIFYF(##)FOOTING CALL-OUTGAGAUGEGALVGALVANIZEDGCGENERAL CONTRACTORGLULAMGLUE-LAMINATED BEAM(S)HKHOOKHORIZHORIZONTALHPHIGH POINTHWSHEADED WELDED STUD(S)	R
CMUCONCRÈTE MASONRY UNITCOLCOLUMNCONCCONCRÈTECONTCONTINUOUSDBADEFORMED BAR ANCHORDEMODEMOLITION / DEMOLISHDIADIAMÈTERDWGDRAWINGEODEDGE OF DECKEOSEDGE OF SLABEFEACH FACEEJEXPANSION JOINTELEVELEVATIONEQEQUALEWEACH WAYEWEFEACH WAY EACH FACEEXPEXPANSIONEXTEXTERIOREXTGEXISTINGFDFLOOR DRAINFLRFLOORFVFIELD VERIFYF(##)FOOTING CALL-OUTGAGAUGEGALVGALVANIZEDGCGENERAL CONTRACTORGLULAMGLUE-LAMINATED BEAM(S)HKHOOKHORIZHORIZONTALHPHIGH POINTHWSHEADED WELDED STUD(S)	R
COLCOLUMNCONCCONCRETECONTCONTINUOUSDBADEFORMED BAR ANCHORDEMODEMOLITION / DEMOLISHDIADIAMETERDWGDRAWINGEODEDGE OF DECKEOSEDGE OF SLABEFEACH FACEEJEXPANSION JOINTELEVELEVATIONEQEQUALEWEACH WAYEWEFEACH WAY EACH FACEEXPEXPANSIONEXTEXTERIOREXTGEXISTINGFDFLOOR DRAINFLRFLOORFVFIELD VERIFYF(##)FOOTING CALL-OUTGAGAUGEGALVGALVANIZEDGCGENERAL CONTRACTORGLULAMGLUE-LAMINATED BEAM(S)HKHOOKHORIZHORIZONTALHPHIGH POINTHWSHEADED WELDED STUD(S)	R
CONCCONCRETECONTCONTINUOUSDBADEFORMED BAR ANCHORDEMODEMOLITION / DEMOLISHDIADIAMETERDWGDRAWINGEODEDGE OF DECKEOSEDGE OF SLABEFEACH FACEEJEXPANSION JOINTELEVELEVATIONEQEQUALEWEACH WAYEWEFEACH WAY EACH FACEEXPEXTERIOREXTGEXISTINGFDFLOOR DRAINFLRFLOORFVFIELD VERIFYF(##)FOOTING CALL-OUTGAGAUGEGALVGALVANIZEDGCGENERAL CONTRACTORGLULAMGLUE-LAMINATED BEAM(S)HKHOOKHORIZHORIZONTALHPHIGH POINTHWSHEADED WELDED STUD(S)	
DBADEFORMED BAR ANCHORDEMODEMOLITION / DEMOLISHDIADIAMETERDWGDRAWINGEODEDGE OF DECKEOSEDGE OF SLABEFEACH FACEEJEXPANSION JOINTELEVELEVATIONEQEQUALEWEACH WAYEWEFEACH WAY EACH FACEEXPEXPANSIONEXTEXTERIOREXTGEXISTINGFDFLOOR DRAINFLRFLOORFVFIELD VERIFYF(##)FOOTING CALL-OUTGAGAUGEGALVGALVANIZEDGCGENERAL CONTRACTORGLULAMGLUE-LAMINATED BEAM(S)HKHOOKHORIZHORIZONTALHPHIGH POINTHWSHEADED WELDED STUD(S)	
DEMODEMOLITION / DEMOLISHDIADIAMETERDWGDRAWINGEODEDGE OF DECKEOSEDGE OF SLABEFEACH FACEEJEXPANSION JOINTELEVELEVATIONEQEQUALEWEACH WAYEWEFEACH WAY EACH FACEEXPEXPANSIONEXTEXTERIOREXTGEXISTINGFDFLOOR DRAINFLRFLOORFVFIELD VERIFYF(##)FOOTING CALL-OUTGAGAUGEGALVGALVANIZEDGCGENERAL CONTRACTORGLULAMGLUE-LAMINATED BEAM(S)HKHOOKHORIZHORIZONTALHPHIGH POINTHWSHEADED WELDED STUD(S)	
DIADIAMETERDWGDRAWINGEODEDGE OF DECKEOSEDGE OF SLABEFEACH FACEEJEXPANSION JOINTELEVELEVATIONEQEQUALEWEACH WAYEWEFEACH WAY EACH FACEEXPEXPANSIONEXTEXTERIOREXTGEXISTINGFDFLOOR DRAINFLRFLOORFVFIELD VERIFYF(##)FOOTING CALL-OUTGAGAUGEGALVGALVANIZEDGCGENERAL CONTRACTORGLULAMGLUE-LAMINATED BEAM(S)HKHOOKHORIZHORIZONTALHPHIGH POINTHWSHEADED WELDED STUD(S)	5)
DWGDRAWINGEODEDGE OF DECKEOSEDGE OF SLABEFEACH FACEEJEXPANSION JOINTELEVELEVATIONEQEQUALEWEACH WAYEWEFEACH WAY EACH FACEEXPEXPANSIONEXTEXTERIOREXTGEXISTINGFDFLOOR DRAINFLRFLOORFVFIELD VERIFYF(##)FOOTING CALL-OUTGAGAUGEGALVGALVANIZEDGCGENERAL CONTRACTORGLULAMGLUE-LAMINATED BEAM(S)HKHOOKHORIZHORIZONTALHPHIGH POINTHWSHEADED WELDED STUD(S)	5)
EODEDGE OF DECKEOSEDGE OF SLABEFEACH FACEEJEXPANSION JOINTELEVELEVATIONEQEQUALEWEACH WAYEWEFEACH WAY EACH FACEEXPEXPANSIONEXTEXTERIOREXTGEXISTINGFDFLOOR DRAINFLRFLOORFVFIELD VERIFYF(##)FOOTING CALL-OUTGAGAUGEGALVGALVANIZEDGCGENERAL CONTRACTORGLULAMGLUE-LAMINATED BEAM(S)HKHOOKHORIZHORIZONTALHPHIGH POINTHWSHEADED WELDED STUD(S)	5)
EOSEDGE OF SLABEFEACH FACEEJEXPANSION JOINTELEVELEVATIONEQEQUALEWEACH WAYEWEFEACH WAY EACH FACEEXPEXPANSIONEXTEXTERIOREXTGEXISTINGFDFLOOR DRAINFLRFLOORFVFIELD VERIFYF(##)FOOTING CALL-OUTGAGAUGEGALVGALVANIZEDGCGENERAL CONTRACTORGLULAMGLUE-LAMINATED BEAM(S)HKHOOKHORIZHORIZONTALHPHIGH POINTHWSHEADED WELDED STUD(S)	5)
EFEACH FACEEJEXPANSION JOINTELEVELEVATIONEQEQUALEWEACH WAYEWEFEACH WAY EACH FACEEXPEXPANSIONEXTEXTERIOREXTGEXISTINGFDFLOOR DRAINFLRFLOORFVFIELD VERIFYF(##)FOOTING CALL-OUTGAGAUGEGALVGALVANIZEDGCGENERAL CONTRACTORGLULAMGLUE-LAMINATED BEAM(S)HKHOOKHORIZHORIZONTALHPHIGH POINTHWSHEADED WELDED STUD(S)	5)
EJEXPANSION JOINTELEVELEVATIONEQEQUALEWEACH WAYEWEFEACH WAY EACH FACEEXPEXPANSIONEXTEXTERIOREXTGEXISTINGFDFLOOR DRAINFLRFLOORFVFIELD VERIFYF(##)FOOTING CALL-OUTGAGAUGEGALVGALVANIZEDGCGENERAL CONTRACTORGLULAMGLUE-LAMINATED BEAM(S)HKHOOKHORIZHORIZONTALHPHIGH POINTHWSHEADED WELDED STUD(S)	5)
ELEVELEVATIONEQEQUALEWEACH WAYEWEFEACH WAY EACH FACEEXPEXPANSIONEXTEXTERIOREXTGEXISTINGFDFLOOR DRAINFLRFLOORFVFIELD VERIFYF(##)FOOTING CALL-OUTGAGAUGEGALVGALVANIZEDGCGENERAL CONTRACTORGLULAMGLUE-LAMINATED BEAM(S)HKHOOKHORIZHORIZONTALHPHIGH POINTHWSHEADED WELDED STUD(S)	5)
EQEQUALEWEACH WAYEWEFEACH WAY EACH FACEEXPEXPANSIONEXTEXTERIOREXTGEXISTINGFDFLOOR DRAINFLRFLOORFVFIELD VERIFYF(##)FOOTING CALL-OUTGAGAUGEGALVGALVANIZEDGCGENERAL CONTRACTORGLULAMGLUE-LAMINATED BEAM(S)HKHOOKHORIZHORIZONTALHPHIGH POINTHWSHEADED WELDED STUD(S)	5)
EWEACH WAYEWEFEACH WAY EACH FACEEXPEXPANSIONEXTEXTERIOREXTGEXISTINGFDFLOOR DRAINFLRFLOORFVFIELD VERIFYF(##)FOOTING CALL-OUTGAGAUGEGALVGALVANIZEDGCGENERAL CONTRACTORGLULAMGLUE-LAMINATED BEAM(S)HKHOOKHORIZHORIZONTALHPHIGH POINTHWSHEADED WELDED STUD(S)	5)
EWEFEACH WAY EACH FACEEXPEXPANSIONEXTEXTERIOREXTGEXISTINGFDFLOOR DRAINFLRFLOORFVFIELD VERIFYF(##)FOOTING CALL-OUTGAGAUGEGALVGALVANIZEDGCGENERAL CONTRACTORGLULAMGLUE-LAMINATED BEAM(S)HKHOOKHORIZHORIZONTALHPHIGH POINTHWSHEADED WELDED STUD(S)	5)
EXPEXPANSIONEXTEXTERIOREXTGEXISTINGFDFLOOR DRAINFLRFLOORFVFIELD VERIFYF(##)FOOTING CALL-OUTGAGAUGEGALVGALVANIZEDGCGENERAL CONTRACTORGLULAMGLUE-LAMINATED BEAM(S)HKHOOKHORIZHORIZONTALHPHIGH POINTHWSHEADED WELDED STUD(S)	5)
EXTGEXISTINGFDFLOOR DRAINFLRFLOORFVFIELD VERIFYF(##)FOOTING CALL-OUTGAGAUGEGALVGALVANIZEDGCGENERAL CONTRACTORGLULAMGLUE-LAMINATED BEAM(S)HKHOOKHORIZHORIZONTALHPHIGH POINTHWSHEADED WELDED STUD(S)	5)
FDFLOOR DRAINFLRFLOORFVFIELD VERIFYF(##)FOOTING CALL-OUTGAGAUGEGALVGALVANIZEDGCGENERAL CONTRACTORGLULAMGLUE-LAMINATED BEAM(S)HKHOOKHORIZHORIZONTALHPHIGH POINTHWSHEADED WELDED STUD(S)	S)
GLULAMGLUE-LAMINATED BEAM(S)HKHOOKHORIZHORIZONTALHPHIGH POINTHWSHEADED WELDED STUD(S)	S)
HK HOOK HORIZ HORIZONTAL HP HIGH POINT HWS HEADED WELDED STUD(S)	,
HP HIGH POINT HWS HEADED WELDED STUD(S)	
HWS HEADED WELDED STUD(S)	
	3)
INT INTERIOR JBE JOIST BEARING ELEVATION	N
LLH LONG LEG HORIZONTAL	
LLV LONG LEG VERTICAL	
LSL LAMINATED STRAND LUMBE	BER
LTWT LIGHTWEIGHT	
LVL LAMINATED VENEER LUMBE	BER
LW LONG WAY	
MAX MAXIMUM	
MECH MECHANICAL	
MFR MANUFACTURER	
MIN MINIMUM MISC MISCELLANEOUS	
MISC MISCELLANEOUS NA NOT APPLICABLE	
NTS NOT TO SCALE	
OC ON CENTER	
OF OUTSIDE FACE	
OPNG OPENING	
OPNG OPENING OPP OPPOSITE	
OPNG OPENING OPP OPPOSITE PC PRECAST / PRESTRESSED	
OPNGOPENINGOPPOPPOSITEPCPRECAST / PRESTRESSEDPCIPOUNDS PER CUBIC INCH	ł
OPNGOPENINGOPPOPPOSITEPCPRECAST / PRESTRESSEDPCIPOUNDS PER CUBIC INCHPDFPOUNDS PER CUBIC FOOT	ł
OPNGOPENINGOPPOPPOSITEPCPRECAST / PRESTRESSEDPCIPOUNDS PER CUBIC INCHPDFPOUNDS PER CUBIC FOOTPLPLATE	ł T
OPNGOPENINGOPPOPPOSITEPCPRECAST / PRESTRESSEDPCIPOUNDS PER CUBIC INCHPDFPOUNDS PER CUBIC FOOTPLPLATEPLFPOUNDS PER LINEAR FOOT	ł T
OPNGOPENINGOPPOPPOSITEPCPRECAST / PRESTRESSEDPCIPOUNDS PER CUBIC INCHPDFPOUNDS PER CUBIC FOOTPLPLATEPLFPOUNDS PER LINEAR FOOTPROJPROJECTION	H T DT
OPNGOPENINGOPPOPPOSITEPCPRECAST / PRESTRESSEDPCIPOUNDS PER CUBIC INCHPDFPOUNDS PER CUBIC FOOTPLPLATEPLFPOUNDS PER LINEAR FOOTPROJPROJECTIONPSFPOUNDS PER CUBIC FOOT	H T DT T
OPNGOPENINGOPPOPPOSITEPCPRECAST / PRESTRESSEDPCIPOUNDS PER CUBIC INCHPDFPOUNDS PER CUBIC FOOTPLPLATEPLFPOUNDS PER LINEAR FOOTPROJPROJECTIONPSFPOUNDS PER CUBIC FOOTPSIPOUNDS PER SQUARE INCH	H T DT T
OPNGOPENINGOPPOPPOSITEPCPRECAST / PRESTRESSEDPCIPOUNDS PER CUBIC INCHPDFPOUNDS PER CUBIC FOOTPLPLATEPLFPOUNDS PER LINEAR FOOTPROJPROJECTIONPSFPOUNDS PER CUBIC FOOTPSIPOUNDS PER SQUARE INCHPTPRE (POST) -TENSIONED	H T DT T
OPNGOPENINGOPPOPPOSITEPCPRECAST / PRESTRESSEDPCIPOUNDS PER CUBIC INCHPDFPOUNDS PER CUBIC FOOTPLPLATEPLFPOUNDS PER LINEAR FOOTPROJPROJECTIONPSFPOUNDS PER CUBIC FOOTPSIPOUNDS PER SQUARE INCHPTPRE (POST) -TENSIONEDP(#)PIER CALL-OUTRDROOF DRAIN	H T DT T
OPNGOPENINGOPPOPPOSITEPCPRECAST / PRESTRESSEDPCIPOUNDS PER CUBIC INCHPDFPOUNDS PER CUBIC FOOTPLPLATEPLFPOUNDS PER LINEAR FOOTPROJPROJECTIONPSFPOUNDS PER CUBIC FOOTPSIPOUNDS PER SQUARE INCHPTPRE (POST) -TENSIONEDP(#)PIER CALL-OUTRDROOF DRAINREINFREINFORC(ED)(ING)	H T DT T
OPNGOPENINGOPPOPPOSITEPCPRECAST / PRESTRESSEDPCIPOUNDS PER CUBIC INCHPDFPOUNDS PER CUBIC FOOTPLPLATEPLFPOUNDS PER LINEAR FOOTPROJPROJECTIONPSFPOUNDS PER SQUARE INCHPTPRE (POST) -TENSIONEDP(#)PIER CALL-OUTRDROOF DRAINREINFREINFORC(ED)(ING)RTUROOF TOP UNIT	H T DT T
OPNGOPENINGOPPOPPOSITEPCPRECAST / PRESTRESSEDPCIPOUNDS PER CUBIC INCHPDFPOUNDS PER CUBIC FOOTPLPLATEPLFPOUNDS PER LINEAR FOOTPROJPROJECTIONPSFPOUNDS PER SQUARE INCHPTPRE (POST) -TENSIONEDP(#)PIER CALL-OUTRDROOF DRAINREINFREINFORC(ED)(ING)RTUROOF TOP UNITSIMSIMILAR	H T DT T
OPNGOPENINGOPPOPPOSITEPCPRECAST / PRESTRESSEDPCIPOUNDS PER CUBIC INCHPDFPOUNDS PER CUBIC FOOTPLPLATEPLFPOUNDS PER LINEAR FOOTPSFPOUNDS PER CUBIC FOOTPSIPOUNDS PER SQUARE INCHPTPRE (POST) -TENSIONEDP(#)PIER CALL-OUTRDROOF DRAINREINFREINFORC(ED)(ING)RTUROOF TOP UNITSIMSIMILARSOGSLAB-ON-GRADE	H T DT T
OPNGOPENINGOPPOPPOSITEPCPRECAST / PRESTRESSEDPCIPOUNDS PER CUBIC INCHPDFPOUNDS PER CUBIC FOOTPLPLATEPLFPOUNDS PER LINEAR FOOTPSFPOUNDS PER CUBIC FOOTPSIPOUNDS PER SQUARE INCHPTPRE (POST) -TENSIONEDP(#)PIER CALL-OUTRDROOF DRAINREINFREINFORC(ED)(ING)RTUROOF TOP UNITSIMSIMILARSOGSLAB-ON-GRADESPASPAC(ES)(ED)(ING)	H T DT T
OPNGOPENINGOPPOPPOSITEPCPRECAST / PRESTRESSEDPCIPOUNDS PER CUBIC INCHPDFPOUNDS PER CUBIC FOOTPLPLATEPLFPOUNDS PER LINEAR FOOTPROJPROJECTIONPSFPOUNDS PER SQUARE INCHPTPRE (POST) -TENSIONEDP(#)PIER CALL-OUTRDROOF DRAINREINFREINFORC(ED)(ING)RTUROOF TOP UNITSIMSIMILARSOGSLAB-ON-GRADESPASPAC(ES)(ED)(ING)SPECSPECIFICATION(S)	H T DT T
OPNGOPENINGOPPOPPOSITEPCPRECAST / PRESTRESSEDPCIPOUNDS PER CUBIC INCHPDFPOUNDS PER CUBIC FOOTPLPLATEPLFPOUNDS PER LINEAR FOOTPSFPOUNDS PER CUBIC FOOTPSIPOUNDS PER SQUARE INCHPTPRE (POST) -TENSIONEDP(#)PIER CALL-OUTRDROOF DRAINREINFREINFORC(ED)(ING)RTUROOF TOP UNITSIMSIMILARSOGSLAB-ON-GRADESPASPAC(ES)(ED)(ING)SPECSPECIFICATION(S)SQSQUARE	H T DT T
OPNGOPENINGOPPOPPOSITEPCPRECAST / PRESTRESSEDPCIPOUNDS PER CUBIC INCHPDFPOUNDS PER CUBIC FOOTPLPLATEPLFPOUNDS PER LINEAR FOOTPROJPROJECTIONPSFPOUNDS PER SQUARE INCHPTPRE (POST) -TENSIONEDP(#)PIER CALL-OUTRDROOF DRAINREINFREINFORC(ED)(ING)RTUROOF TOP UNITSIMSIMILARSOGSLAB-ON-GRADESPASPAC(ES)(ED)(ING)SPECSPECIFICATION(S)	H T DT T
OPNGOPENINGOPPOPPOSITEPCPRECAST / PRESTRESSEDPCIPOUNDS PER CUBIC INCHPDFPOUNDS PER CUBIC FOOTPLPLATEPLFPOUNDS PER LINEAR FOOTPROJPROJECTIONPSFPOUNDS PER SQUARE INCHPTPRE (POST) -TENSIONEDP(#)PIER CALL-OUTRDROOF DRAINREINFREINFORC(ED)(ING)RTUROOF TOP UNITSIMSIMILARSOGSLAB-ON-GRADESPASPAC(ES)(ED)(ING)SPECSPECIFICATION(S)SQSQUARESSSTAINLESS STEELSWSHORT WAYTLTOP OF LEDGE	H T DT T
OPNGOPENINGOPPOPPOSITEPCPRECAST / PRESTRESSEDPCIPOUNDS PER CUBIC INCHPDFPOUNDS PER CUBIC FOOTPLPLATEPLFPOUNDS PER LINEAR FOOTPROJPROJECTIONPSFPOUNDS PER CUBIC FOOTPSIPOUNDS PER SQUARE INCHPTPRE (POST) -TENSIONEDP(#)PIER CALL-OUTRDROOF DRAINREINFREINFORC(ED)(ING)RTUROOF TOP UNITSIMSIMILARSOGSLAB-ON-GRADESPASPAC(ES)(ED)(ING)SPECSPECIFICATION(S)SQSQUARESSSTAINLESS STEELSWSHORT WAYTLTOP OF LEDGETPTOP OF PIER	H T DT T
OPNGOPENINGOPPOPPOSITEPCPRECAST / PRESTRESSEDPCIPOUNDS PER CUBIC INCHPDFPOUNDS PER CUBIC FOOTPLPLATEPLFPOUNDS PER LINEAR FOOTPROJPROJECTIONPSFPOUNDS PER CUBIC FOOTPSIPOUNDS PER SQUARE INCHPTPRE (POST) -TENSIONEDP(#)PIER CALL-OUTRDROOF DRAINREINFREINFORC(ED)(ING)RTUROOF TOP UNITSIMSIMILARSOGSLAB-ON-GRADESPASPAC(ES)(ED)(ING)SPECSPECIFICATION(S)SQSQUARESSSTAINLESS STEELSWSHORT WAYTLTOP OF LEDGETPTOP OF PIERTWTOP OF WALL	H T DT T
OPNGOPENINGOPPOPPOSITEPCPRECAST / PRESTRESSEDPCIPOUNDS PER CUBIC INCHPDFPOUNDS PER CUBIC FOOTPLPLATEPLFPOUNDS PER LINEAR FOOTPROJPROJECTIONPSFPOUNDS PER CUBIC FOOTPSIPOUNDS PER SQUARE INCHPTPRE (POST) -TENSIONEDP(#)PIER CALL-OUTRDROOF DRAINREINFREINFORC(ED)(ING)RTUROOF TOP UNITSIMSIMILARSOGSLAB-ON-GRADESPASPAC(ES)(ED)(ING)SPECSPECIFICATION(S)SQSQUARESWSHORT WAYTLTOP OF LEDGETPTOP OF PIERTWTOP OF WALLTYPTYPICAL	н Т ОТ СН
OPNGOPENINGOPPOPPOSITEPCPRECAST / PRESTRESSEDPCIPOUNDS PER CUBIC INCHPDFPOUNDS PER CUBIC FOOTPLPLATEPLFPOUNDS PER LINEAR FOOTPROJPROJECTIONPSFPOUNDS PER SQUARE INCHPTPRE (POST) -TENSIONEDP(#)PIER CALL-OUTRDROOF DRAINREINFREINFORC(ED)(ING)RTUROOF TOP UNITSIMSIMILARSOGSLAB-ON-GRADESPASPAC(ES)(ED)(ING)SPECSPECIFICATION(S)SQSQUARESSSTAINLESS STEELSWSHORT WAYTLTOP OF PIERTWTOP OF WALLTYPTYPICALUNOUNLESS NOTED OTHERWISI	н Т ОТ СН
OPNGOPENINGOPPOPPOSITEPCPRECAST / PRESTRESSEDPCIPOUNDS PER CUBIC INCHPDFPOUNDS PER CUBIC FOOTPLPLATEPLFPOUNDS PER LINEAR FOOTPROJPROJECTIONPSFPOUNDS PER SQUARE INCHPTPRE (POST) -TENSIONEDP(#)PIER CALL-OUTRDROOF DRAINREINFREINFORC(ED)(ING)RTUROOF TOP UNITSIMSIMILARSOGSLAB-ON-GRADESPASPAC(ES)(ED)(ING)SPECSPECIFICATION(S)SQSQUARESSSTAINLESS STEELSWSHORT WAYTLTOP OF PIERTWTOP OF WALLTYPTYPICALUNOUNLESS NOTED OTHERWISHVERTVERTICAL	н Т ОТ СН
OPNGOPENINGOPPOPPOSITEPCPRECAST / PRESTRESSEDPCIPOUNDS PER CUBIC INCHPDFPOUNDS PER CUBIC FOOTPLPLATEPLFPOUNDS PER LINEAR FOOTPROJPROJECTIONPSFPOUNDS PER SQUARE INCHPTPRE (POST) -TENSIONEDP(#)PIER CALL-OUTRDROOF DRAINREINFREINFORC(ED)(ING)RTUROOF TOP UNITSIMSIMILARSOGSLAB-ON-GRADESPASPAC(ES)(ED)(ING)SPECSPECIFICATION(S)SQSQUARESSSTAINLESS STEELSWSHORT WAYTLTOP OF PIERTWTOP OF WALLTYPTYPICALUNOUNLESS NOTED OTHERWISI	н Т ОТ СН

FOUNDATION LEGEND

NEW COLUMN GRID MARK -CONCRETE PAD FOOTING -COLUMN -CONCRETE PIER -

COLUMN FOOTING MARK TOP OF FOOTING ELEVATION CONCRETE PIER MARK TOP OF PIER ELEVATION

TOP OF WALL FOOTING ELEVATION -

STRIP FOOTING MARK

SLAB-ON-GRADE JOINT

TOP OF EXISTING WALL FOOTING ELEVATION MASONRY WALL AND

LENGTH SIZE 0'-4" 8" W x 8" H B 8" W x 16" H 4'-8"


NOTES:

- CMU.
- 4. 8" MIN BEARING AT ENDS.

	MASO	NRY	' PIER S	CHEDL	JLE
MARK	SIZE (LENGTH)	TYPE	VERTICAL REINFORCING	CLOSED LOOP TIE	COMMENTS
MP1	16"	III	(6) #6	(2) SETS OF 1/4" AT 8"	
MP2	24"	IV	(8) #6	(2) SETS OF 1/4" AT 8"	
-		-			

NOTES

- MASONRY PIERS.
- MASONRY PIERS WITH TIES.
- 5. SIZE IS WALL WIDTH x LENGTH.

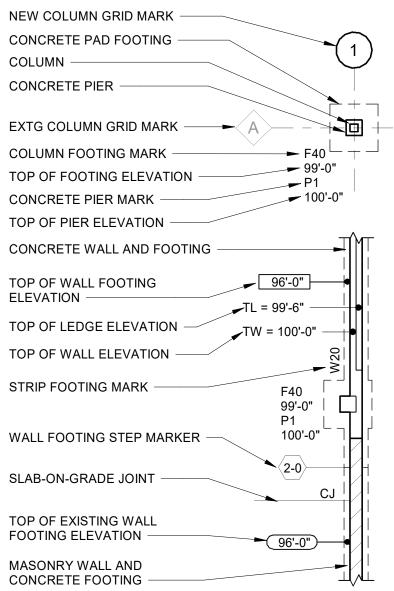

INTEL SCHED	JLE
AND REINFORCING	NOTE/ REMARKS
BOND BM W/ (2) #5 BOT	SEE ARCH FOR LOCATIONS
I BOND BM W/ (2) #5 BOT	SEE ARCH FOR LOCATIONS

1. AT NEW WALLS, REINFORCE AT BEARING WITH (1) #5 VERT FULL HEIGHT OF WALL FROM FLOOR TO FLOOR OR FLOOR TO ROOF. 2. AT EXISTING WALLS, BEAR LINTEL ON MIN (2) COURSES GROUTED

3. AT EXTERIOR OPENINGS, PROVIDE GALV BENT PL5/16"x7 1/2"x7 1/2" **x** CONT TO OPENING CORNERS.

1. ALL REINFORCED CMU CORES ARE GROUTED SOLID. 2. RUN HORIZONTAL JOINT REINFORCING CONT. THROUGH

3. USE 1/4" (2) RODS AS CLOSED LOOP TIES.

4. USE BOND BEAM CMU BLOCKS OR DROP TOP CMU BLOCK AT

WALL FOOTING SCHEDULE CONTINUOUS FOOTING DIMENSIONS WIDTH MARK THICKNESS FOOTING REINFORCEMENT REMARKS W18 1' - 8" (2) #4; B, CONT STOOP FTG 1' - 0" W24 2' - 4" (3) #5; B, CONT 1' - 0" W28 (3) #6; B, CONT 2' - 8" 1' - 0" (3) #6; B, CONT W30 3' - 0" 1' - 0" W36 3' - 6" 1' - 0" (x) #X; B, CONT W90 (9) #7 T&B W/ #7 @ 12" SHORT DIRECTION 9' - 0" 1' - 8" /2

MASONRY WALL REINFORCEMENT SCHEDULE


MARK	WALL	REINFORCEMENT		NOTES
MARK	TYPE	VERTICAL	HORIZONTAL	NOTES
A	12" CMU	#6 AT 16" OC	HJR AT 16" OC	BOND BEAM WITH (1) #5 AT 40" OC AND AT BOTTOM OF WALL
В	12" CMU	#8 AT 8" OC	HJR AT 16" OC	VERTICAL REINFORCING TO BE AT EXTERIOR FACE OF CMU
C	8" CMU	#6 AT 16" OC	HJR AT 16" OC	BOND BEAM WITH (1) #5 AT 40" OC AND AT BOTTOM OF WALL


NOTES:

- 1. SEE ARCHITECTURAL WALL TYPES FOR ADDITIONAL REQUIREMENTS.
- 2. REINFORCEMENT IS TO BE LOCATED IN CENTER OF WALL UNO.
- 3. PROVIDE CONTINUOUS BOND BEAM WITH (2) #5 AT ALL BEARING ELEVATIONS AND OVER WINDOWS DOORS AND OTHER OPENINGS UNO.
- 4. PROVIDE HORIZONTAL REINFORCEMENT INTO INTERSECTING WALLS AT 16" OC VERTICAL. EXTENT 30" EACH DIRECTION WITH PREFABRICATED "T" AND "L" SECTION TYP.
- 5. SEE GENERAL MASONRY NOTES ON SHEET S001 FOR NON LOAD BEARING WALL
- REINFORCEMENT REQUIREMENTS.
- 6. PROVIDE DOWELS TO MATCH VERTICAL REINFORCEMENT. EMBED DOWELS 30" INTO FOUNDATION WALL AND LAP 30" WITH OR MAKE CONTINUOUS WITH VERTICAL STEEL.


			BASE	E PL	ATE SCHEDULE
r	MARK	SIZE 'ť' x 'w' x 'L'	ANCHOR RODS	BASE PLATE TYPE	NOTES
	BP1	3/4" x 9" x 0'-9"	(4) 3/4" DIA x 4"	1	TYPICAL HSS4x4x1/2
	BP2	3/4" x 11" x 0'-9"	(4) 3/4" DIA x 4"	2	TYPICAL HSS5x3x5/16


BASE PLATE NOTES:

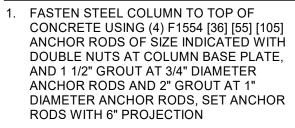

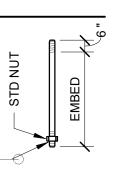

BASE PLATE TYPES:

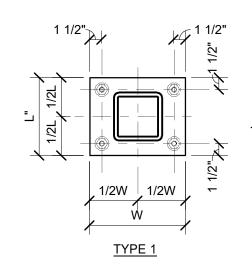

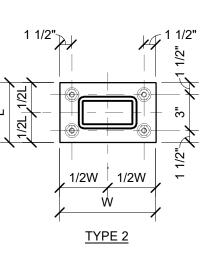

/2\

		LINTEL SCHEDULE
WALL THICK	CLEAR MASONRY OPENING WIDTH	SECTION
ALL	AT FIRE EXTINGUISHER CABINETS AND DRINKING FOUNTAINS	1/4" PLATE
4"	TO 5'-0"	ST3x6.25
4"	TO 7'-0"	PL 3/8 x 4 1/2 ON PL 3/8 x 3 1/2
4"	TO 9'-0"	PL3/8"x7 1/2" ON PL3/8"x3 1/2"
6"	TO 5'-0"	(2) L3 1/2x2 1/2x1/4 (LLV)
6"	TO 7'-0"	WT4x10.5
6"	TO 9'-0"	WT7x11
6"	TO 12'-0"	WT7x13 WITH PL1/2"x2"
Ŭ	10 12 0	3/16 1 1/2-8
8"	TO 5'-0"	(2) L3 1/2x3 1/2x1/4
8"	TO 7'-0"	(2) L4x3 1/2x5/16 (LLV)
8"	TO 9'-0"	WT7x15
10"	TO 7'-0"	W8x10 WITH PL5/16"x9"
		<u>3/16 ↓ 1 1/2-8 ↓ Ţ</u>
10"	TO 10'-0"	W8x15 WITH PL5/16"x9"
12"	TO 5'-0"	(3) L3 1/2x3 1/2x1/4
12"	TO 7'-0"	W8x10 WITH PL5/16"x11"
		<u>3/16 ↓ 1 1/2-8 ↓ ⊥</u>
12"	TO 10'-0"	W8x15 WITH PL5/16"x11"


NOTES:

- 1. PROVIDE MINIMUM 8" BEARING AT EACH END OF LINTEL.
- 2. GROUT BLOCK CORES AND REINFORCE WITH (1) #5 VERT BELOW LINTEL BEARING.
- 3. CENTER LINTELS IN WALL UNLESS OTHERWISE NOTED.
- 4. BOTTOM PLATES UNDER WIDE FLANGE SHAPES SHALL BE EXTENDED FULL LENGTH OF LINTEL.
- 5. WELD LINTEL COMPONENTS INTO SINGLE UNIT.
- 6. NOT LINTELS ARE REQUIRED FOR 4" AND 6" NON-BEARING MASONRY WALLS WHERE GROUTED HOLLOW METAL FRAMES HAVE A HEADSPAN OF 4'-0" OR LESS.

BRICK LOOSE LINTEL SCHEDULE		
SECTION	NOTE/ REMARKS	
L4x4x5/16		
L6x4x3/8		
L7x4x1/2		
L8x4x3/4		
	SECTION L4x4x5/16 L6x4x3/8 L7x4x1/2	

<u>NOTES:</u>

- 1. LINTELS TO BE SHOP PAINTED WITH ZINC RICK URETHANE. SEE SPECIFICATIONS.
- 2. PROVIDE 4" MIN BEARING EACH END OF LINTEL UNDER 9'-0". 8" BEARING FOR LONGER LINTELS.
- 3. SEE ARCH FOR CONTROL JOINT LOCATIONS AND FLASHING REQUIREMENTS.

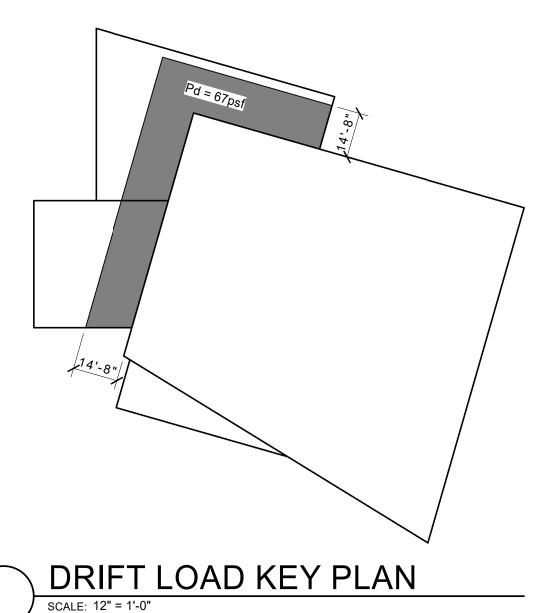



MILWAUKEE | MADISON | CHICAGO

Total Integra Enterprises www.otie.com Job Number 2023037

Office 608.243.6470 Fax 608.241.3914 5100 Eastpark Blvd, Suite 300, Madison, Wisconsin 53718

Contractors are responsible for the means, methods, techniques, sequences and procedures of construction including, but not limited to, temporary supports, shoring, forming to support imposed loads and other similar items.

WARNER PARK COMMUNITY **RECREATION CENTER** EXPANSION

1625 NORTHPORT DRIVE MADISON, WI 53704 CITY OF MADISON PARKS DIVISION 330 EAST LAKESIDE STREET MADISON, WI 53715


PROJECT NUMBER

ISSUE	D FOR:	
BID S	ET	5/16/2024
REVIS	ION FOR:	
NO.	DESCRIPTION	DATE
1	ADDENDUM 2	06/14/2024
2	ADDENDUM 3	06/20/2024

DRAWN BY	AWB
CHECKED BY	Checker

STRUCTURAL SCHEDULES

^{223471.00}

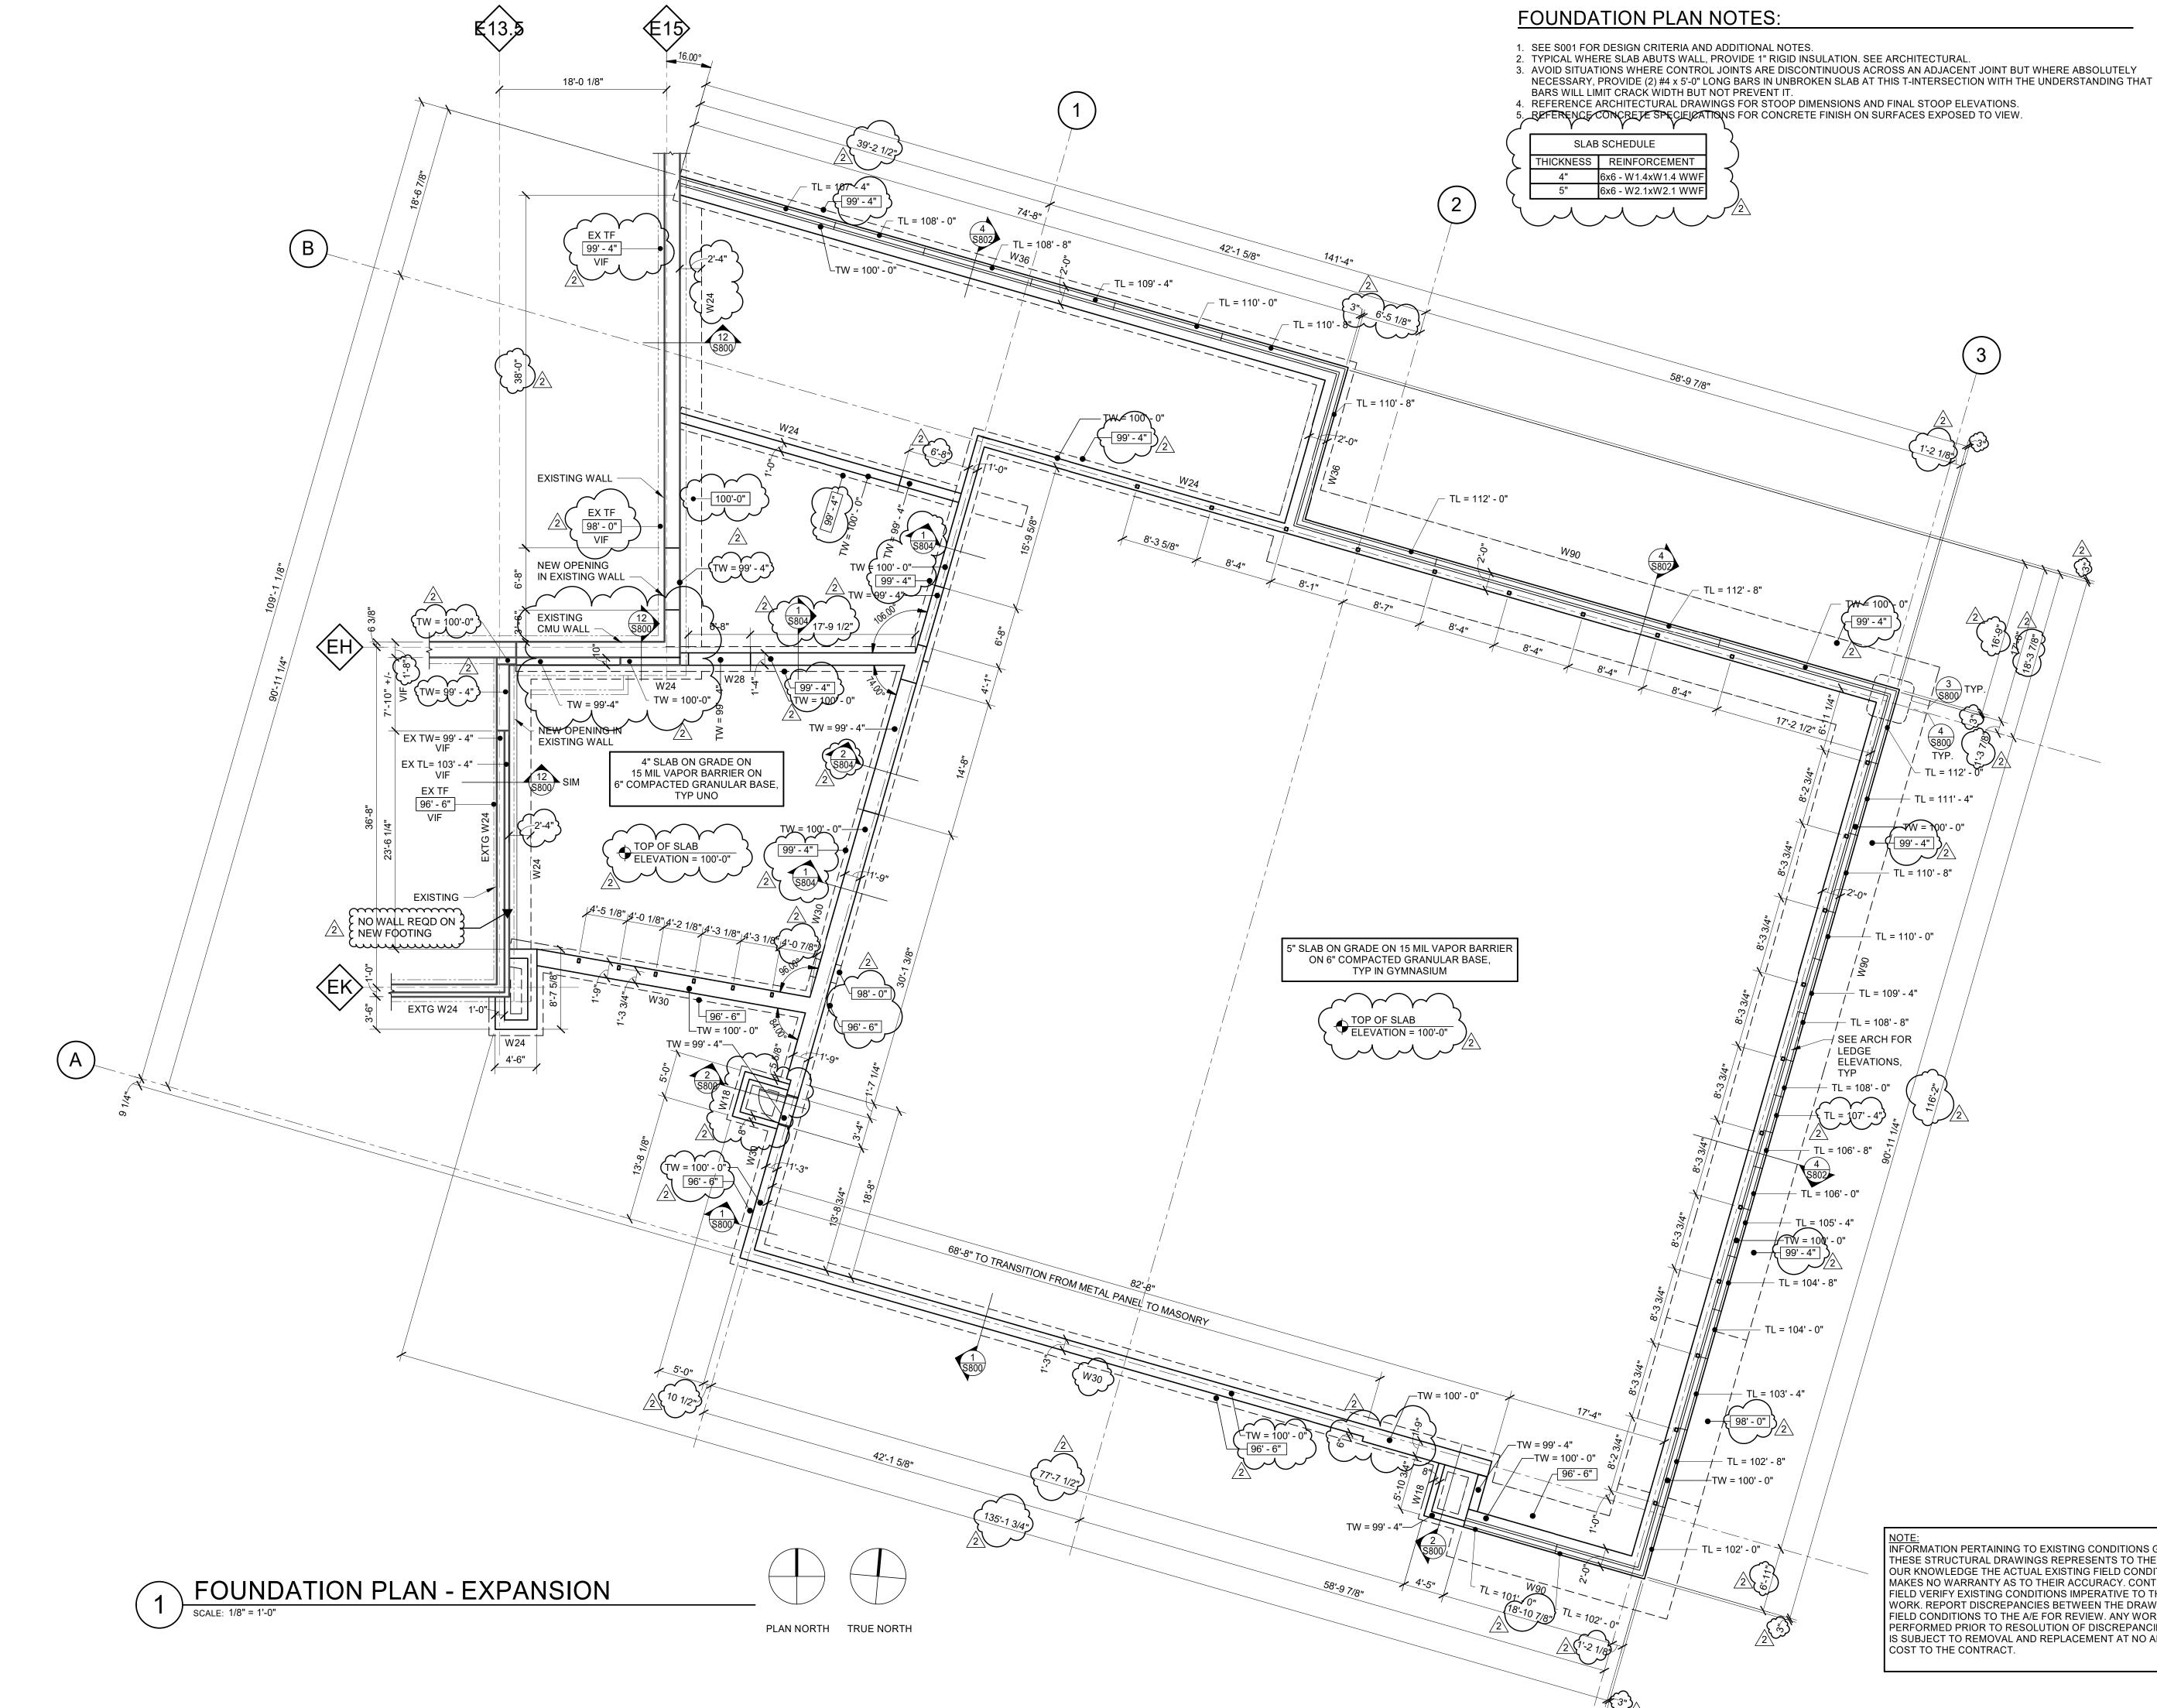



ONEID Total Integrated **Enterprises** www.otie.com Job Number 2023037

Office 608.243.6470 Fax 608.241.3914 5100 Eastpark Blvd, Suite 300, Madison, Wisconsin 53718


Contractors are responsible for the means, methods, techniques, sequences and procedures of construction including, but not limited to, temporary supports, shoring, forming to support imposed loads and other similar items.

WARNER PARK COMMUNITY **RECREATION CENTER** EXPANSION

1625 NORTHPORT DRIVE MADISON, WI 53704 CITY OF MADISON PARKS DIVISION 330 EAST LAKESIDE STREET MADISON, WI 53715

PROJECT NUMBER


223471.00

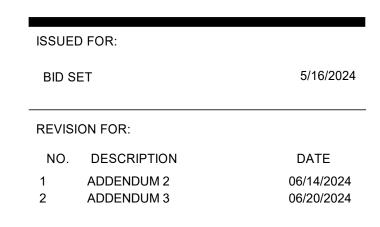

DRAWN BY	AWB
CHECKED BY	Checker

FOUNDATION PLAN -EXPANSION

NOTE: INFORMATION PERTAINING TO EXISTING CONDITIONS GIVEN ON THESE STRUCTURAL DRAWINGS REPRESENTS TO THE BEST OF OUR KNOWLEDGE THE ACTUAL EXISTING FIELD CONDITIONS. OTIE MAKES NO WARRANTY AS TO THEIR ACCURACY. CONTRACTOR TO FIELD VERIFY EXISTING CONDITIONS IMPERATIVE TO THE NEW WORK. REPORT DISCREPANCIES BETWEEN THE DRAWINGS AND FIELD CONDITIONS TO THE A/E FOR REVIEW. ANY WORK PERFORMED PRIOR TO RESOLUTION OF DISCREPANCIES BY THE A/E IS SUBJECT TO REMOVAL AND REPLACEMENT AT NO ADDITIONAL

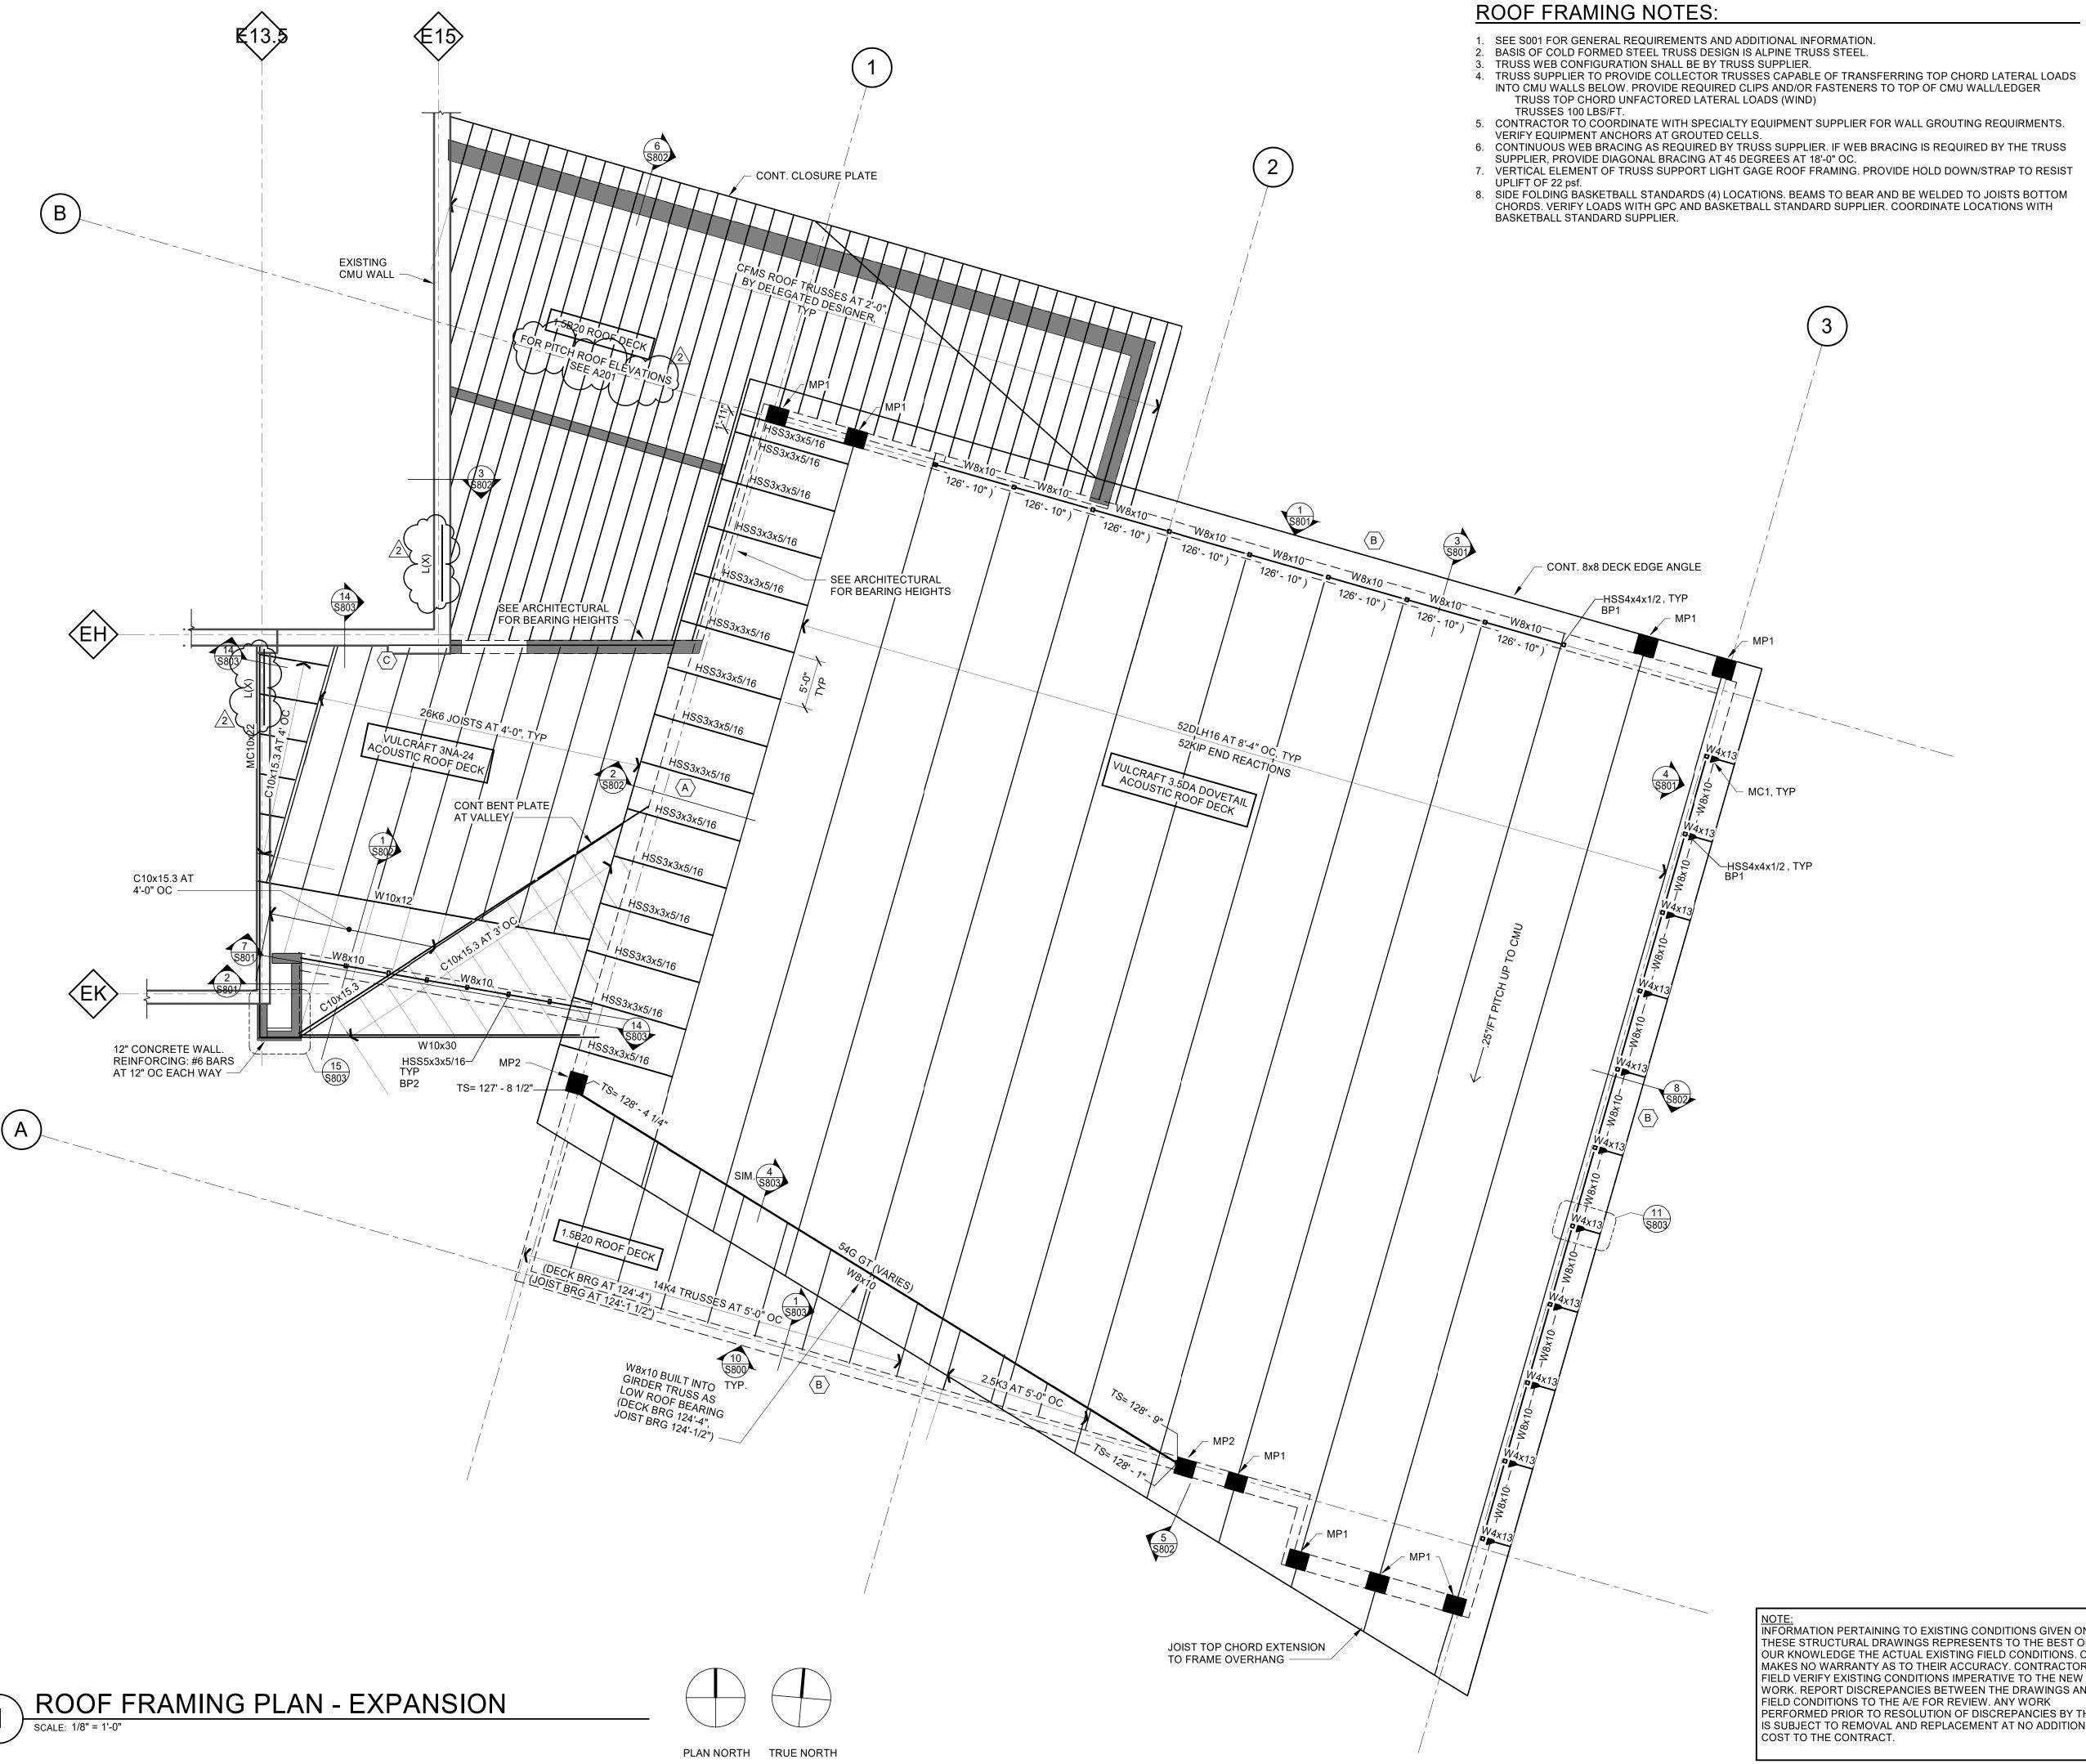

INTO CMU WALLS BELOW. PROVIDE REQUIRED CLIPS AND/OR FASTENERS TO TOP OF CMU WALL/LEDGER

5. CONTRACTOR TO COORDINATE WITH SPECIALTY EQUIPMENT SUPPLIER FOR WALL GROUTING REQUIRMENTS. VERIFY EQUIPMENT ANCHORS AT GROUTED CELLS. 6. CONTINUOUS WEB BRACING AS REQUIRED BY TRUSS SUPPLIER. IF WEB BRACING IS REQUIRED BY THE TRUSS

SIDE FOLDING BASKETBALL STANDARDS (4) LOCATIONS. BEAMS TO BEAR AND BE WELDED TO JOISTS BOTTOM CHORDS. VERIFY LOADS WITH GPC AND BASKETBALL STANDARD SUPPLIER. COORDINATE LOCATIONS WITH



MILWAUKEE | MADISON | CHICAGO

ONEID Total Integrated Enterprises www.otie.com Job Number 2023037

Office 608.243.6470 Fax 608.241.3914 5100 Eastpark Blvd, Suite 300, Madison, Wisconsin 53718

Contractors are responsible for the means, methods, techniques, sequences and procedures of construction including, but not limited to, temporary supports, shoring, forming to support imposed loads and other similar items.

WARNER PARK COMMUNITY **RECREATION CENTER** EXPANSION

1625 NORTHPORT DRIVE MADISON, WI 53704 CITY OF MADISON PARKS DIVISION 330 EAST LAKESIDE STREET MADISON, WI 53715

PROJECT NUMBER


/16/2024
ATE
14/2024
20/2024

DRAWN BY	AWB
CHECKED BY	Checker

ROOF FRAMING PLAN -EXPANSION

NOTE: INFORMATION PERTAINING TO EXISTING CONDITIONS GIVEN ON THESE STRUCTURAL DRAWINGS REPRESENTS TO THE BEST OF OUR KNOWLEDGE THE ACTUAL EXISTING FIELD CONDITIONS. OTIE MAKES NO WARRANTY AS TO THEIR ACCURACY. CONTRACTOR TO FIELD VERIFY EXISTING CONDITIONS IMPERATIVE TO THE NEW WORK. REPORT DISCREPANCIES BETWEEN THE DRAWINGS AND FIELD CONDITIONS TO THE A/E FOR REVIEW. ANY WORK PERFORMED PRIOR TO RESOLUTION OF DISCREPANCIES BY THE A/E IS SUBJECT TO REMOVAL AND REPLACEMENT AT NO ADDITIONAL

^{223471.00}

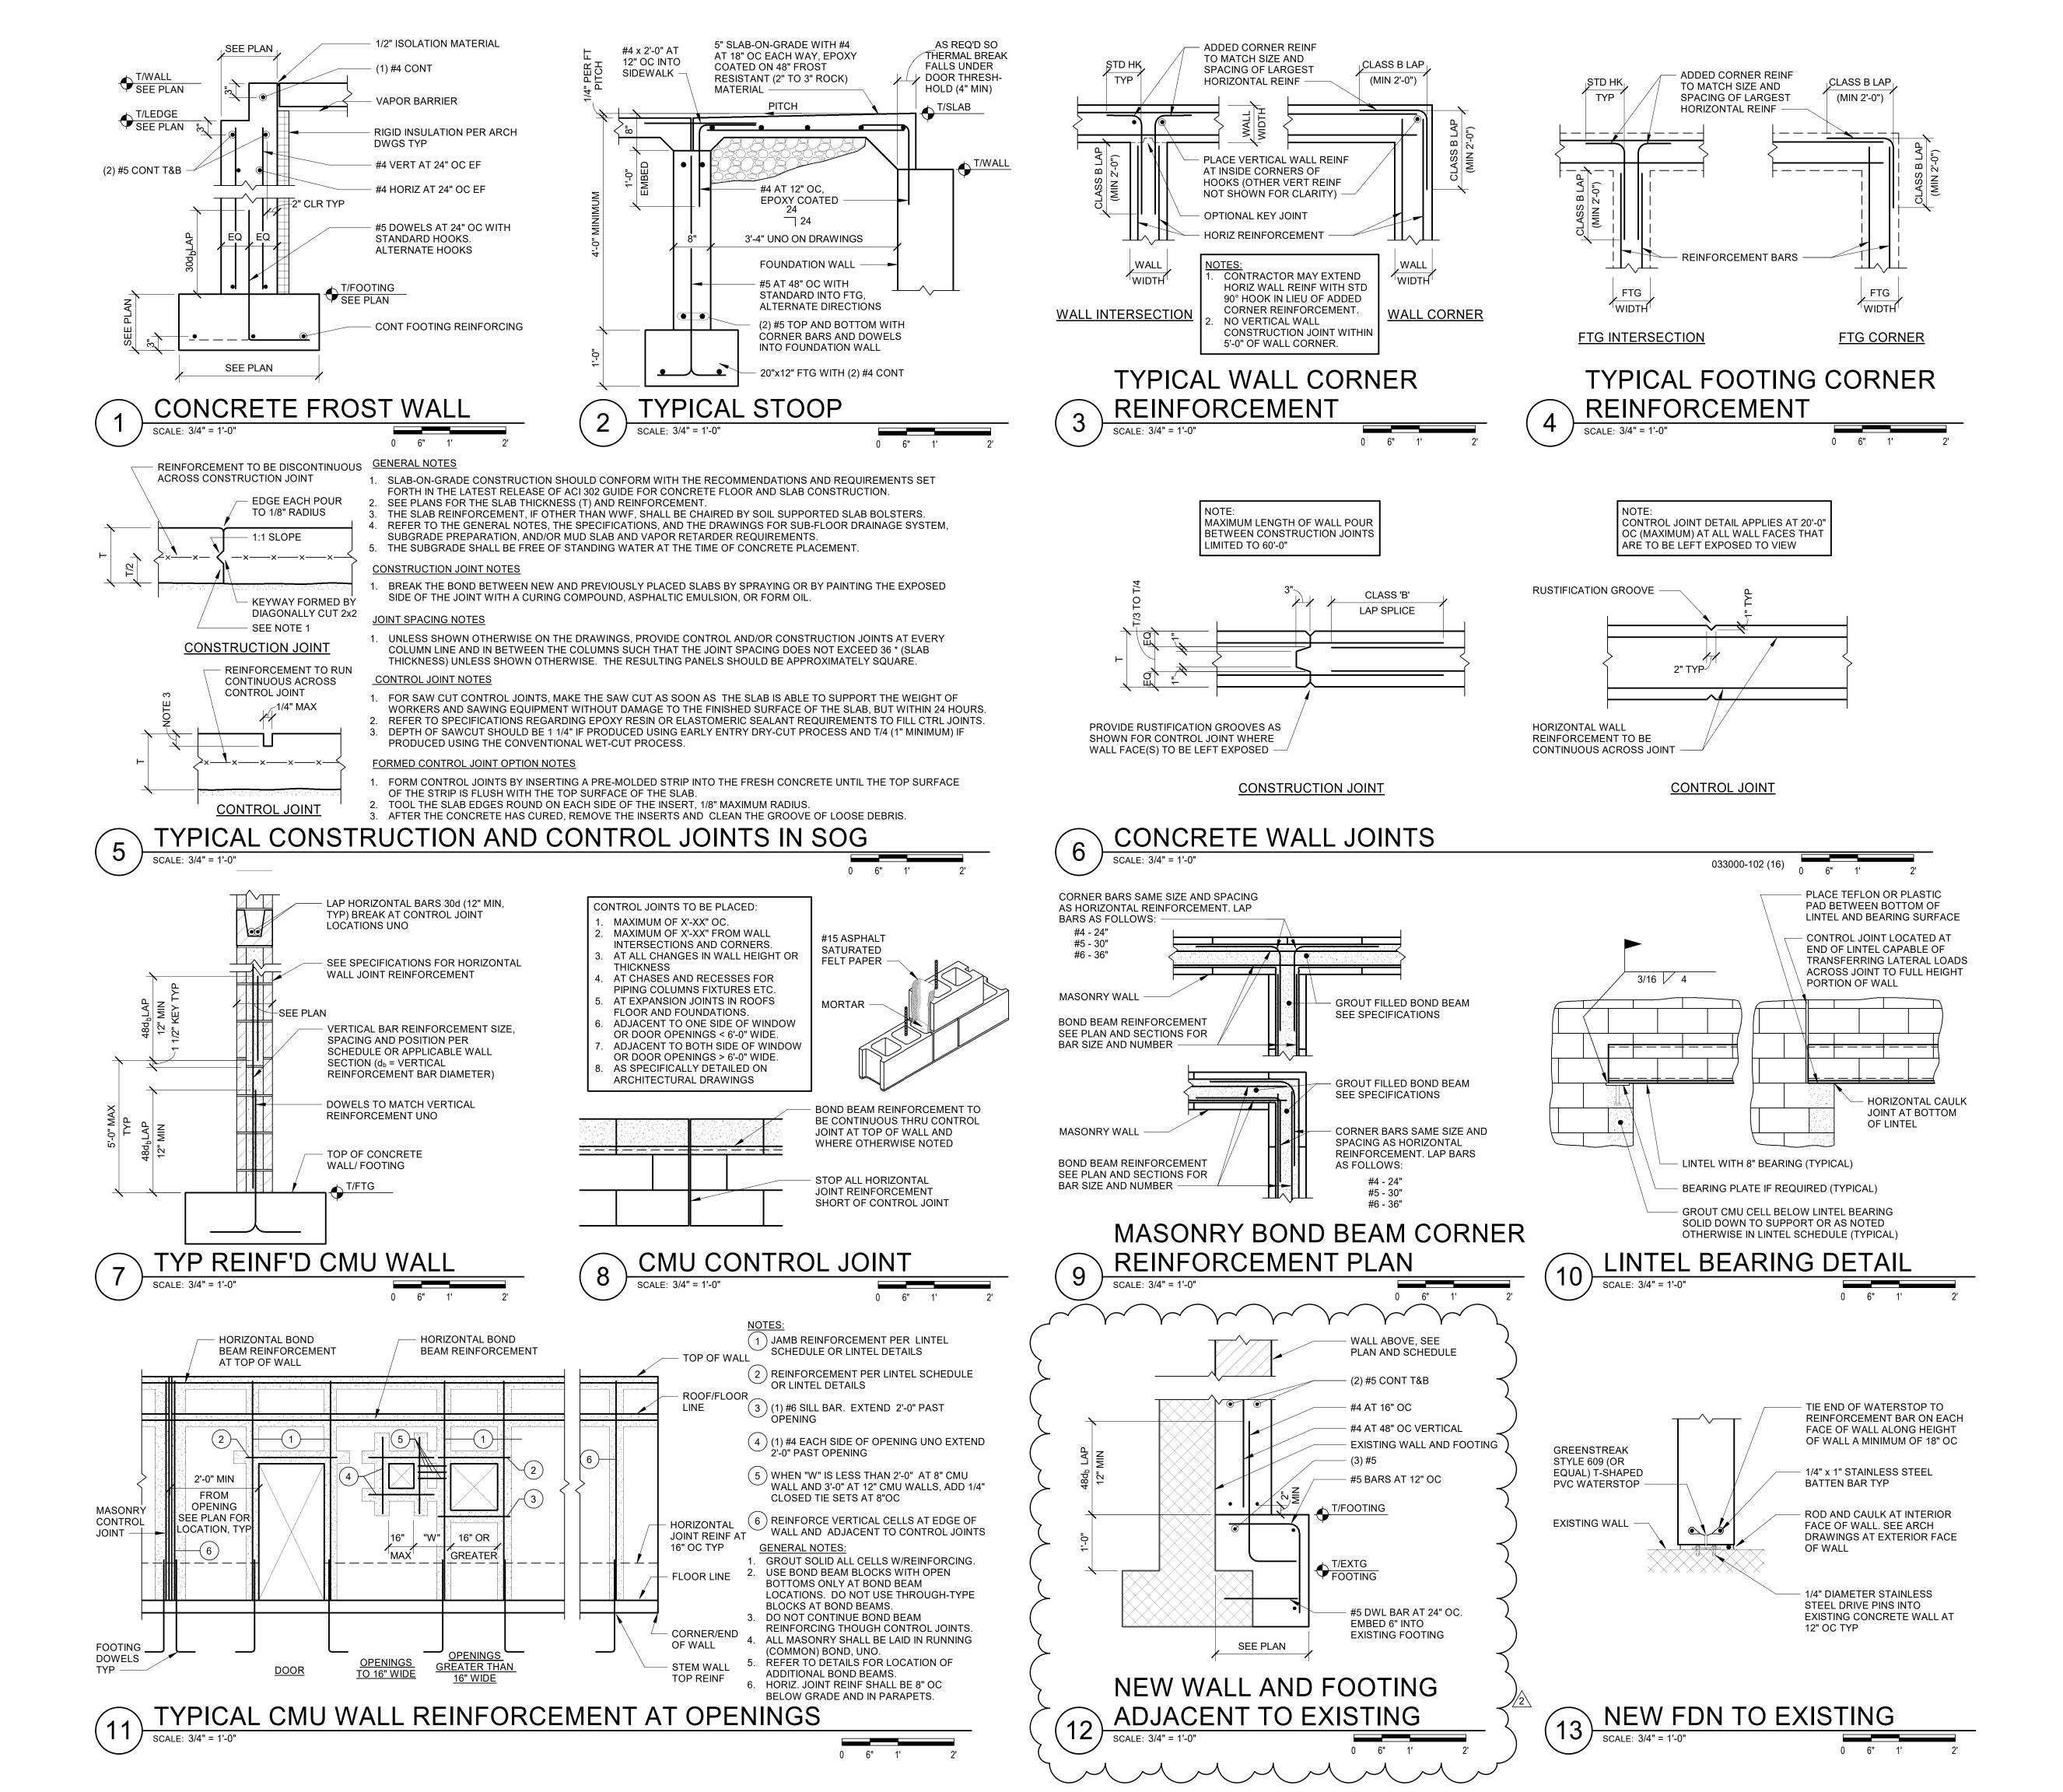



Total Integrated Enterprises

Office 608.243.6470 Fax 608.241.3914 5100 Eastpark Blvd, Suite 300, Madison, Wisconsin 53718

Contractors are responsible for the means, methods, techniques, sequences and procedures of construction including, but not limited to, temporary supports, shoring

forming to support imposed loads and other similar iten

WARNER PARK COMMUNITY RECREATION CENTER EXPANSION

1625 NORTHPORT DRIVE MADISON, WI 53704 CITY OF MADISON PARKS DIVISION 330 EAST LAKESIDE STREET MADISON, WI 53715


PROJECT NUMBER


ISSUEI	D FOR:	
BID S	ET	5/16/2024
REVISI	ON FOR:	
NO.	DESCRIPTION	DATE
2	ADDENDUM 3	06/20/2024


DRAWN BY	AWB
CHECKED BY	Checker


STRUCTURAL DETAILS

^{223471.00}

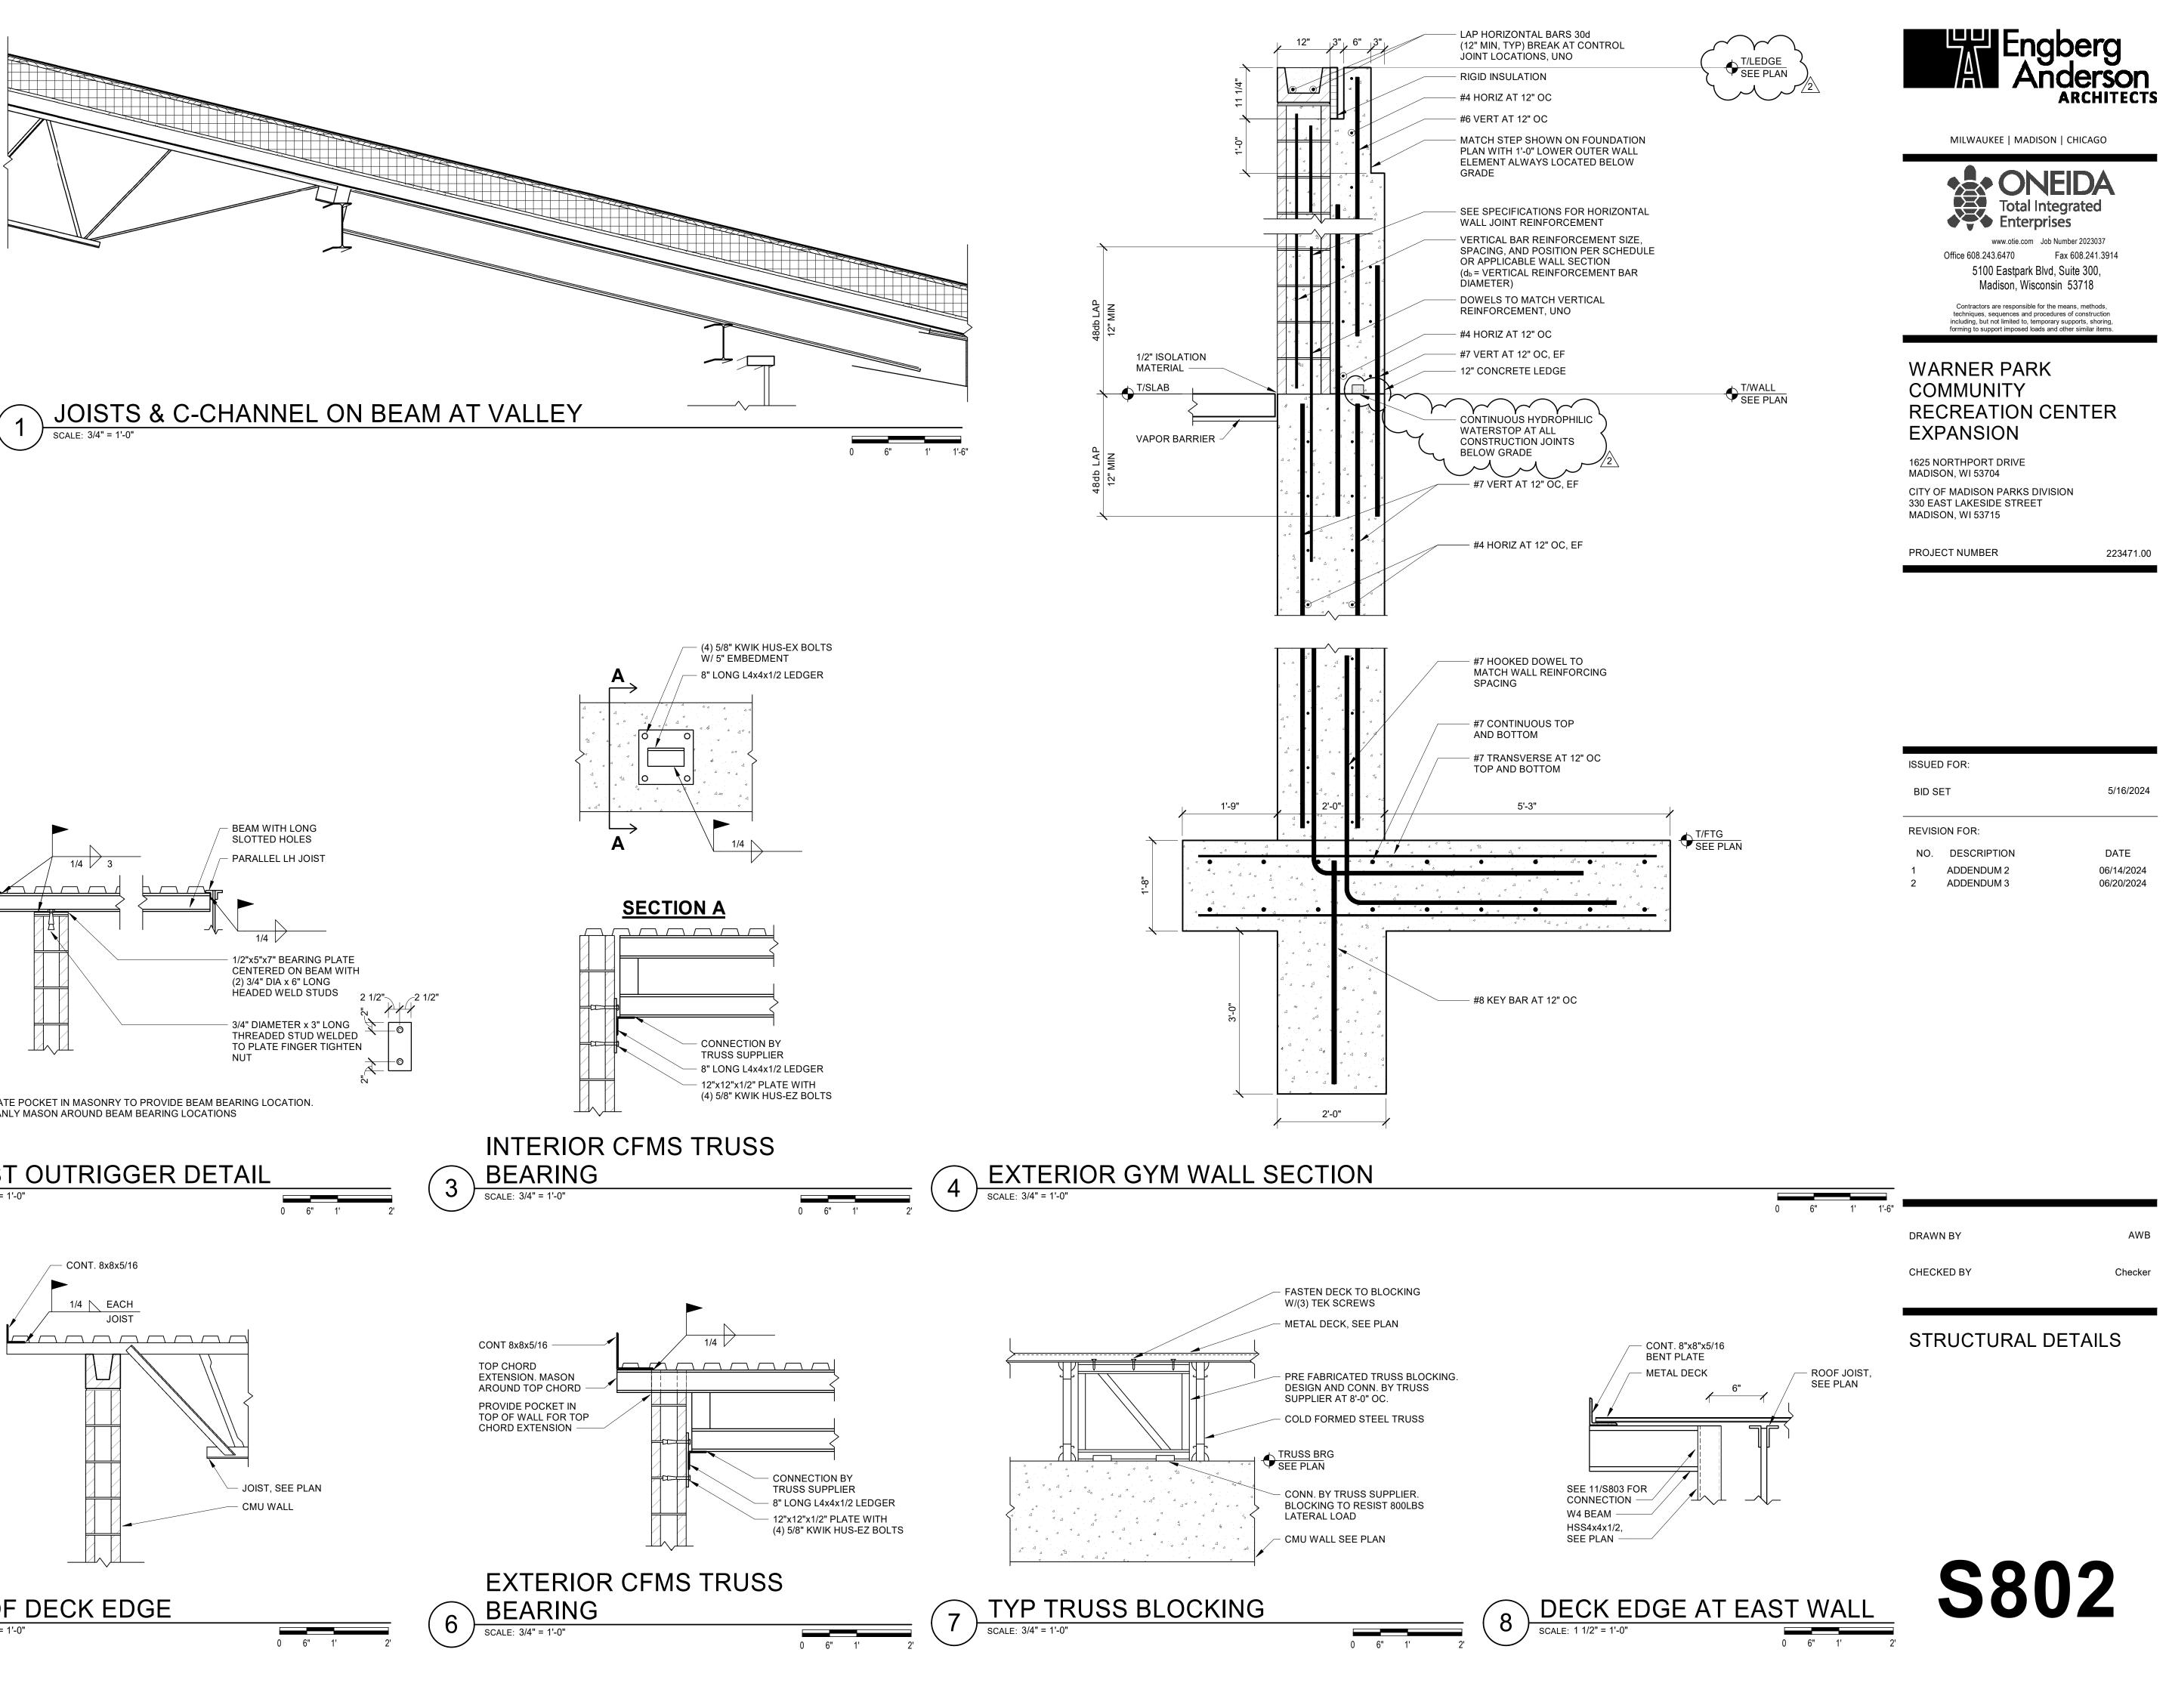

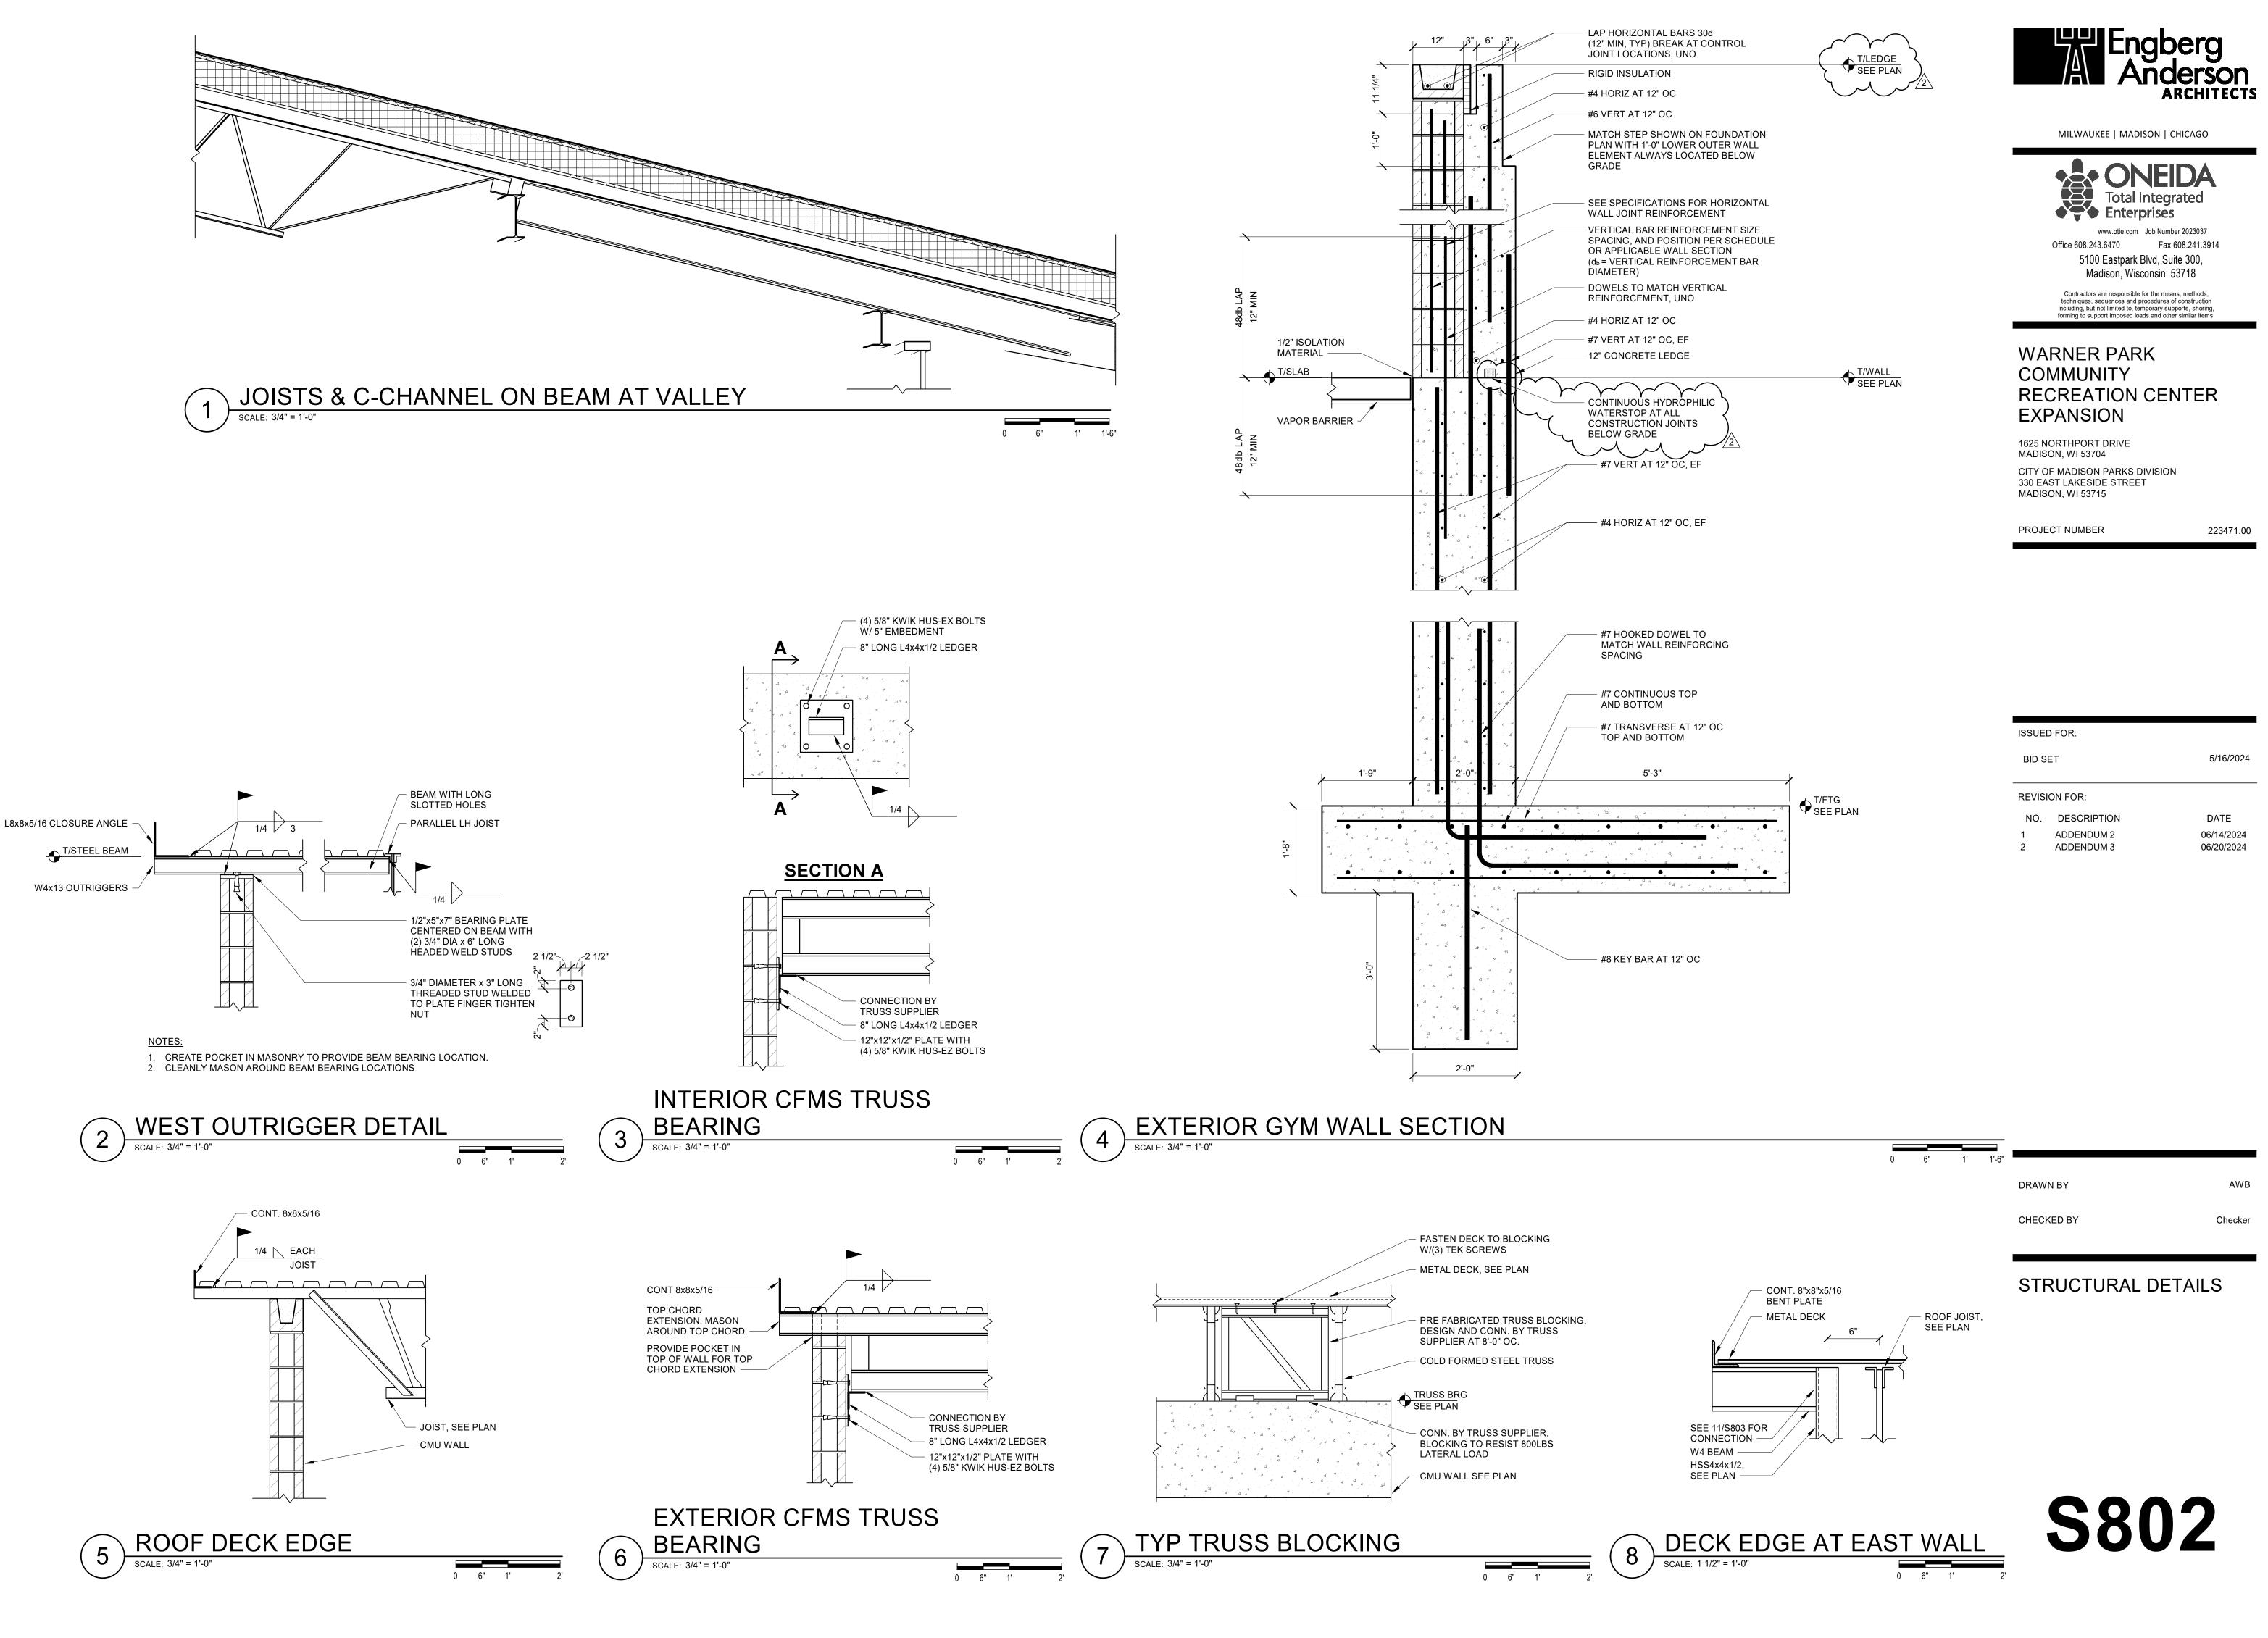

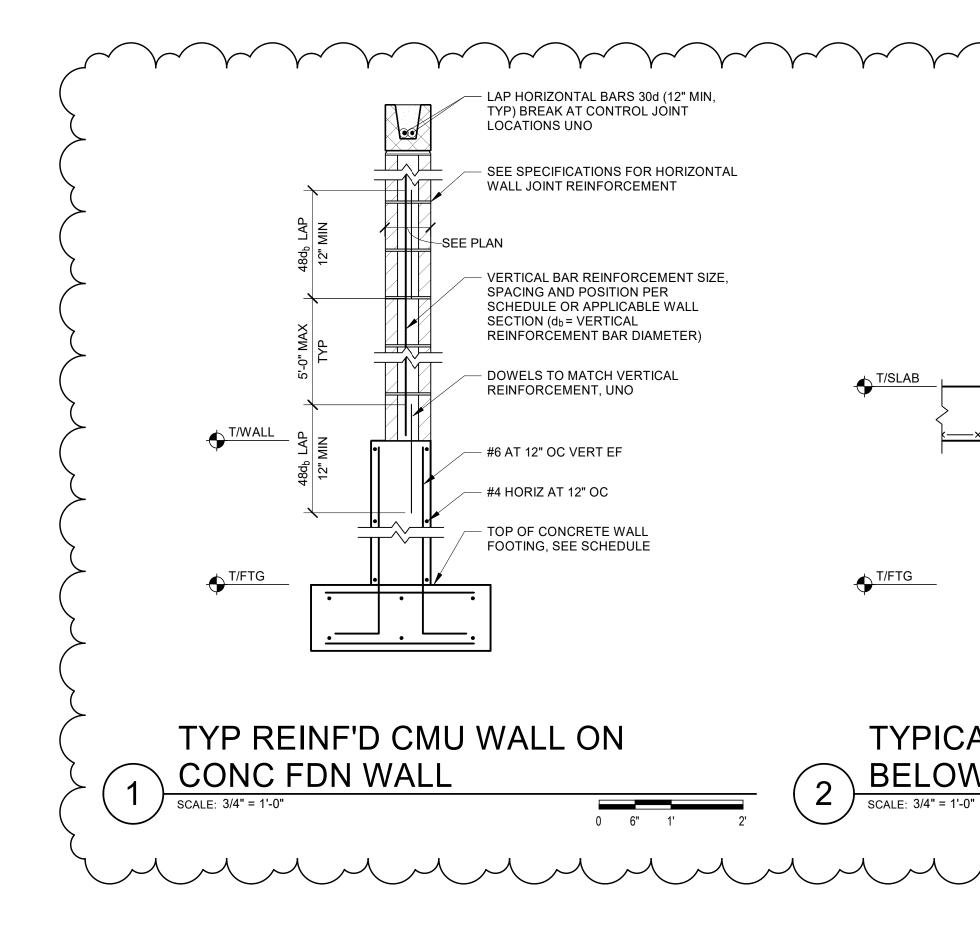


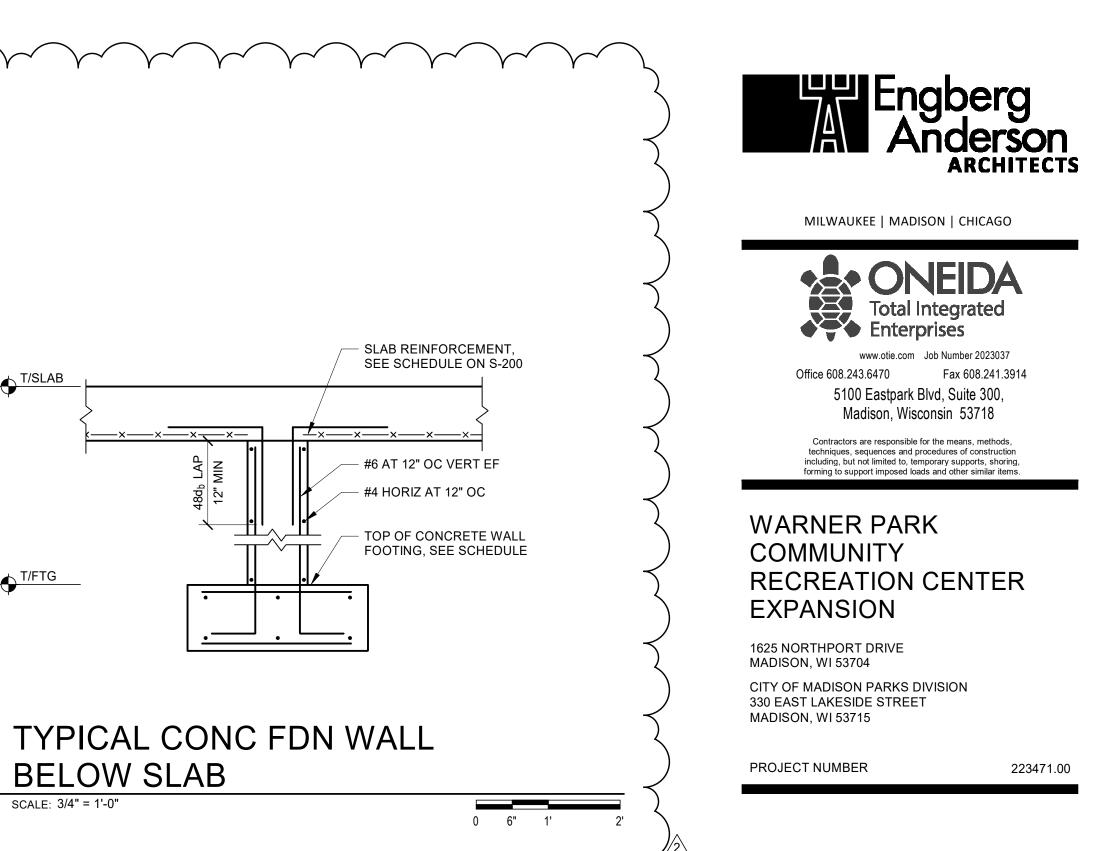


ISSUE	D FOR:	
BID S	ET	5/16/2024
REVIS	ION FOR:	
NO.	DESCRIPTION	DATE
2	ADDENDUM 3	06/20/2024

DRAWN BY	AWB
CHECKED BY	Checker

STRUCTURAL DETAILS

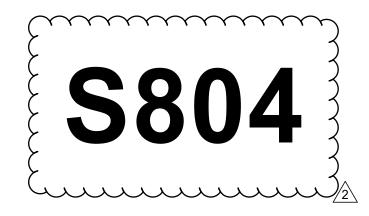



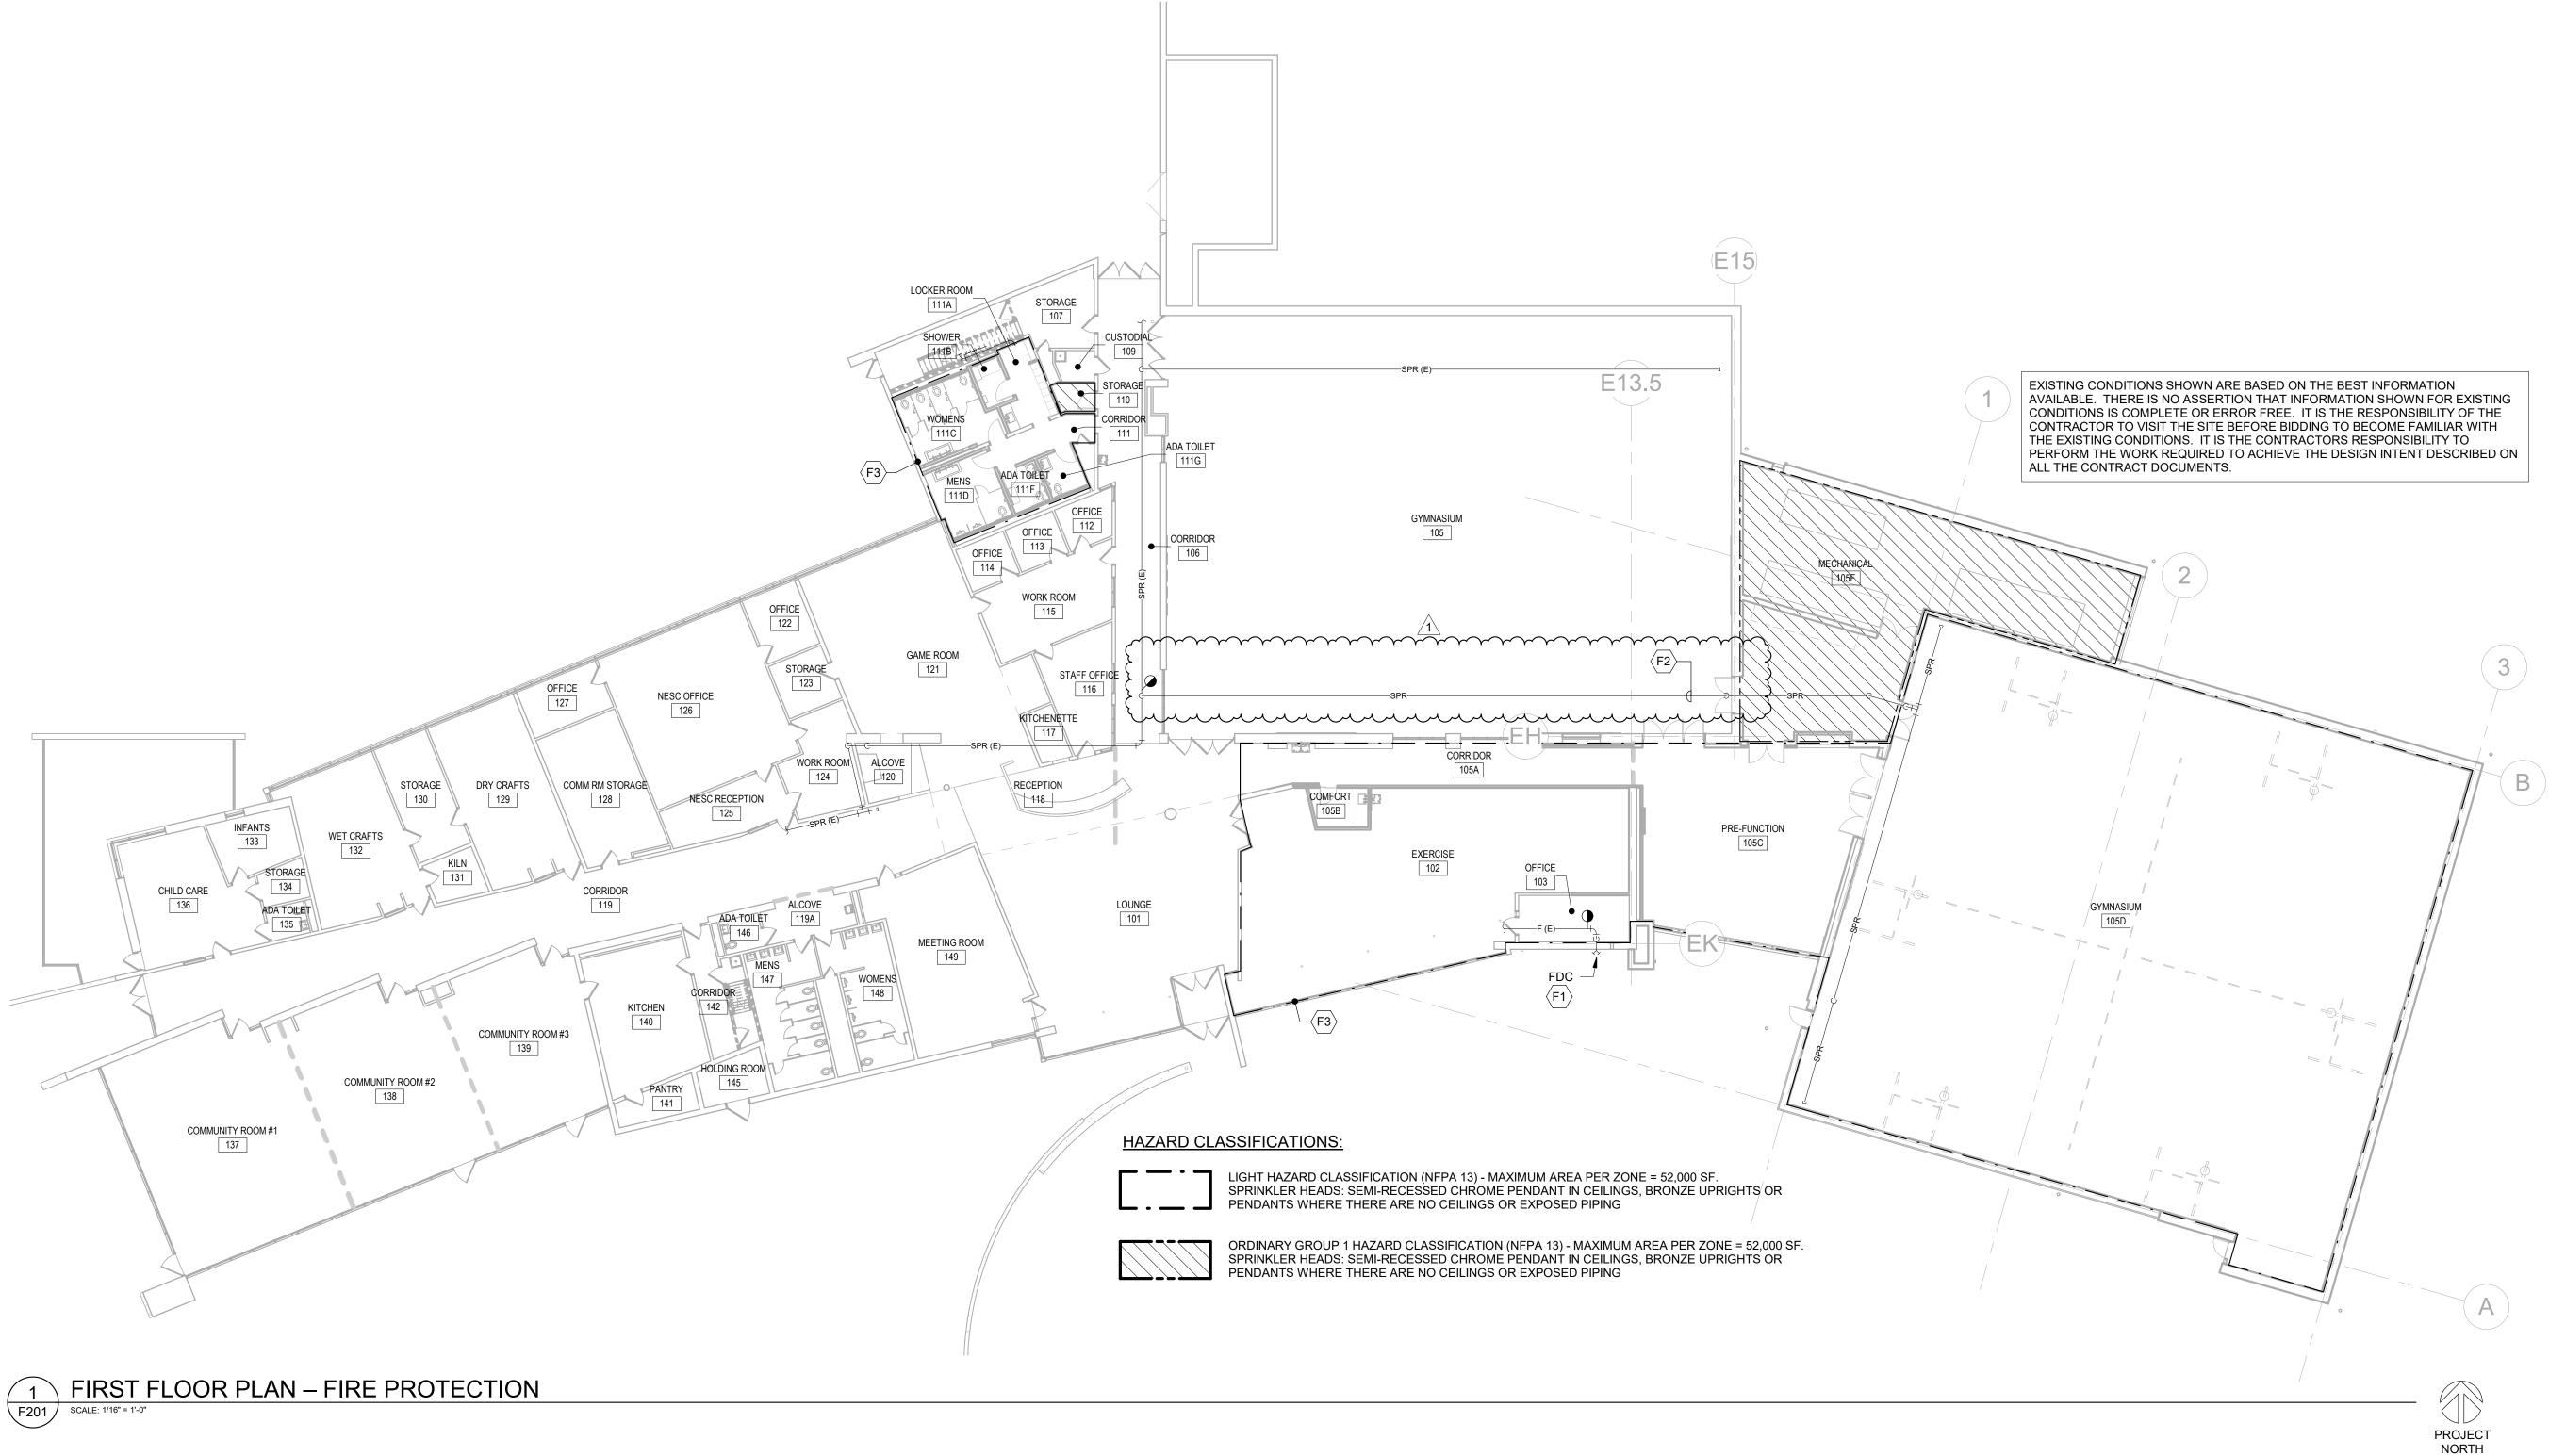

KEYED NOTES

(KEYED NOTES PER PROJECT) F1 INSTALL NEW FDC, CHECK VALVE, DRAIN VALVE AND RECONNECT TO EXISTING FIRE PROTECTION PIPING. COORDINATE EXACT LOCATION OF NEW FDC WITH OWNER TO ALLOW FOR PROPER CLEARANCE WITH OUT OBSTRUCTION REQUIRED PER LOCAL AHJ.

- F2 EXTEND 3" SPRINKLER MAIN LOCATED IN EXISTING GYMNASIUM TO SERVE EXPANSION.
- F3 REWORK SPRINKLER PIPING AND SPRINKLER HEADS AS REQUIRED TO PROVIDE PROPER SPRINKLER COVERAGE PER NFPA 13. NO EXISTING SPRINKLER HEADS ARE TO BE REUSED.



MILWAUKEE | MADISON | CHICAGO



ENGINEERING, INC. 5525 NOBEL DRIVE SUITE 110 MADISON, WI 53711 PH: 608.277.1728 FAX: 608.271.7046 JDR PROJECT NO: 23.0319

WARNER PARK COMMUNITY RECREATION CENTER EXPANSION

1625 NORTHPORT DRIVE MADISON, WI 53704

CITY OF MADISON PARKS DIVISION 330 EAST LAKESIDE STREET MADISON, WI 53715

PROJECT NUMBER


223471.00

ISSUED FOR:	
BID SET	5/16/2024
REVISION FOR:	
NO. DESCRIPTION	DATE
1 Addendum #3	6/18/2024

DRAWN BY	CRR
CHECKED BY	JDR

FIRST FLOOR PLAN -FIRE PROTECTION

F201

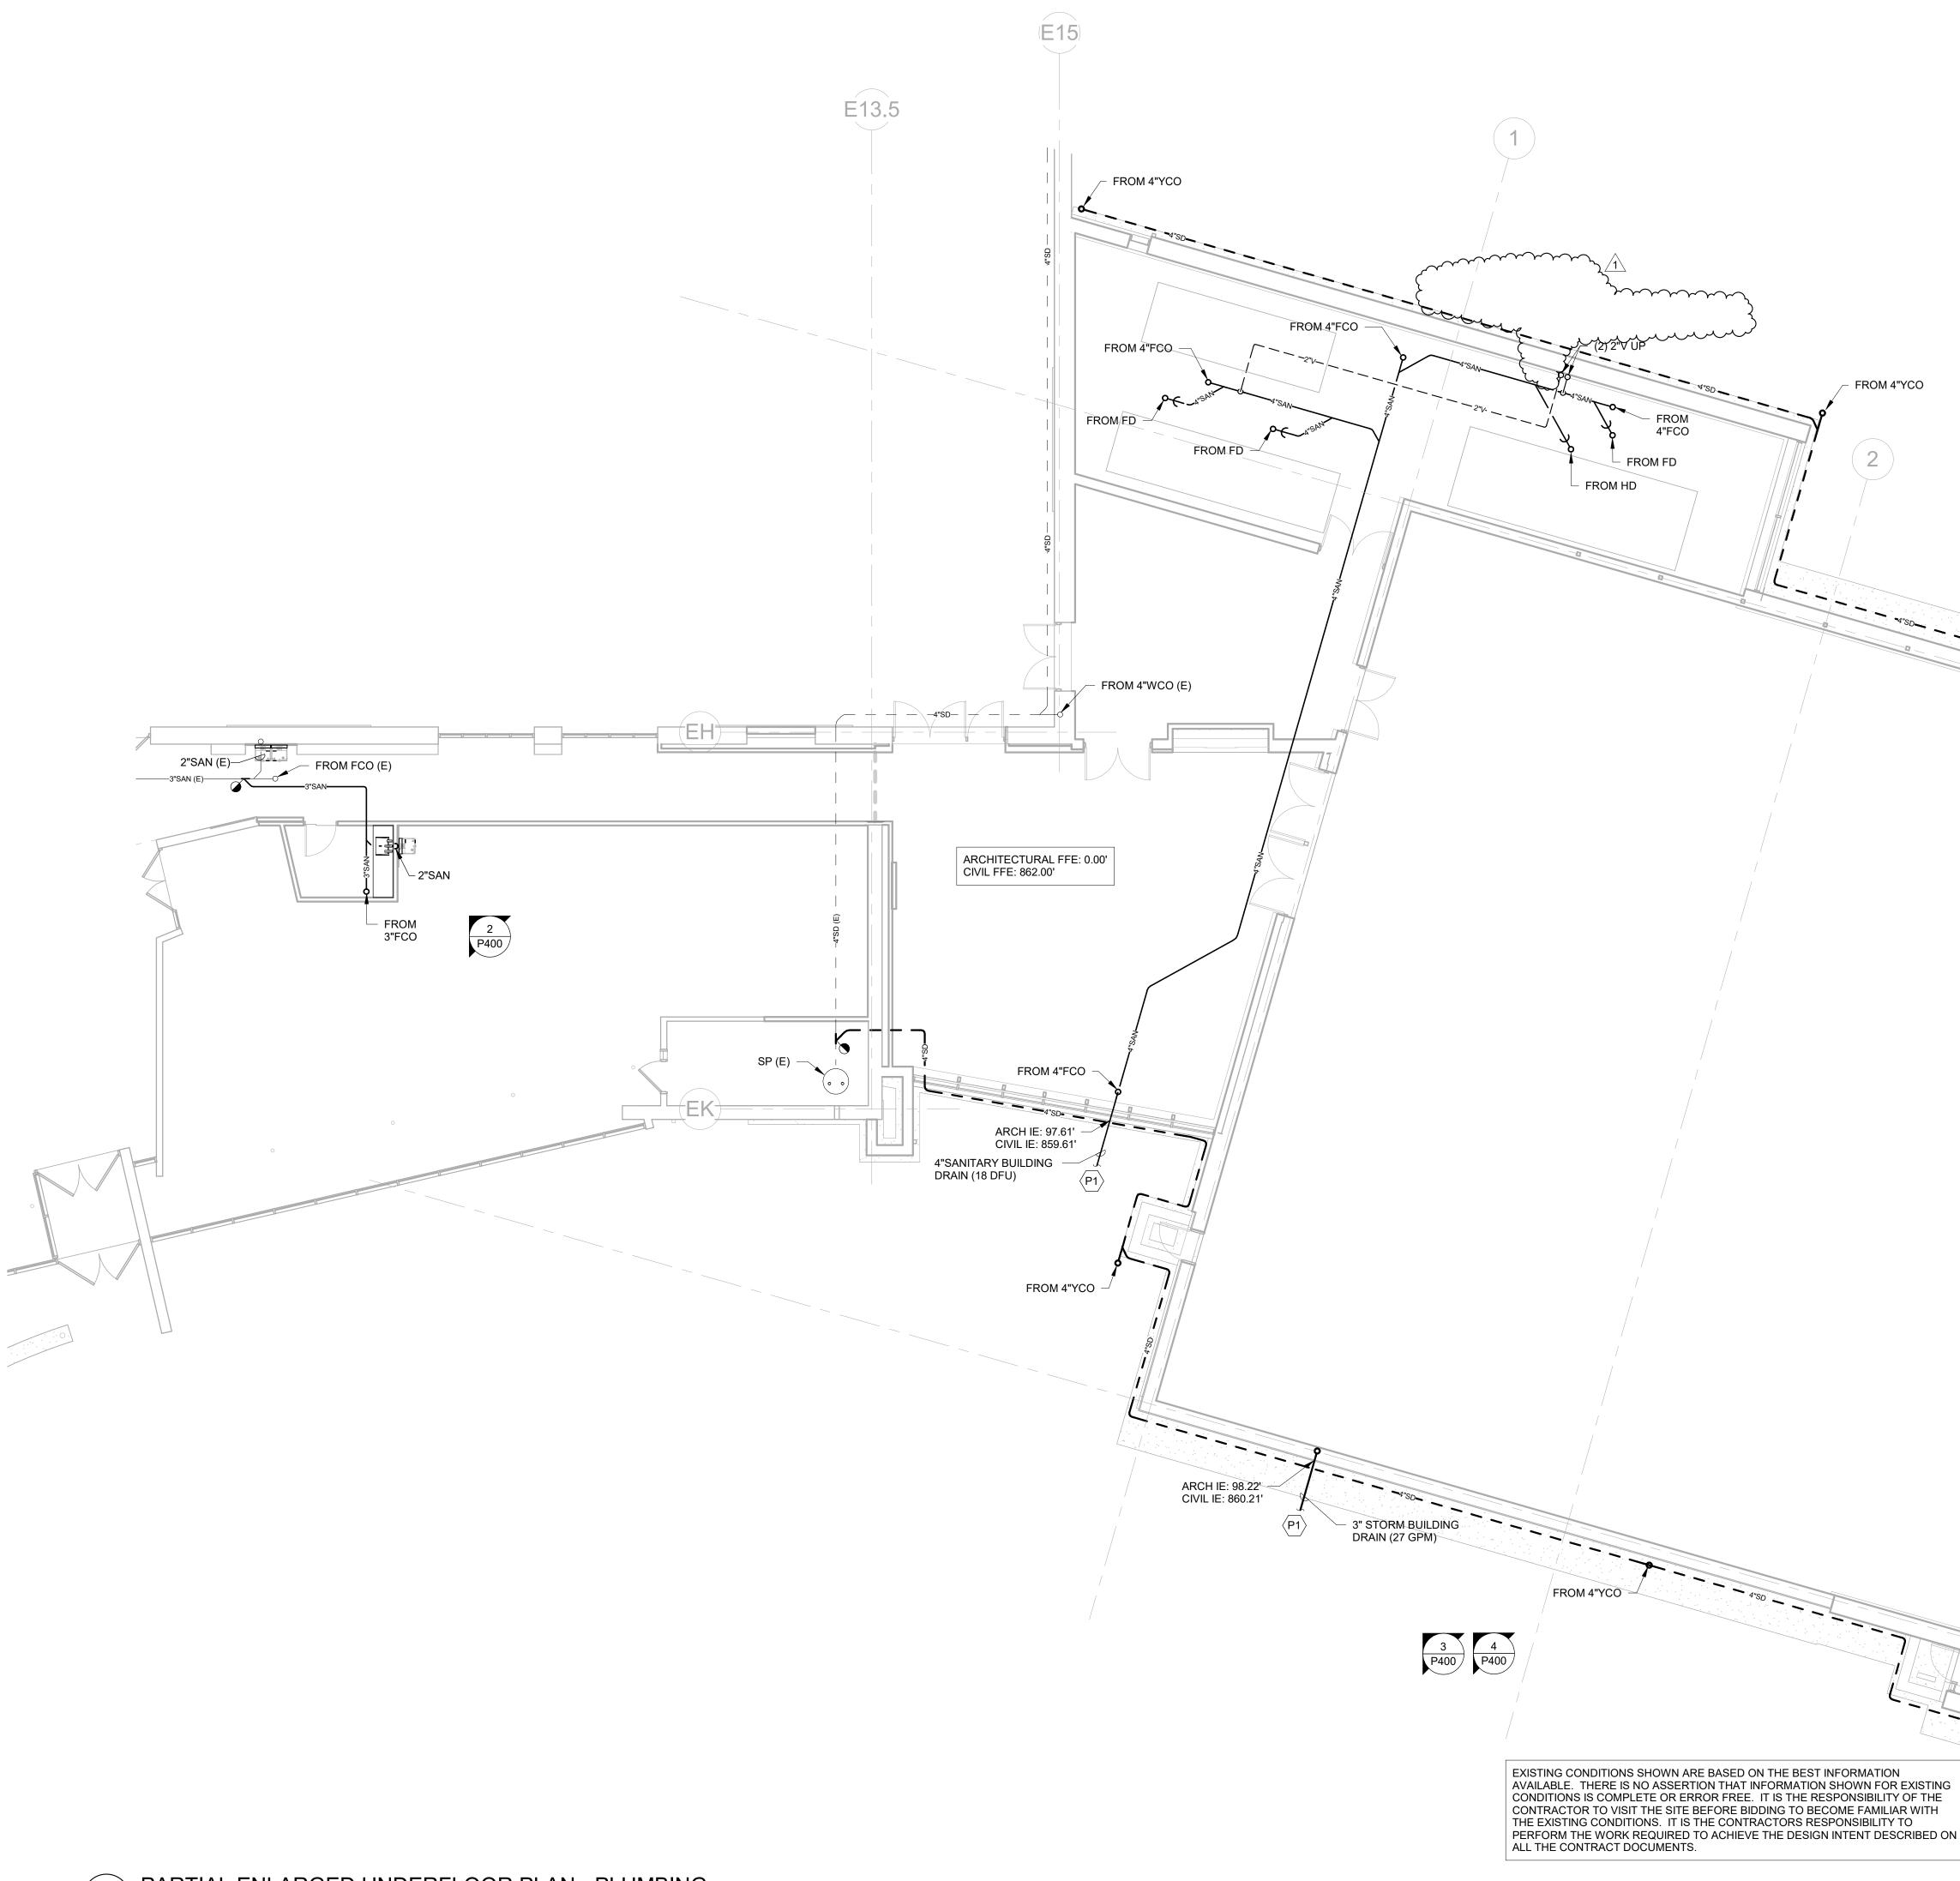

GENERAL NOTES:

- 1. PC SHALL VISIT SITE AND BECOME FAMILIAR WITH EXISTING CONDITIONS PRIOR TO CONSTRUCTION. PC SHALL FIELD VERIFY ALL EXISTING CONDITIONS AND REPORT ANY DISCREPANCIES TO THE A/E PRIOR TO COMMENCING WORK.
- 2. PC SHALL MAINTAIN AND PROTECT ALL EXISTING PIPING AND FIXTURES THAT ARE TO REMAIN DURING CONSTRUCTION.
- 3. IF A DEAD END IS CREATED IN THE REMOVAL OF ANY PART OF A DRAIN SYSTEM, ALL OPENINGS IN THE DRAIN SHALL BE PROPERLY SEALED.
- 4. THE PLUMBING CONTRACTOR SHALL FIELD VERIFY NO DEAD ENDS IN DRAINAGE OR WATER DISTRIBUTION SYSTEM EXCEEDING A DEVELOPED LENGTH OF MORE THAN TWO FEET (2') REMAIN.

KEYED NOTES

- 4"SD

- FROM 4"YCO

(KEYED NOTES PER PROJECT) P1 PC SHALL ROUTE SERVICE TO 5'-0" OUTSIDE OF BUILDING STRUCTURE, CONTINUATION BY SITE UTILITY CONTRACTOR. COORDINATE FINAL LOCATION AND DEPTH WITH SITE UTILITY CONTRACTOR.

4"SD



MILWAUKEE | MADISON | CHICAGO



ENGINEERING, INC. 5525 NOBEL DRIVE SUITE 110 MADISON, WI 53711 PH: 608.277.1728 FAX: 608.271.7046 JDR PROJECT NO: 23.0319

WARNER PARK COMMUNITY RECREATION CENTER EXPANSION

1625 NORTHPORT DRIVE MADISON, WI 53704

CITY OF MADISON PARKS DIVISION 330 EAST LAKESIDE STREET MADISON, WI 53715

PROJECT NUMBER

3

B

FROM 4"YCO

223471	.00
223471	.00

ISSUED FOR:

BID SET

5/16/2024

REVISION FOR:		
NO.	DESCRIPTION	
1	Addendum #3	


DATE 6/18/2024

DRAWN BY	CRR
CHECKED BY	JDR

PARTIAL ENLARGED UNDERFLOOR PLAN -PLUMBING



PROJECT NORTH

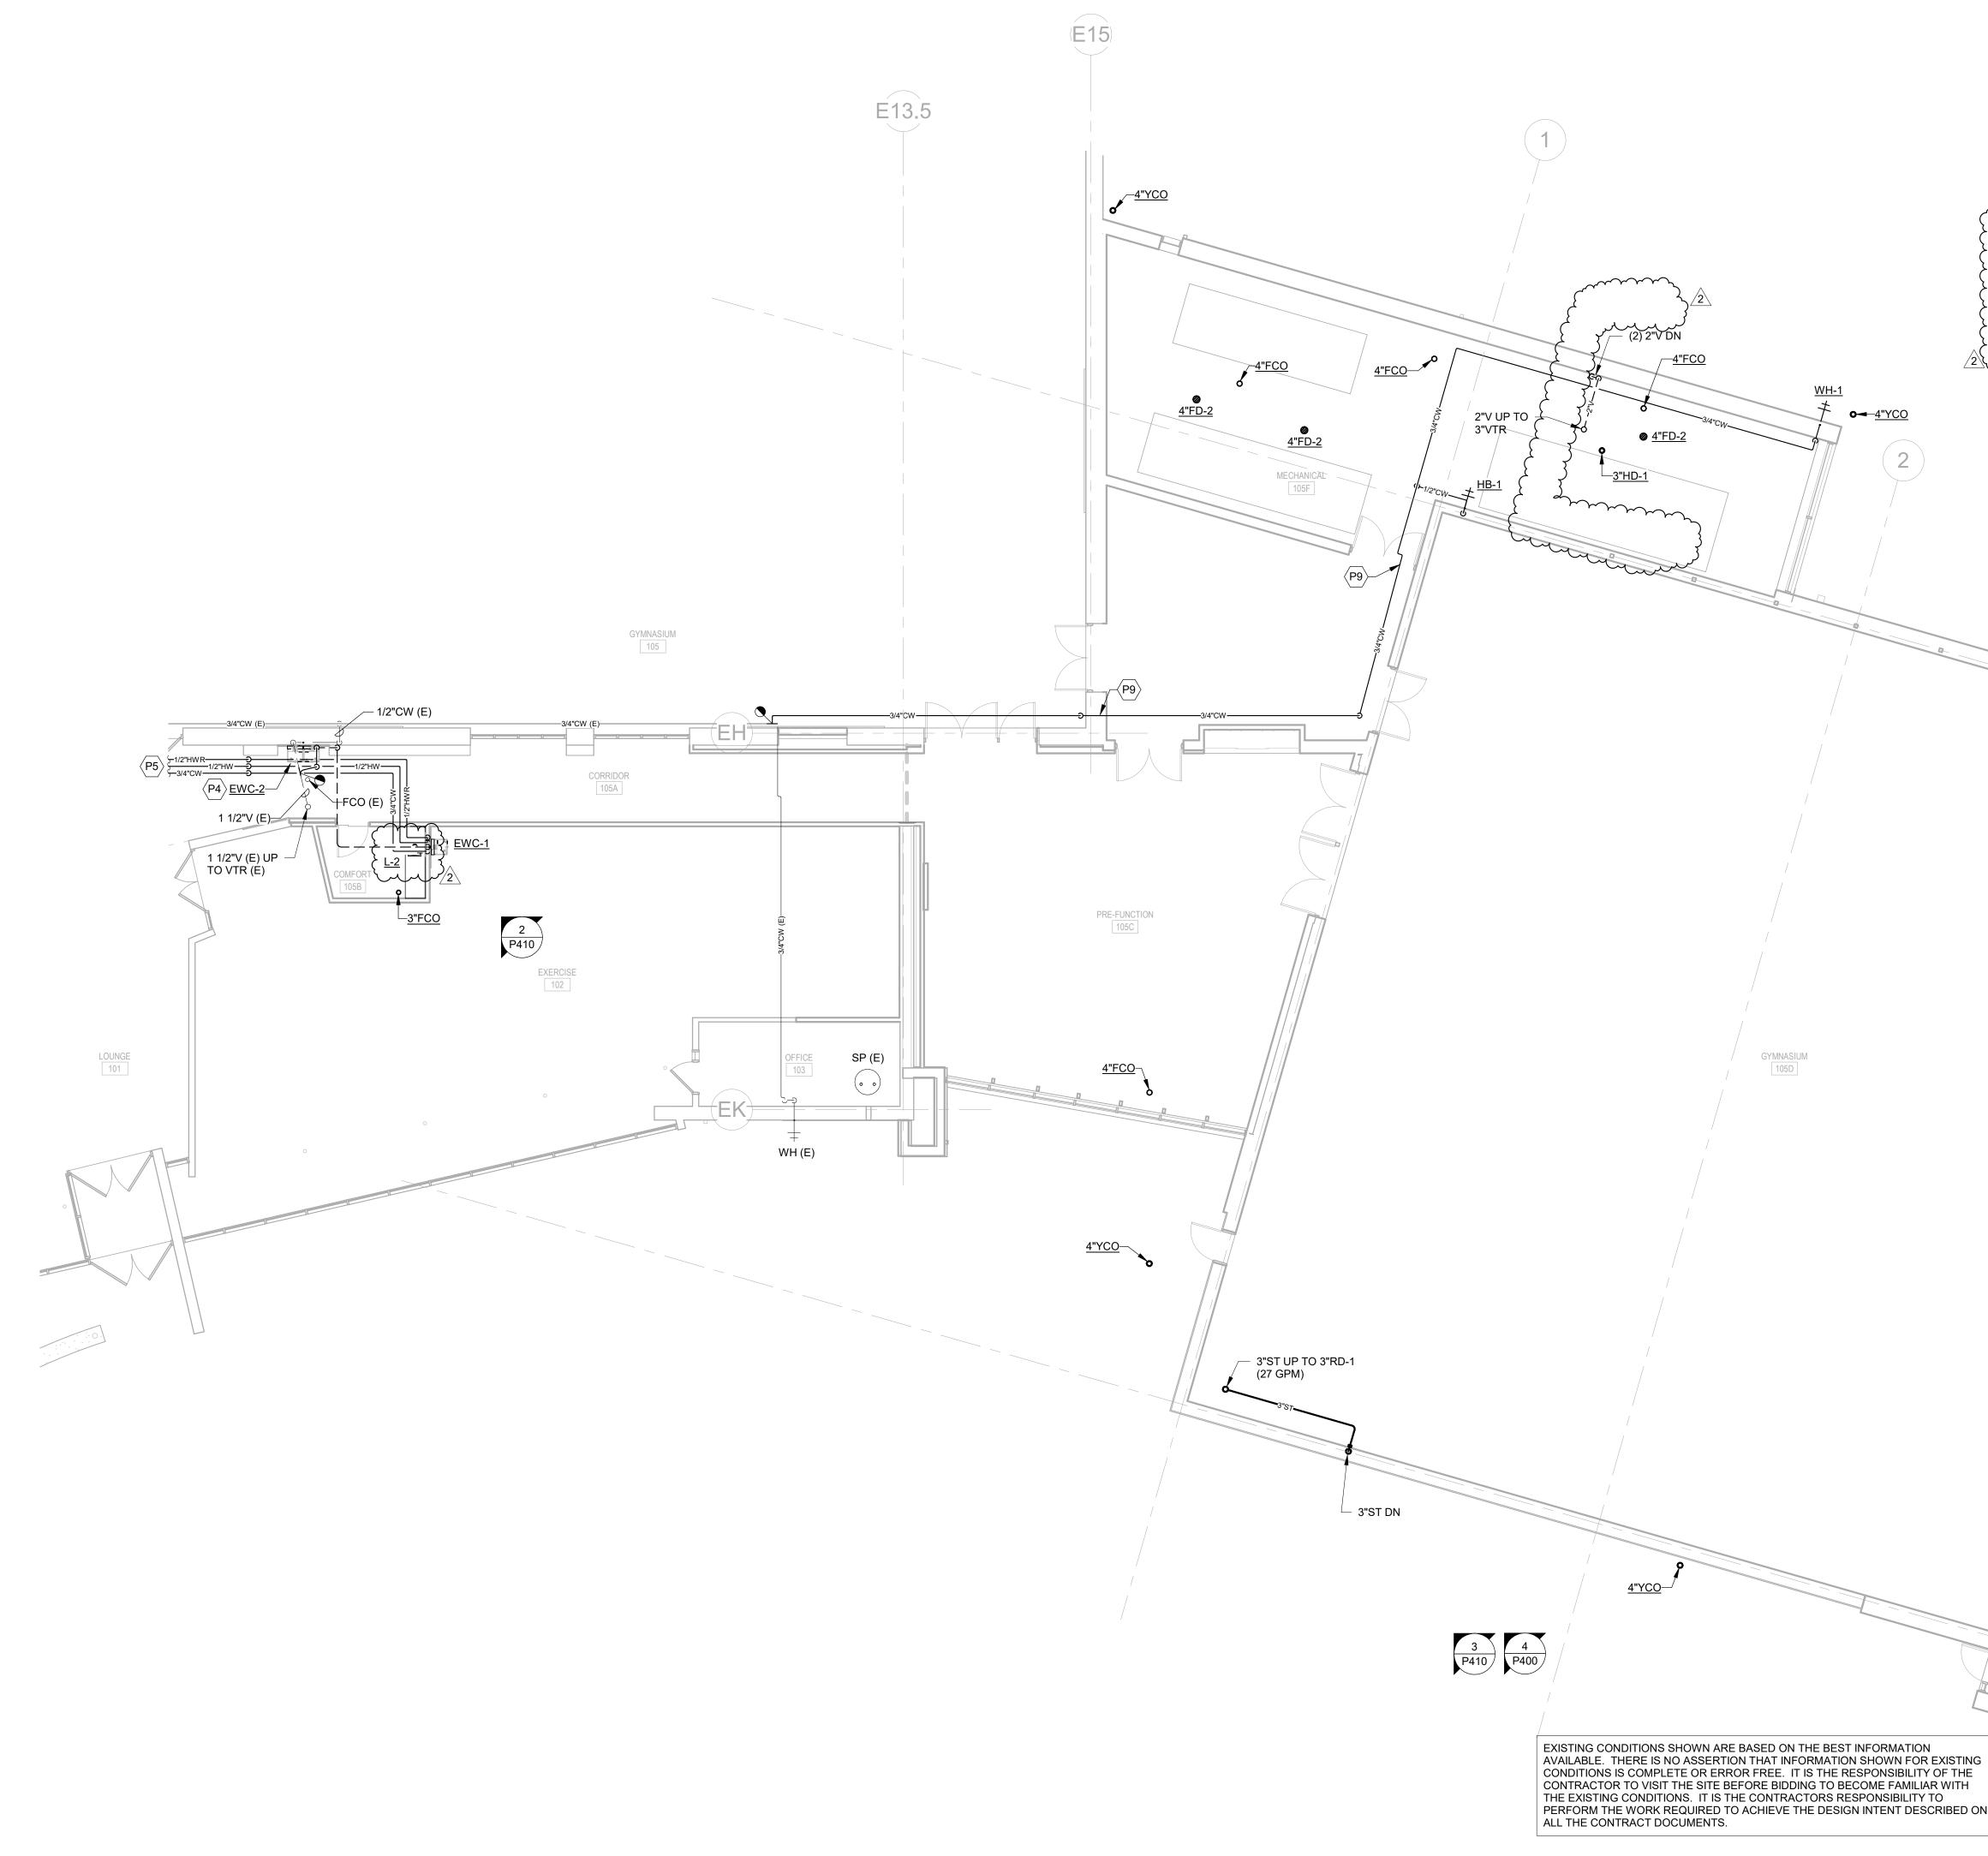

GENERAL NOTES:

- 1. PC SHALL VISIT SITE AND BECOME FAMILIAR WITH EXISTING CONDITIONS PRIOR TO CONSTRUCTION. PC SHALL FIELD VERIFY ALL EXISTING CONDITIONS AND REPORT ANY DISCREPANCIES TO THE A/E PRIOR TO COMMENCING WORK.
- 2. PC SHALL MAINTAIN AND PROTECT ALL EXISTING PIPING AND FIXTURES THAT ARE TO REMAIN DURING CONSTRUCTION.
- 3. IF A DEAD END IS CREATED IN THE REMOVAL OF ANY PART OF A DRAIN SYSTEM, ALL OPENINGS IN THE DRAIN SHALL BE PROPERLY SEALED.
- 4. THE PLUMBING CONTRACTOR SHALL FIELD VERIFY NO DEAD ENDS IN DRAINAGE OR WATER DISTRIBUTION SYSTEM EXCEEDING A DEVELOPED LENGTH OF MORE THAN TWO FEET (2') REMAIN.
- \cdots KEYED NOTES
- (KEYED NOTES PER PROJECT)
- P4 INSTALL NEW ELECTRIC WATER COOLER, AND CONNECT TO EXISTING SANITARY, VENT, AND COLD WATER PIPING.
- P5 REFER TO 2/P301 FOR CONTINUATION.
- P9 REFER TO DETAIL 6/P901 FOR SOUND ATTENUATION PIPE SLEEVE DETAIL.

o⊸–<u>4"YCO</u>



MILWAUKEE | MADISON | CHICAGO



ENGINEERING, INC. 5525 NOBEL DRIVE SUITE 110 MADISON, WI 53711 PH: 608.277.1728 FAX: 608.271.7046 JDR PROJECT NO: 23.0319

WARNER PARK COMMUNITY RECREATION CENTER EXPANSION

1625 NORTHPORT DRIVE MADISON, WI 53704

CITY OF MADISON PARKS DIVISION 330 EAST LAKESIDE STREET MADISON, WI 53715

PROJECT NUMBER

3

В

<u>4"YCO</u>-

223471.00


ISSUE	ED FOR:	
BID	SET	5/16/202
REVIS	SION FOR:	
NO.	DESCRIPTION	DATE
1	Addendum #2	6/14/2024
2	Addendum #3	6/18/2024


DRAWN BY	CRR
CHECKED BY	JDR

PARTIAL ENLARGED FIRST FLOOR PLAN – PLUMBING

P203

PROJECT NORTH

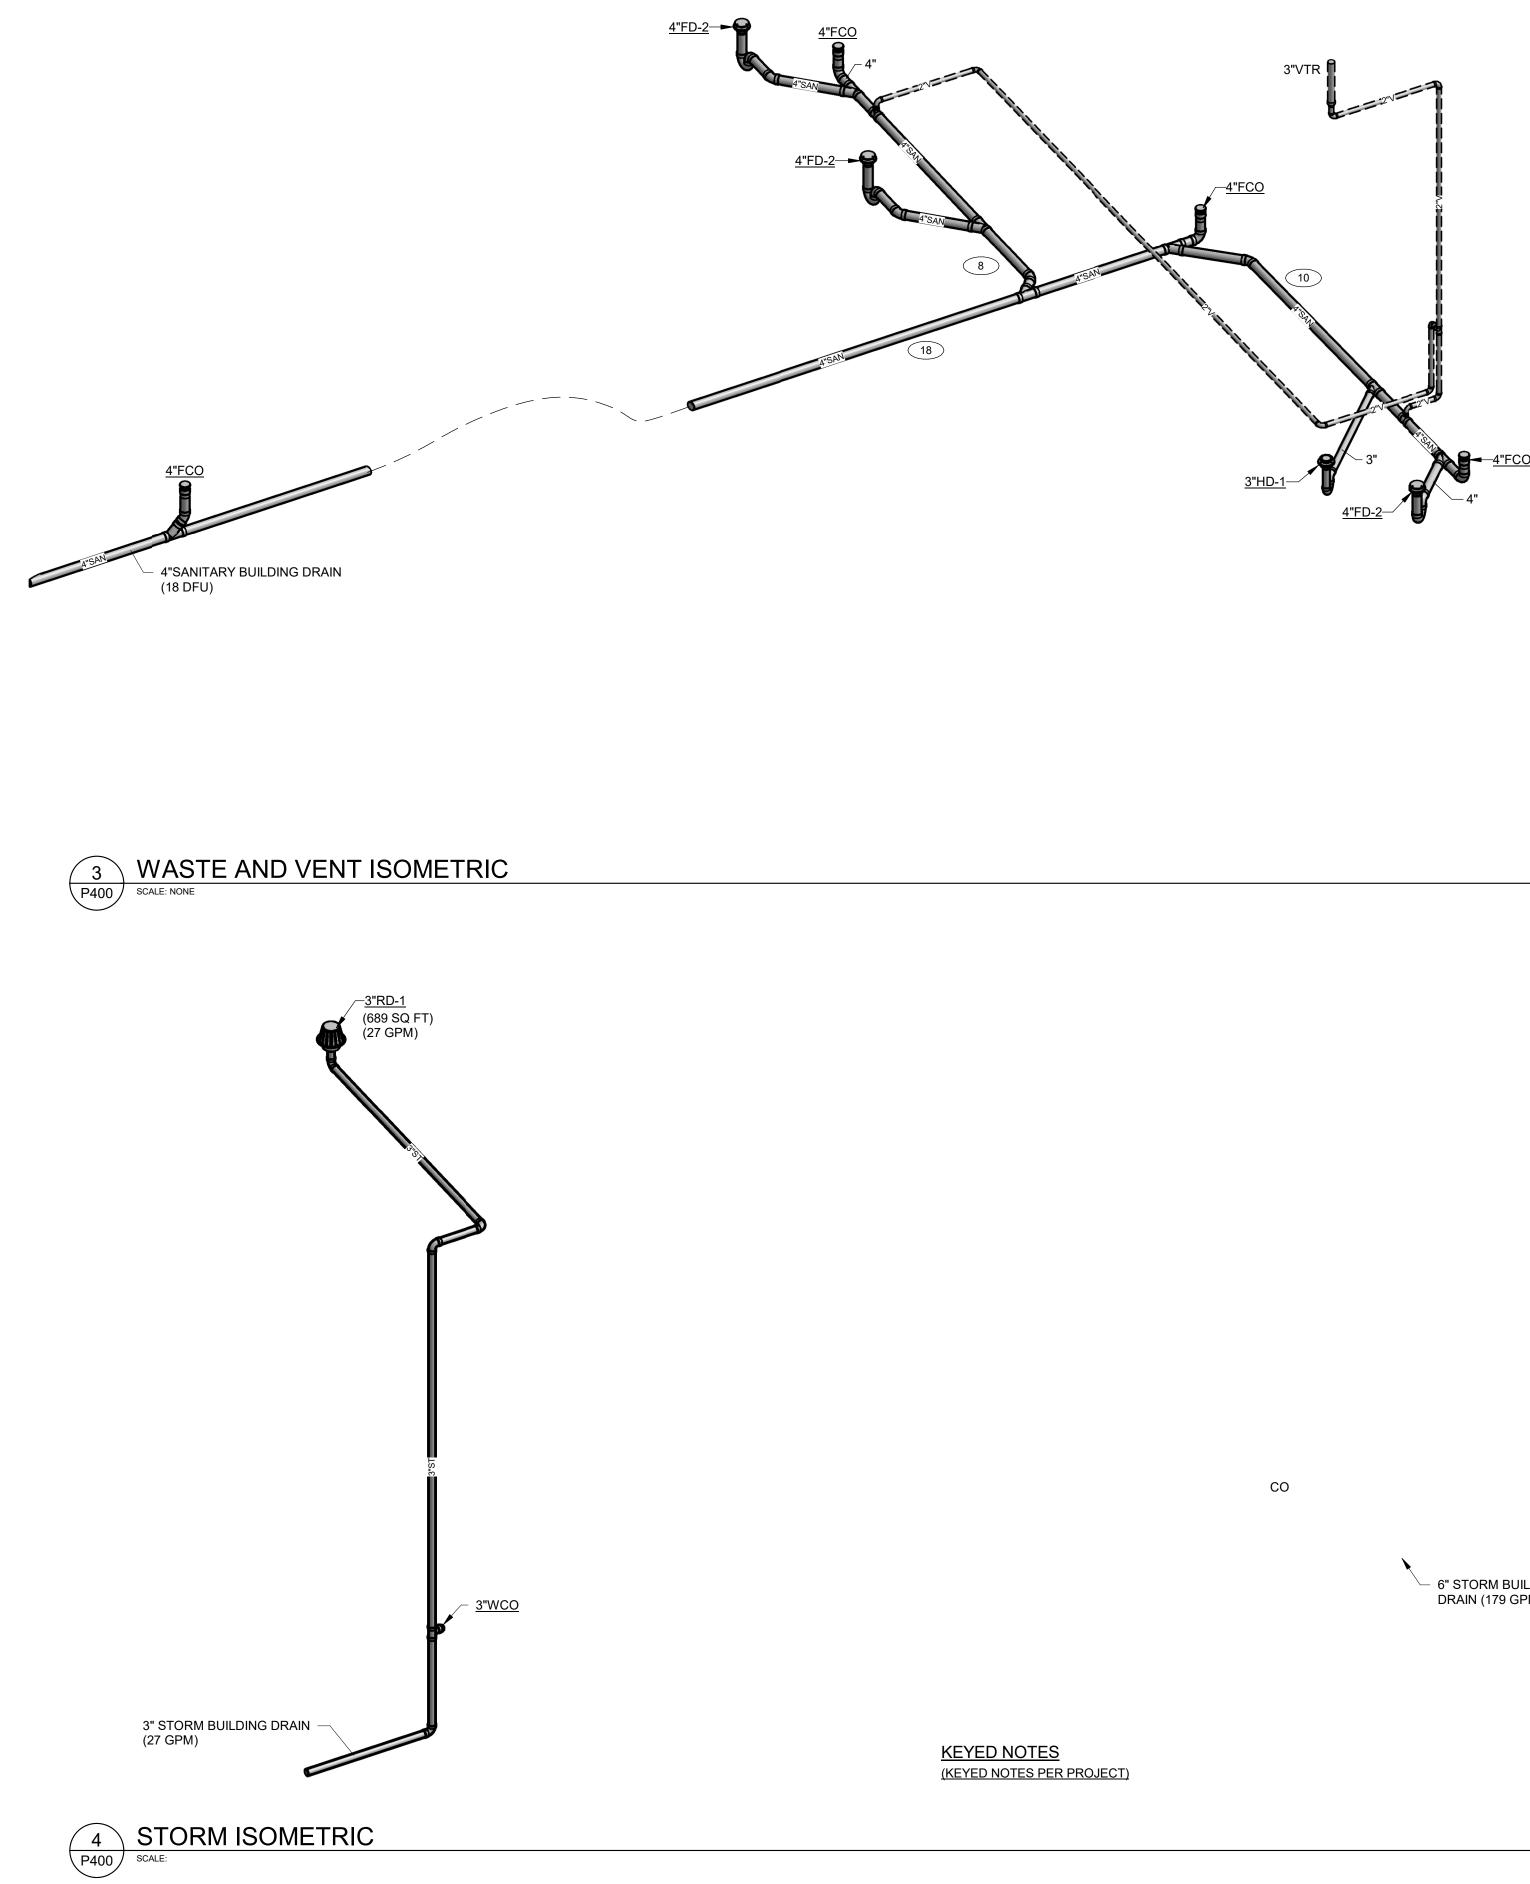

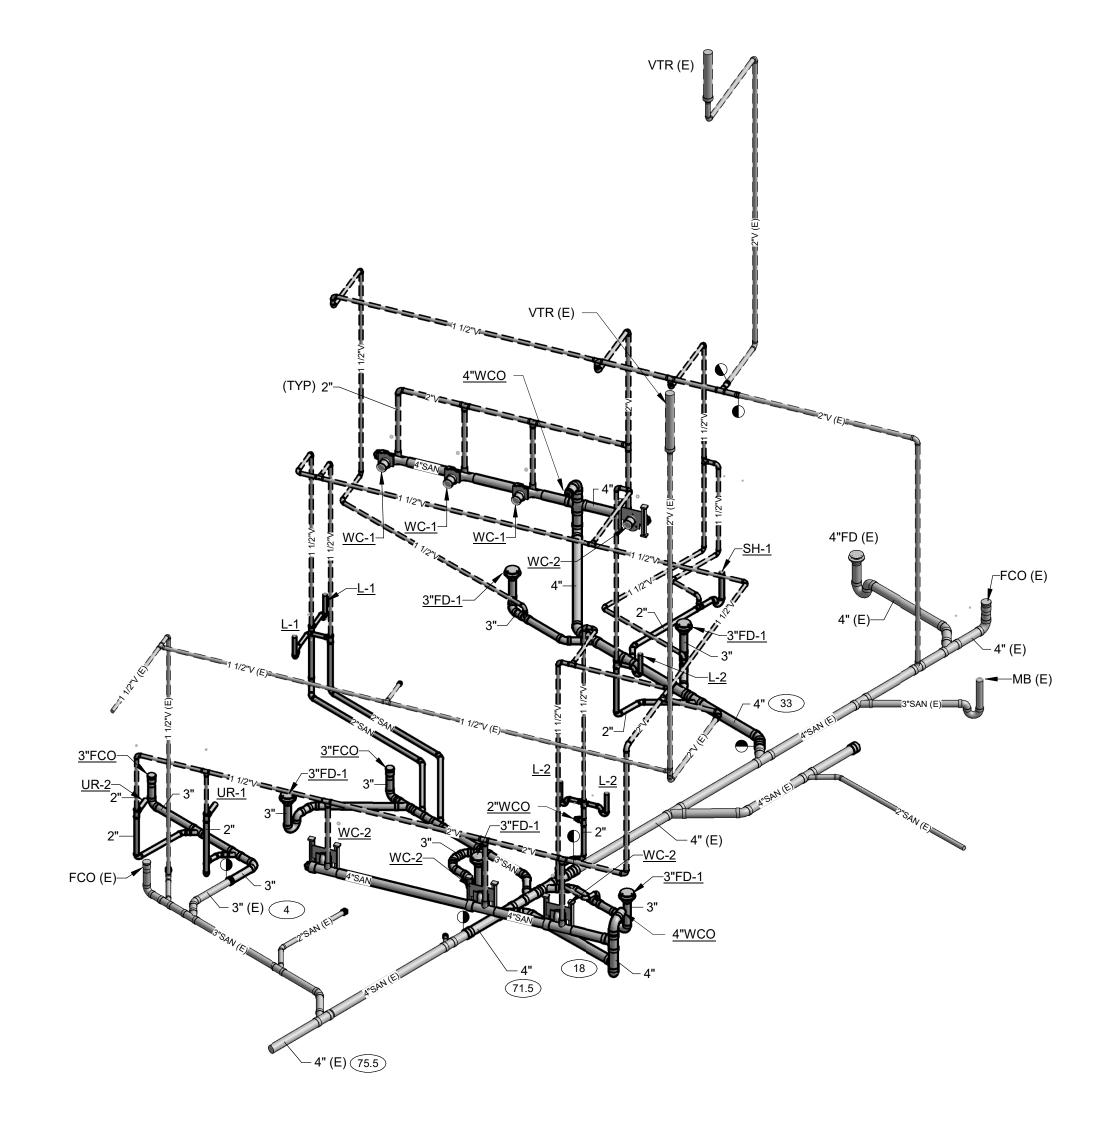

1 WASTE AND VENT ISOMETRIC P400 SCALE: NONE

— 6" STORM BUILDING DRAIN (179 GPM)





MILWAUKEE | MADISON | CHICAGO



ENGINEERING, INC. 5525 NOBEL DRIVE SUITE 110 MADISON, WI 53711 PH: 608.277.1728 FAX: 608.271.7046 JDR PROJECT NO: 23.0319

WARNER PARK COMMUNITY RECREATION CENTER EXPANSION

1625 NORTHPORT DRIVE MADISON, WI 53704 CITY OF MADISON PARKS DIVISION 330 EAST LAKESIDE STREET MADISON, WI 53715

PROJECT NUMBER


223471.00


ISSUED FOR:	
BID SET	5/16/2024
REVISION FOR:	
NO. DESCRIPTION	DATE
1 Addendum #3	6/18/2024




SANITARY WASTE, VENT & STORM ISOMETRIC -PLUMBING



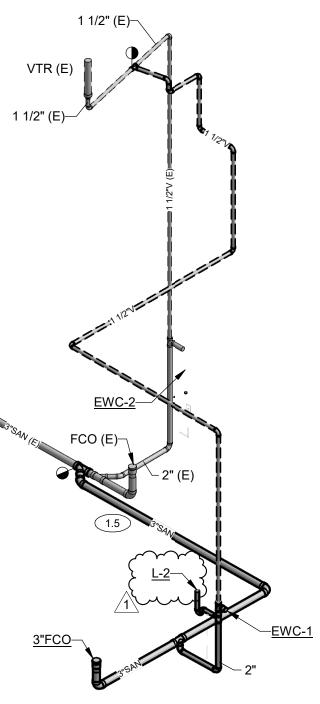


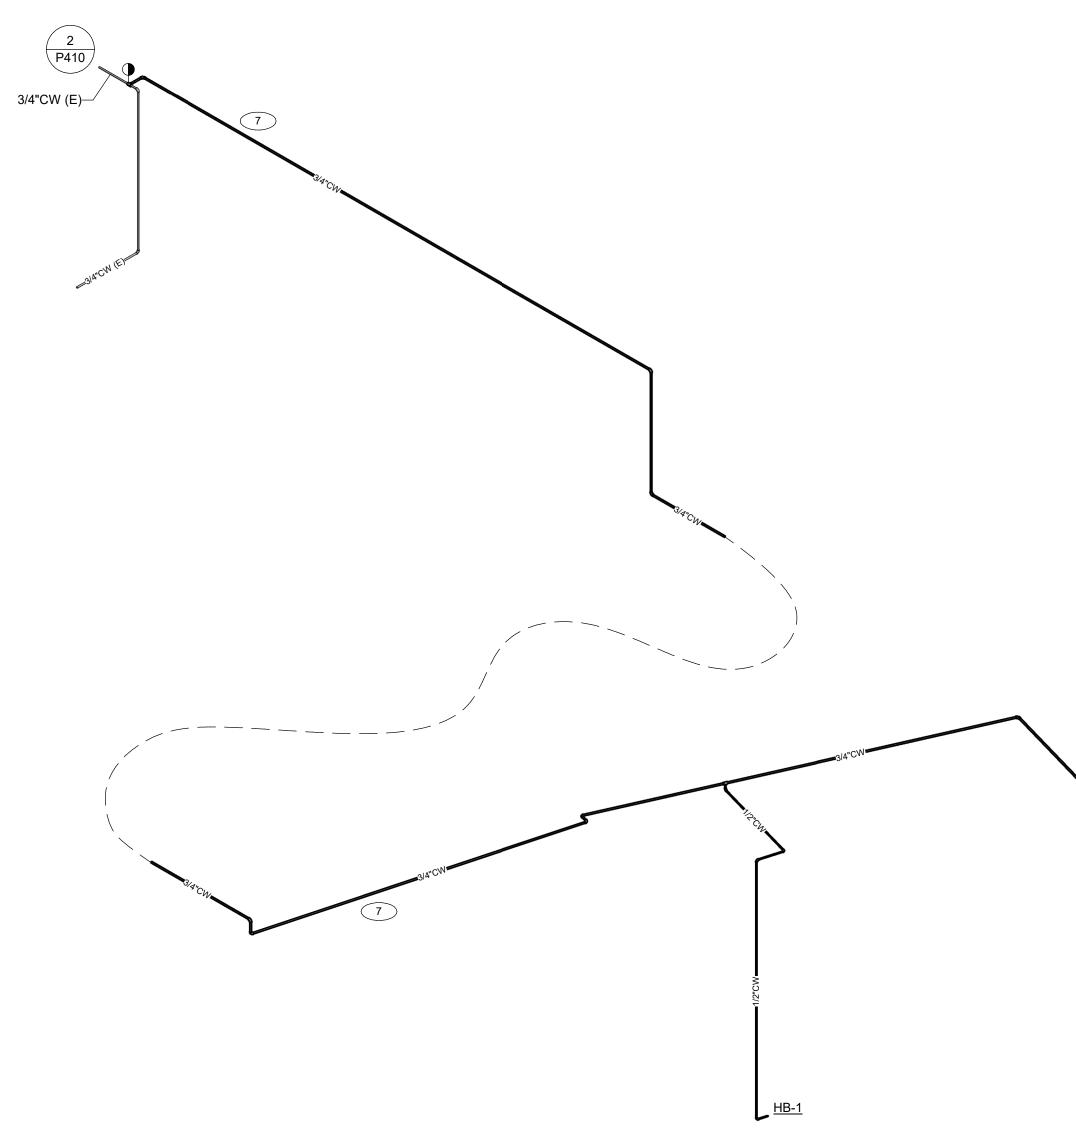


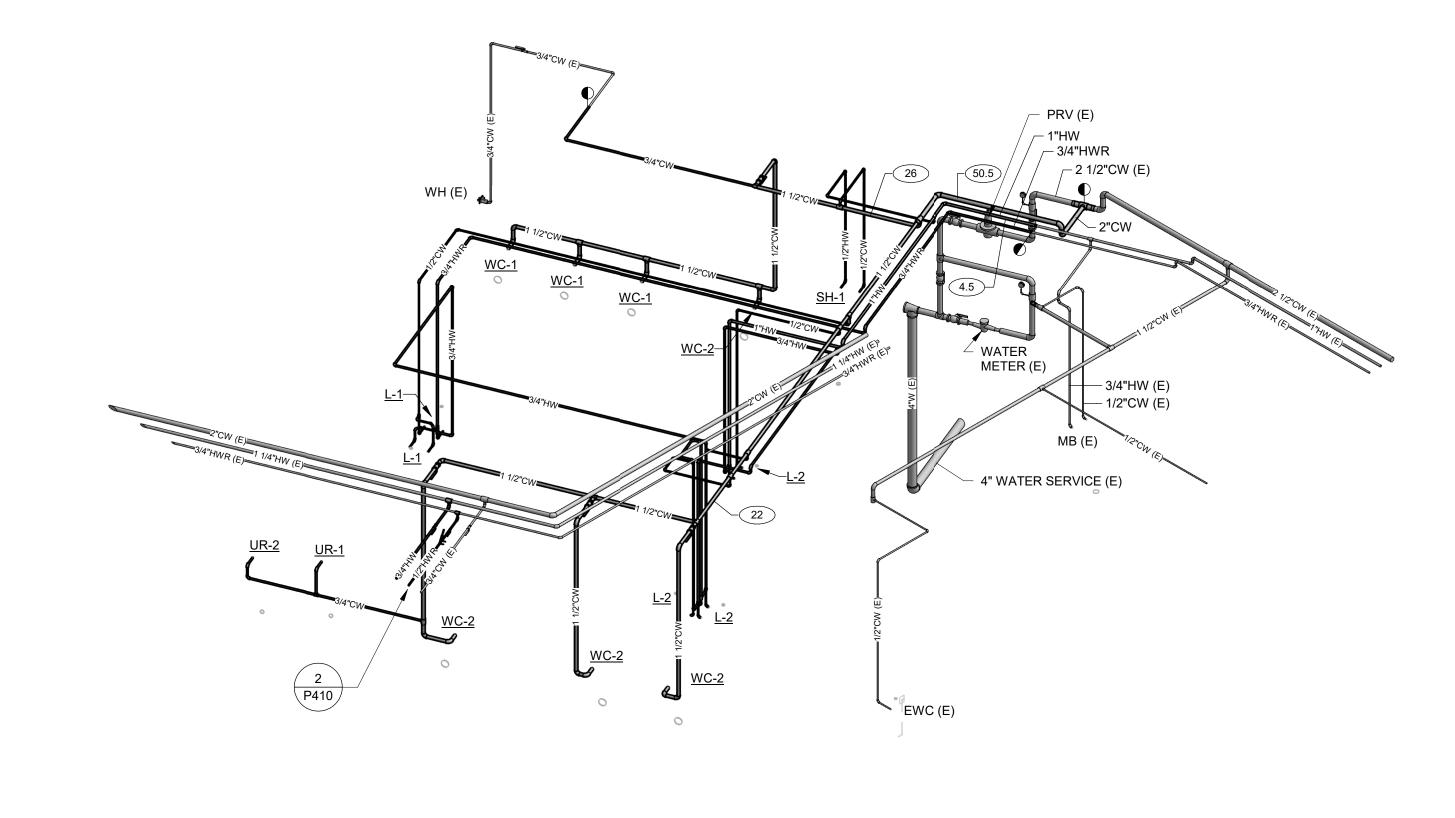



1 DOMESTIC WATER ISOMETRIC P410 SCALE: NONE

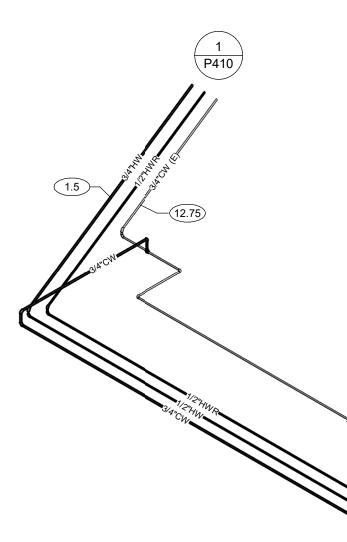

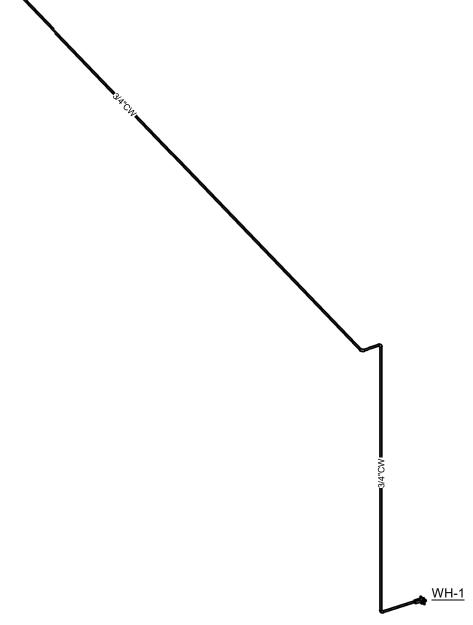

2 DOMESTIC WATER ISOMETRIC P410 SCALE: NONE



MILWAUKEE | MADISON | CHICAGO



ENGINEERING, INC. 5525 NOBEL DRIVE SUITE 110 MADISON, WI 53711 PH: 608.277.1728 FAX: 608.271.7046 JDR PROJECT NO: 23.0319


WARNER PARK COMMUNITY RECREATION CENTER EXPANSION

1625 NORTHPORT DRIVE MADISON, WI 53704 CITY OF MADISON PARKS DIVISION 330 EAST LAKESIDE STREET MADISON, WI 53715

PROJECT NUMBER

223471.00

ISSUE	D FOR:	
BID S	SET	5/16/2024
REVIS	ION FOR:	
NO.	DESCRIPTION	DATE
1	Addendum #3	6/18/2024

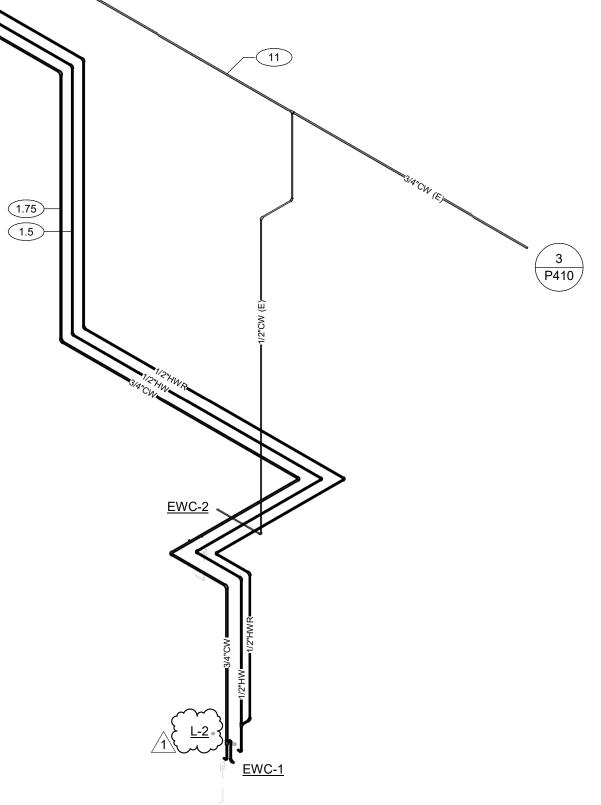

Author


Checker

DRAWN BY


CHECKED BY

DOMESTIC WATER ISOMETRIC - PLUMBING



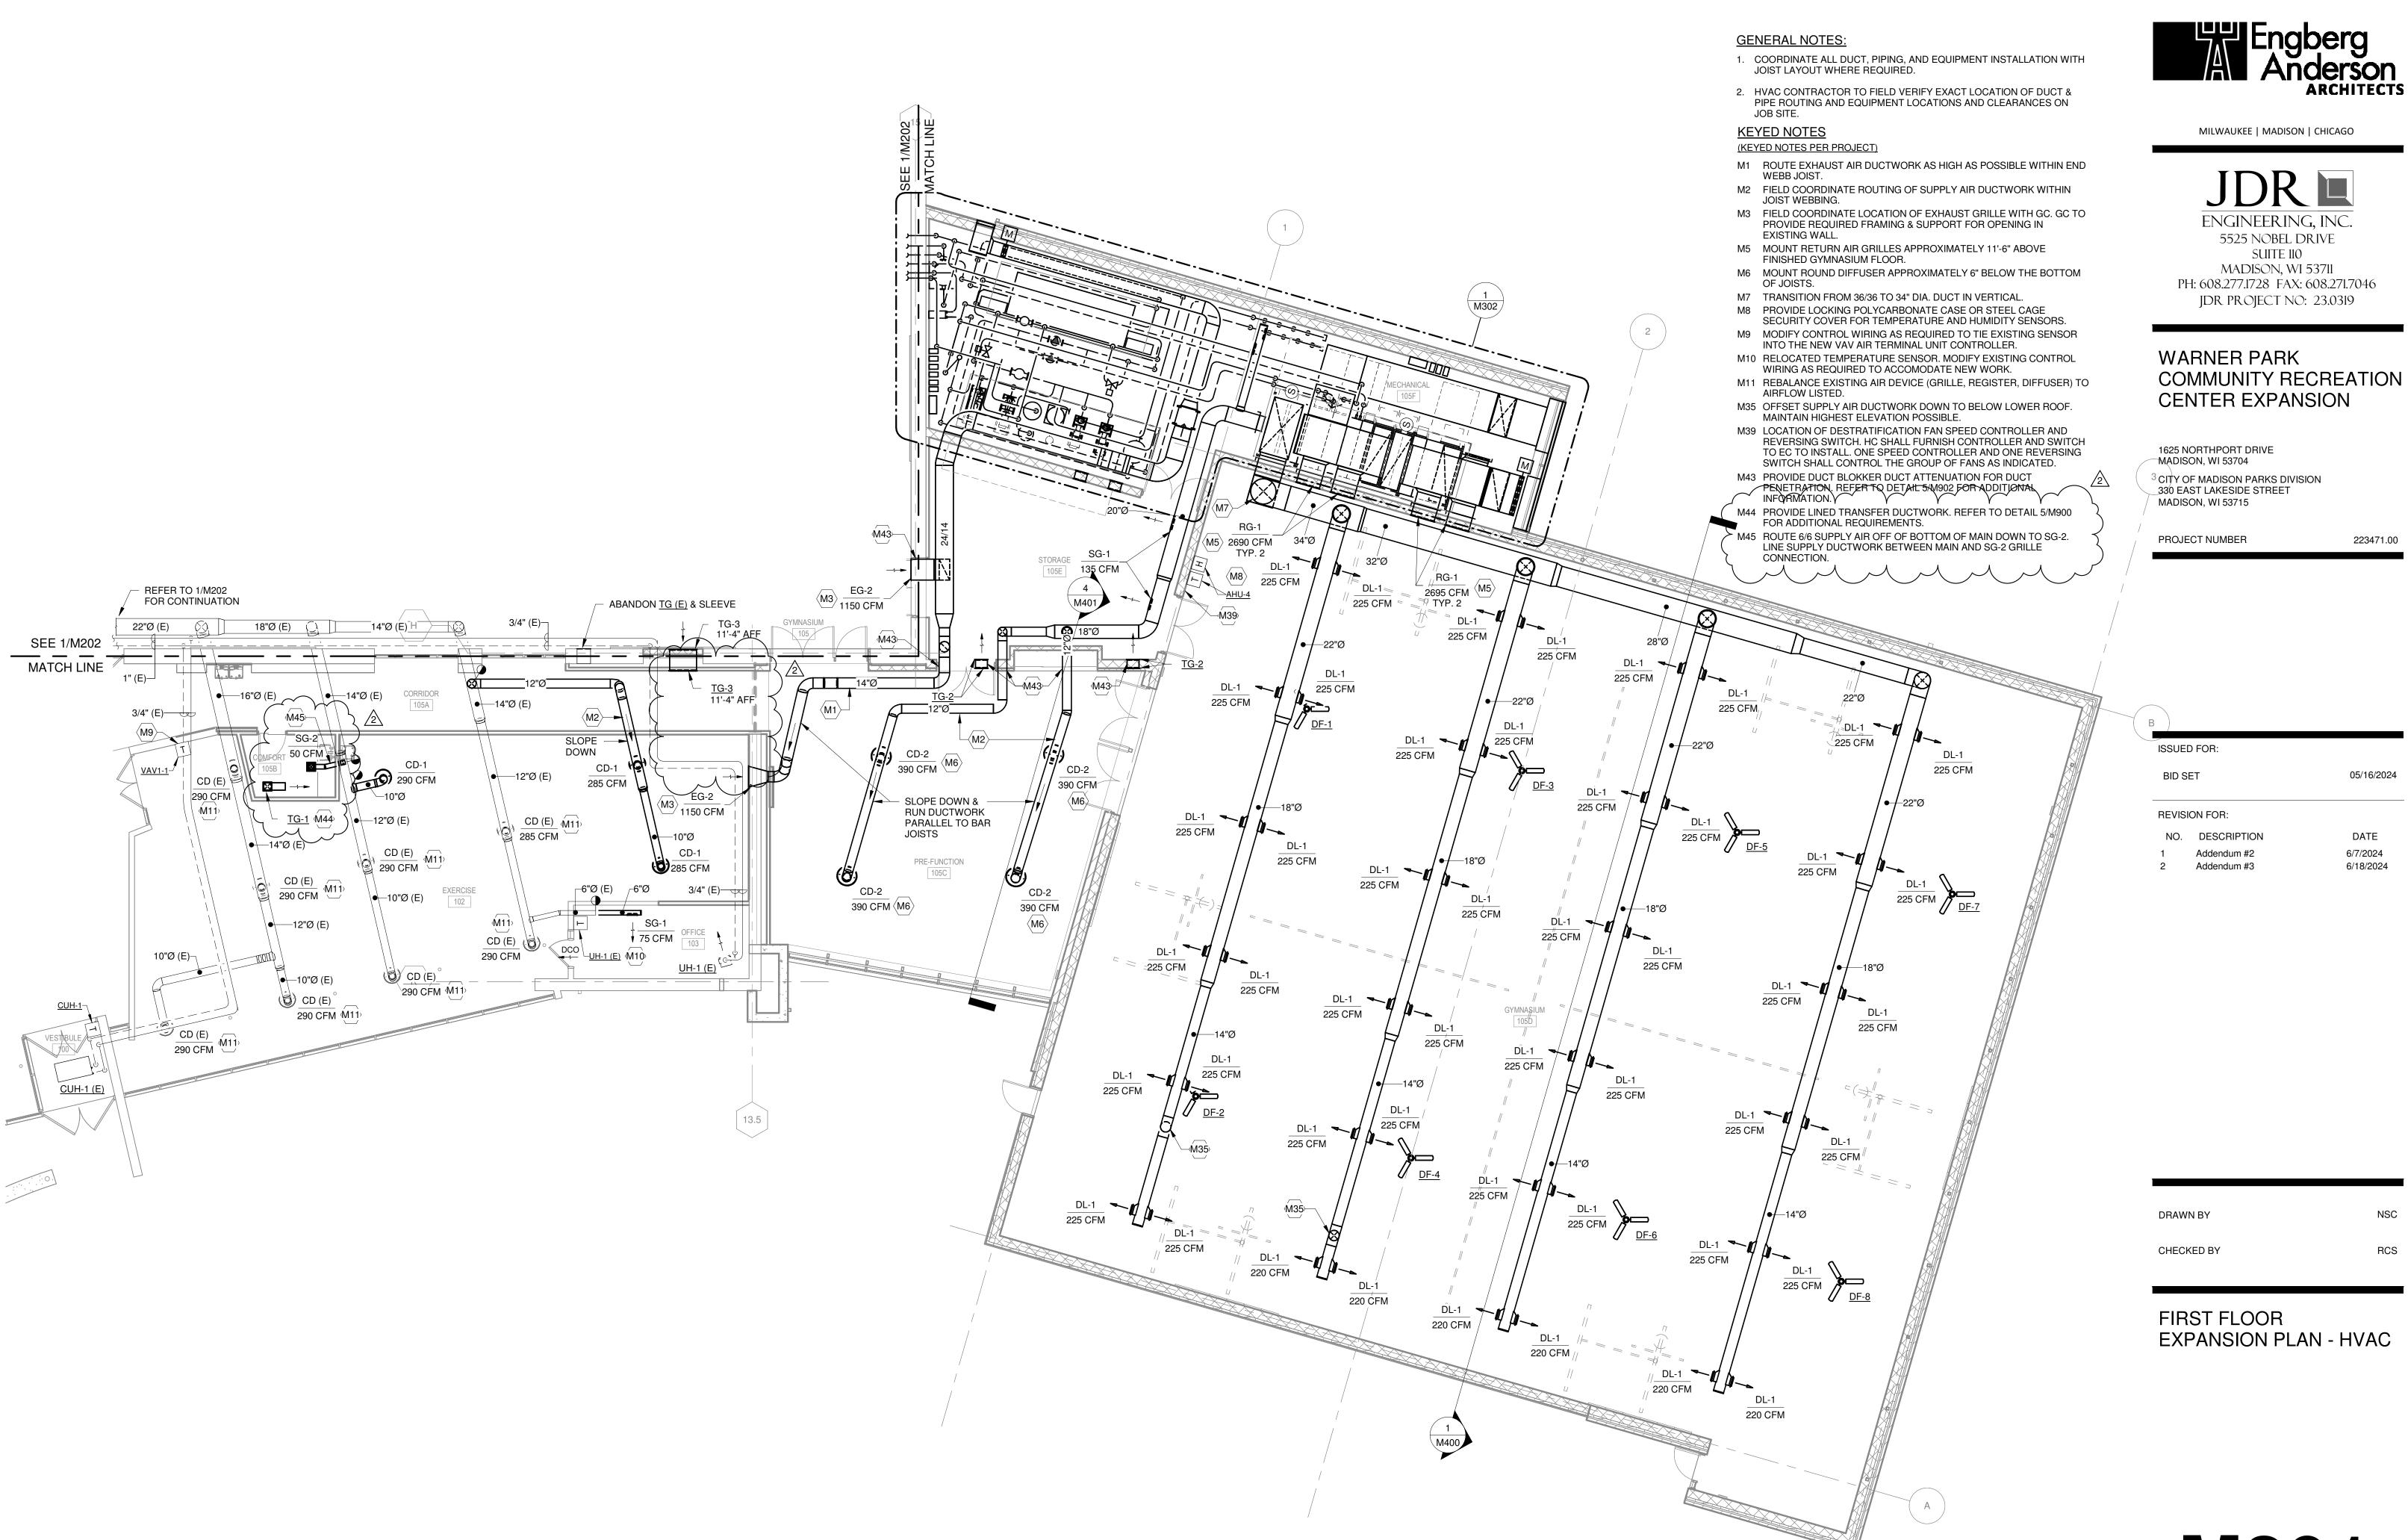

PROJECT NORTH M201

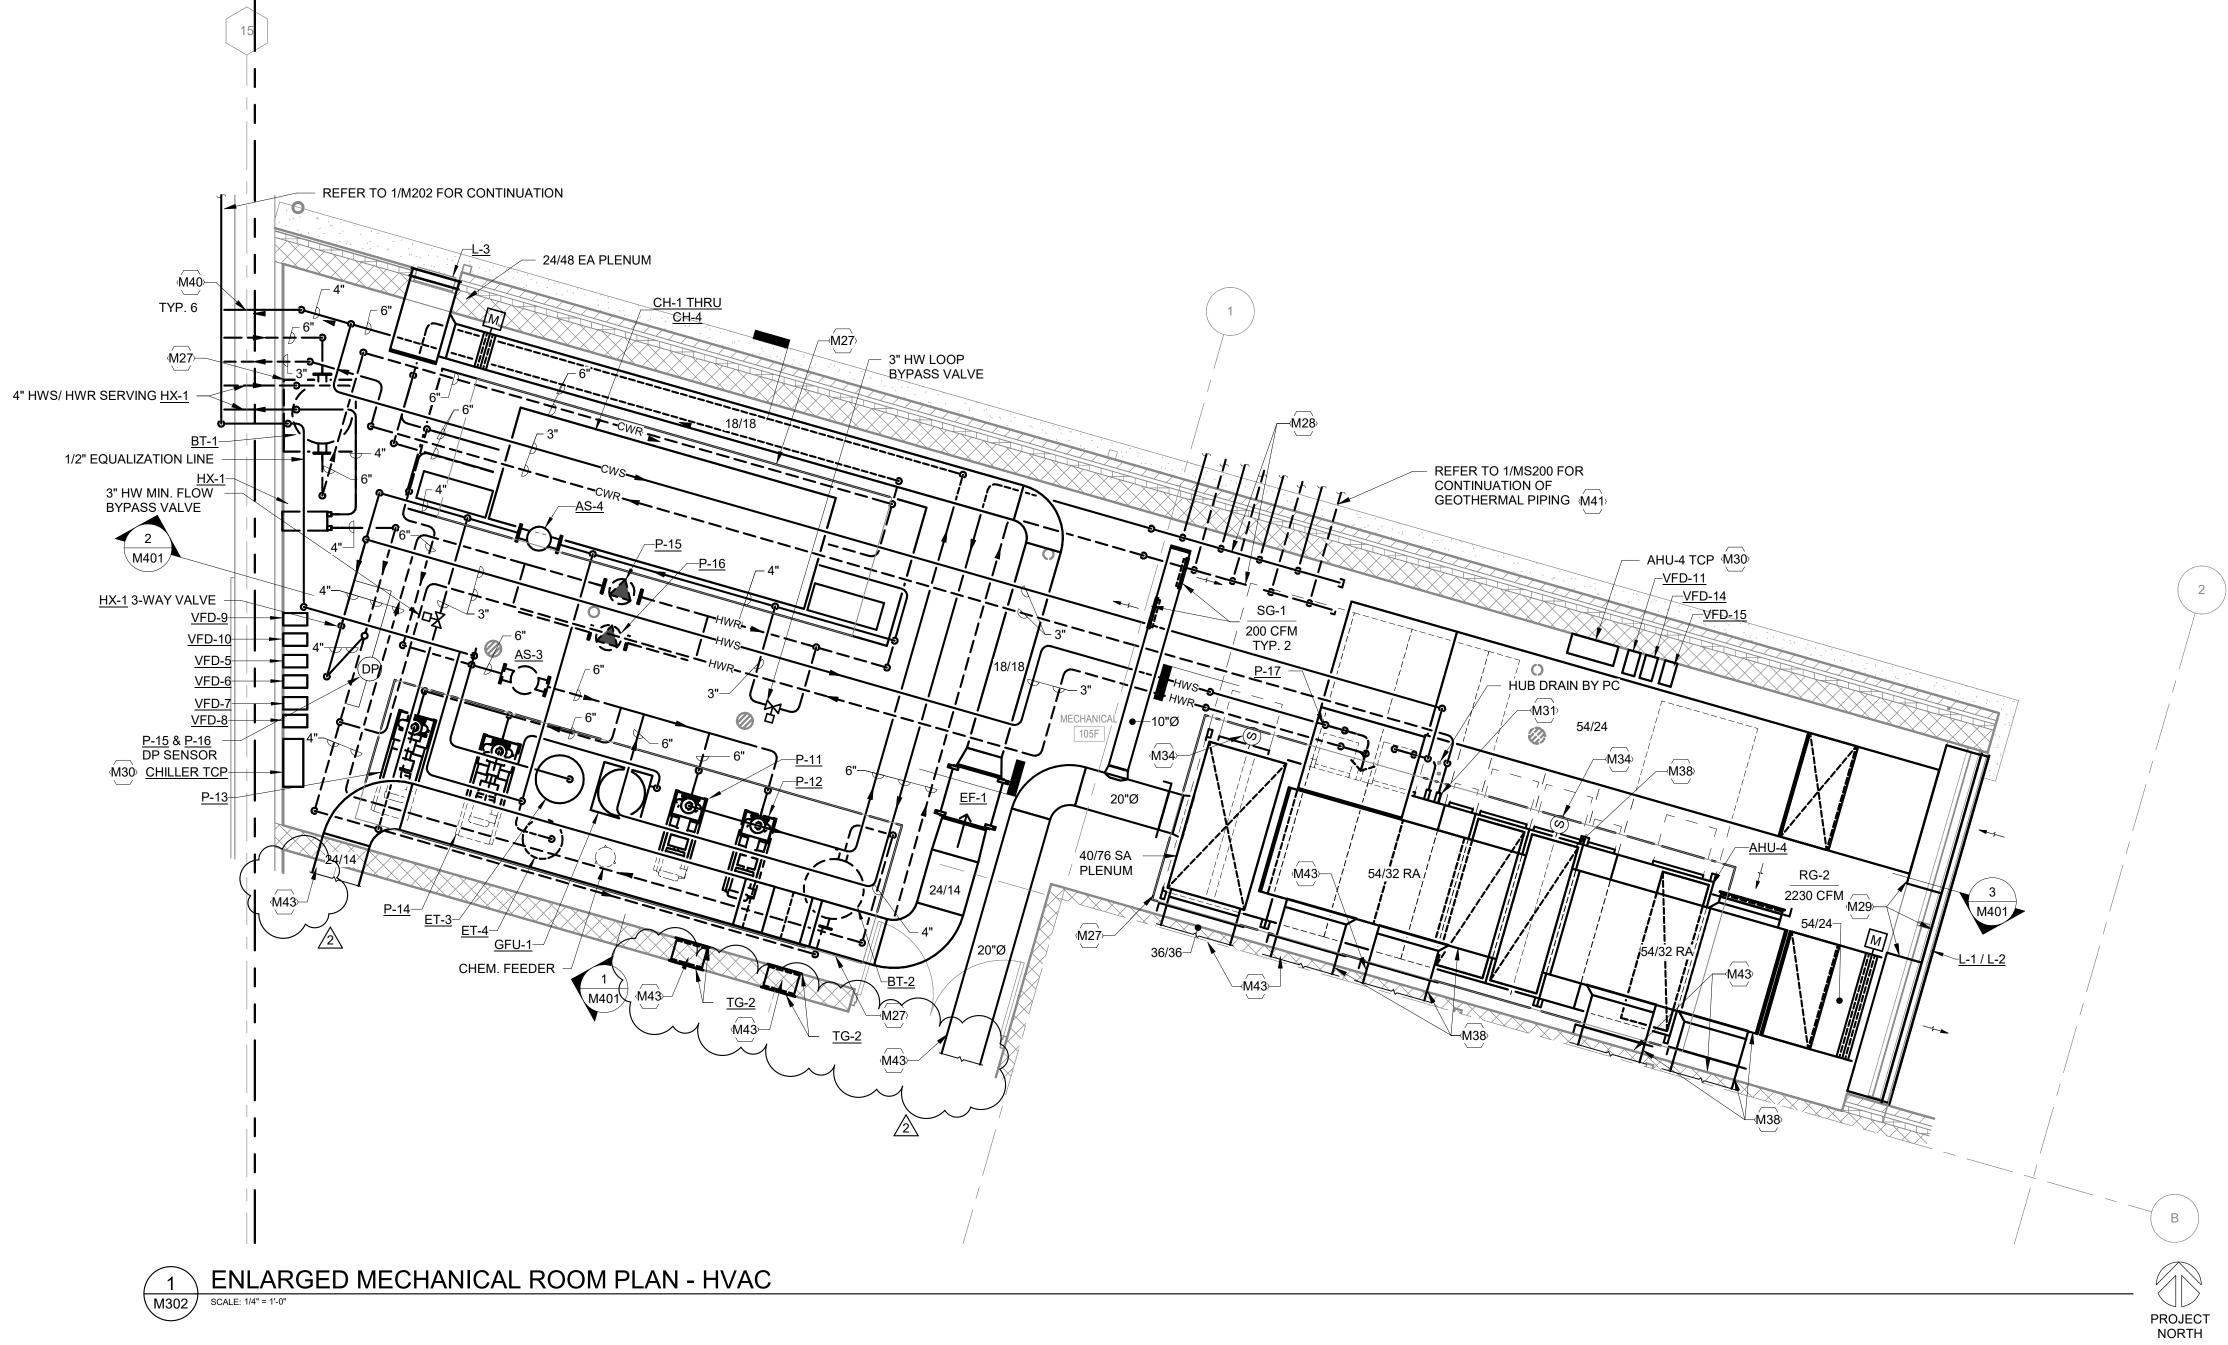

CHILLER DEMOLITION & REPLACEMENT NOTES:

- 1. HVAC CONTRACTOR SHALL PHASE THE DEMOLITION OF THE EXISTING CHILLER AND CHILLED WATER PLANT WITH THE INSTALLATION OF THE NEW HEAT RECOVERY CHILLER PLANT. EXISTING CHILLER AND CHILLED WATER PLANT SHALL REMAIN OPERATIONAL TO LIMIT DOWNTIME OF COOLING TO THE FACILITY.
- GENERAL NOTES:
- 1. COORDINATE ALL DUCT, PIPING, AND EQUIPMENT INSTALLATION WITH JOIST LAYOUT WHERE REQUIRED.
- 2. HVAC CONTRACTOR TO FIELD VERIFY EXACT LOCATION OF DUCT & PIPE ROUTING AND EQUIPMENT LOCATIONS AND CLEARANCES ON JOB SITE.

KEYED NOTES

(KEYED NOTES PER PROJECT)

- M27 4" CONCRETE EQUIPMENT PAD BY GC. HC TO COORDINATE SIZE AND LOCATION.
- M28 6" GEOTHERMAL BOREFIELD MANIFOLDS. REFER TO DETAIL 3/M902 FOR ADDITIONAL REQUIREMENTS. M29 PROVIDE 72/76 INSULATED PLENUM FOR OUTSIDE AIR INTAKE, 72/76
- INSULATED PLENUM FOR RELIEF AIR, AND PROVIDE INSULATED BLANK-OFF PANELS FOR UN-USED PORTIONS OF LOUVER. M30 COORDINATE WITH EC TO PROVIDE 120/1 POWER AND DATA CONNECTION TO TEMPERATURE CONTROL PANEL.
- M31 PROVIDE CONDENSATE LOOP SEAL AND ROUTE CONDENSATE TO HUB DRAIN. CONDENSATE PIPE SIZE SHALL NOT BE SMALLER THAN UNIT CONNECTION SIZE. HUB DRAIN BY PC.
- M34 DUCT MOUNTED SMOKE DETECTOR BY EC.
- M38 LINE ALL RETURN AIR DUCTWORK ASSOCIATED WITH AHU-4. DUCT SIZES SHOWN ARE INSIDE DUCT DIMENSIONS. M40 PROVIDE PIPE BLOKKER PIPE ATTENUATION FOR PIPE
- PENETRATION. REFER TO DETAIL 5/M902 FOR ADDITIONAL INFORMATION.
- M41 FIELD COORINATE GEOTHERMAL FIELD PIPING WITH STORM PIPING. REFER TO CIVIL PLANS FOR ADDITIONAL INFORMATION.
- M43 PROVIDE DUCT BLOKKER DUCT ATTENUATION FOR DUCT PENETRATION. REFER TO DETAIL 5/M902 FOR ADDITIONAL INFORMATION.



MILWAUKEE | MADISON | CHICAGO



ENGINEERING, INC. 5525 NOBEL DRIVE SUITE 110 MADISON, WI 53711 PH: 608.277.1728 FAX: 608.271.7046 JDR PROJECT NO: 23.0319

WARNER PARK COMMUNITY RECREATION CENTER EXPANSION

1625 NORTHPORT DRIVE MADISON, WI 53704

CITY OF MADISON PARKS DIVISION 330 EAST LAKESIDE STREET MADISON, WI 53715

PROJECT NUMBER

223471.00

ISSUE	D FOR:	
BID S	SET	05/16/2024
REVIS	ION FOR:	
NO.	DESCRIPTION	DATE
1	Addendum #2	6/7/2024
2	Addendum #3	6/18/2024

DRAWN BY	NSC
CHECKED BY	RCS


ENLARGED MECHANICAL **ROOM PLAN - HVAC**



KEYED NOTES

(KEYED NOTES PER PROJECT)

- P1 LOCATE INVERTERS FOR ROOF MOUNTED PV ARRAY AT THIS LOCATION.
- P2 PROVIDE AND INSTALL NEW 208Y/120V, 600A PANEL 'K'. P3 PROVIDE AND INSTALL DUAL CONTROLLED RECEPTACLE EQUAL TO LEGRAND #WRC-20-2. PROVIDE CEILING MOUNTED RF TRANSMITTER EQUAL TO LEGRAND #WRC-TX-LM. PROVIDE ROOM
- CONTROLLERS AS REQUIRED. P4 COORDINATE HEIGHT OF POWER AND DATA FOR SCREEN WITH ARCHITECT.
- P5 LOCATION OF DESTRATIFICATION FAN SPEED CONTROLLER AND REVERSING SWITCH. HC SHALL
- FURNISH CONTROLLER AND SWITCH TO EC TO INSTALL. REFER TO M201 FOR MORE DETAILS. P6 PROVIDE SOUND ATTENUATION AS REQUIRED AT ANY/ALL WALL PENETRATIONS. REFER TO 10/E900
- FOR MORE DETAIL.
- S1 MOUNT SMOKE DETECTOR ABOVE PERFERATED CEILING. S2 FOR CONNECTION OF TELECOM ROOMS, RUN TWELVE STRAND SINGLE MODE FIBER FROM STORAGE (TR ROOM) 123 TO STORAGE (TR ROOM) 105E. TERMINATE WITH LC CONNECTORS ON CABINET MOUNTED PATCH PANEL IN EACH TR. PROVIDE 12 LC TO LC PATCH CABLES.
- S3 PROVIDE AND INSTALL NEW LOCKING IT CABINET EQUAL TO HUBBELL #HSQ4836. S4 EXTEND EXISTING PAGING FEEDS THROUGH OVERHEAD CONDUIT SYSTEM TO THIS LOCATION. CONTRACTOR SHALL CUT EXISTING UNDERGROUND FEED AND SPLICE TO NEW OVERHEAD CONDUIT SYSTEM
- S5 PROVIDE AND INSTALL (2) 2" CONDUITS ROUTED FROM STORAGE (TR ROOM) 123 TO STORAGE (TR ROOM) 105E. PROVIDE JUNCTION BOXES ABOVE CEILING IN WORK ROOM 115 AND IN GYMNASIUM 105 APPROXIMATELY AS SHOWN. CONDUITS SHALL BE PAINTED TO MATCH EXISTING , GEILING/UTHITIES COLOR WHEN ROUTED THROUGH SPACE(S) WITH NO CEILINGS.
- S8 APPROXIMATELY SHOWN ON THE PLANS, WITH EQUIPMENT LISTED BELOW AT A MINIMUM. COORDINATE ANY/ALL REQUIREMENTS WITH KYLE SYDOW AT DAKTRONICS AT (312) 339-3944 or kyle.sydow@daktronics.com. TWO(2) #LVN-2010-3.9MN VIDEO DISPLAY WITH TOP IDENTIFIER, ONE(1) #BB-2107 SCORING DISPLAY, ONE(1) RACK WITH SCOREBOARD CONTROL SYSTEM (IN STORAGE #105E), CONTROL SOFTWARE (LAPTOP/PC BY OWNER.), ANY/ALL POWER, CONNECTIONS, FIBER, CAT6, ETC. FOR A COMPLETE AND OPERATIONAL SYSTEM, PROVIDE RACEWAYS BETWEEN EQUIPMENT AND RACKS AS REQUIRED BY DAKTRONICS. SMALLER VIDEO BOARD MATRIX SIZE TO BE: LVN-2010-3.9MN-512X896. LARGER VIDEO BOARD MATRIX SIZE TO BE: LVN-2010-3.9MN-512X1152.
- SUBWOOFERS, TWO(2) #SPH2L-SS-06 ROPES, ONE(1) CROWN 475W DSP AMPLIFIER WITH POWER CONDITIONER AND RACK AS REQUIRED (IN STORAGE #105E), OCTASOUND RAMX2 AND RABX2 INPUTS, OCTASOUND RUSBX2 CHARGING PLATE, VANDAL CASES, VOLUME CONTROLS, ETC.,

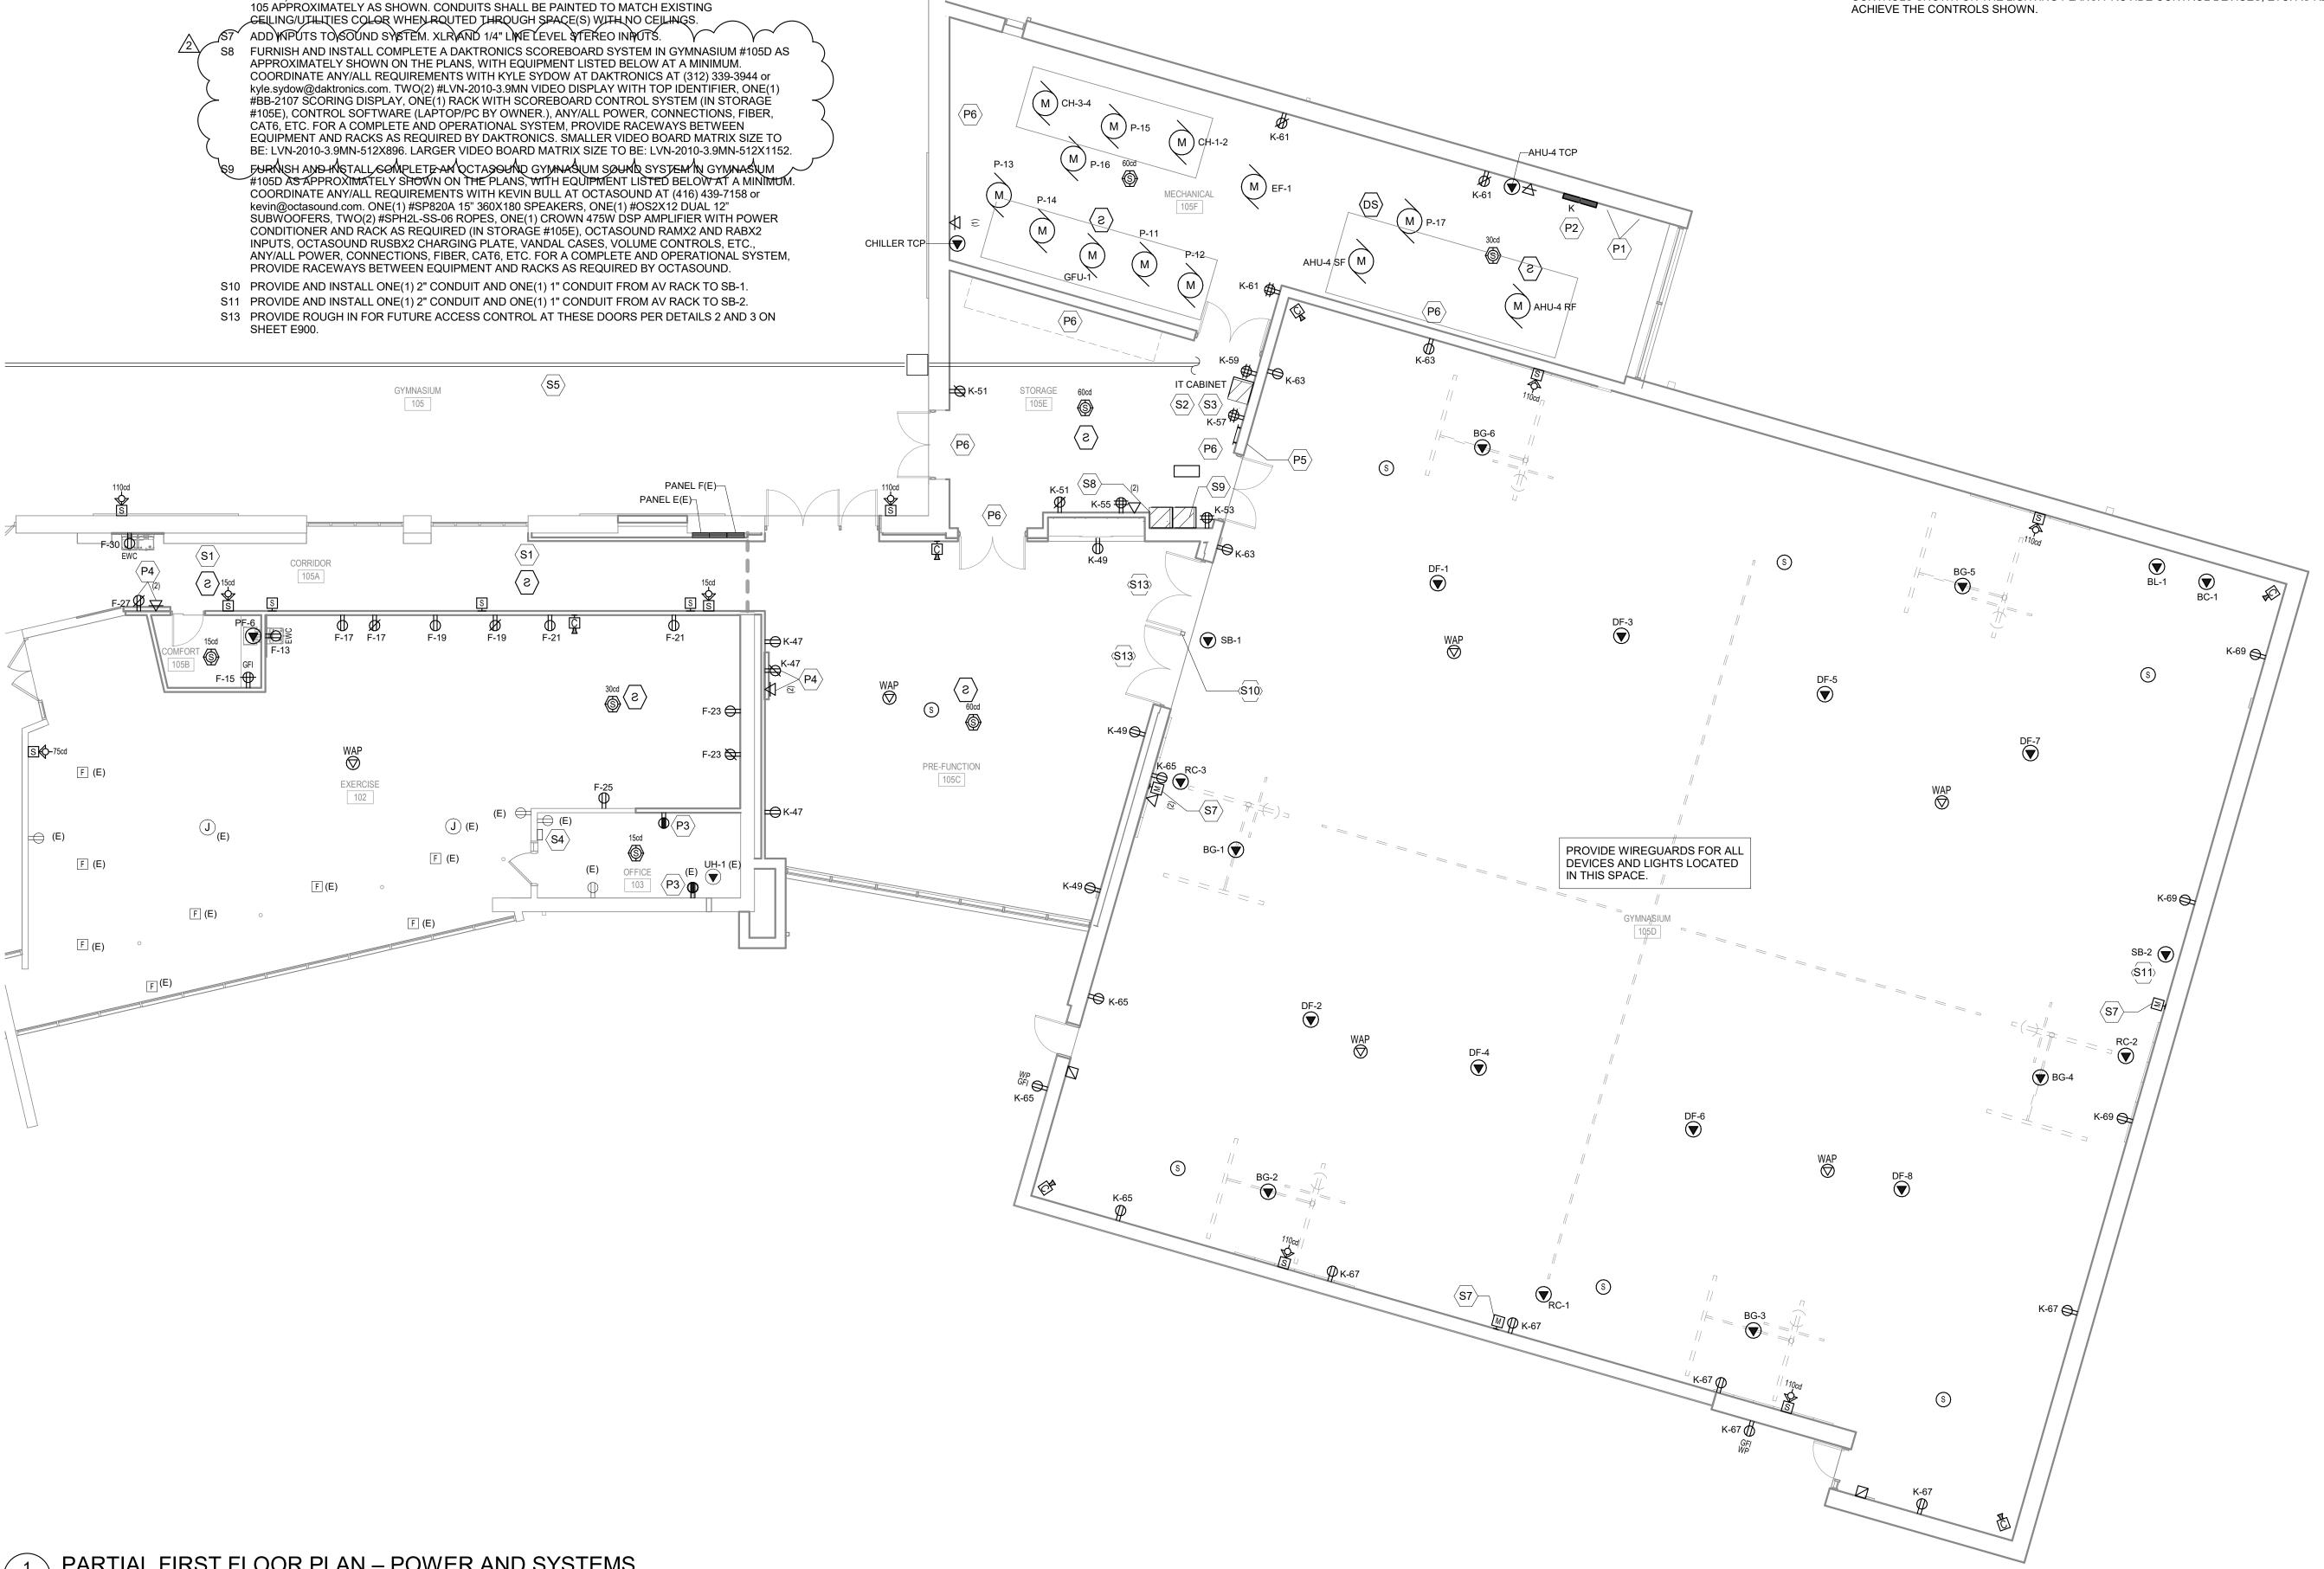

SYSTEMS GENERAL NOTES:

- ALL LOW VOLTAGE CABLES OR CONDUCTORS OPERATING AT LESS THAN 50 VOLTS SHALL BE IN ELECTRICAL METAL TUBING (EMT) WHERE INSTALLED WITHIN WALLS OR INACCESSIBLE SPACES.
- TV OUTLETS, VOLUME CONTROLS, TELEPHONE OUTLETS, AND DATA OUTLETS SHALL CONSIST OF A BACK BOX WITH CONDUIT STUBBED ABOVE THE ACCESSIBLE CEILING, SEE ROUGH-IN DETAIL. VERIFY SIZE OF BACK BOX REQUIRED WITH DEVICE TO BE INSTALLED. LOCATE BACK BOXES 6" FROM ADJACENT POWER RECEPTACLE INTENDED FOR COMPUTER USE.
- 3. ANY/ALL LOW VOLTAGE SYSTEMS, INCLUDING BUT NOT LIMITED TO THE FOLLOWING: COMMUNICATIONS, PAGING, CLOCK SYSTEM, CLASS BELLS, ETC., SHALL BE MAINTAINED THROUGHOUT CONSTRUCTION. FIELD VERIFY ALL LOW VOLTAGE SYSTEM REQUIREMENTS AND EXTEND/MAINTAIN/REUSE AS REQUIRED. EXTEND ANY/ALL NEW COMMUNICATIONS CABLING TO EXISTING MDF/IDF AS REQUIRED. COORDINATE JACK/CABLING REQUIREMENTS AND COLORS WITH OWNER.
- CAMERA MOUNTING SHALL BE COORDINATED WITH OWNER. VERIFY DESIRED MOUNTING HEIGHT AND 4 CAMERA MOUNT TYPE PRIOR TO INSTALL.
- ALL WAP LOCATIONS SHOWN ARE APPROXIMATE. CONFIRM ALL EXACT/FINAL WAP LOCATIONS WITH CITY 5. I.T. DEPARTMENT PRIOR TO ROUGH IN. WAP MOUNTING SHALL BE COORDINATED WITH OWNER. VERIFY DESIRED MOUNTING HEIGHT AND WAP MOUNT TYPE PRIOR TO INSTALL.
- 6. ALL NEW CAT6 CABLING SHALL BE ROUTED TO STORAGE (TR ROOM) #105E.

4.

NOTE THAT THIS PROJECT CONSISTS OF A COMPLETE REPLACEMENT OF THE FIRE ALARM SYSTEM AS SHOWN ON THE PLANS. ANY/ALL EXISTING FIRE ALARM DEVICES, CONTROL PANELS, ANNUNCIATOR PANELS, CABLING, ETC. SHALL BE DISCONNECTED AND REMOVED COMPLETE. REUSE OF EXISTING INFRASTRUCTURE (BOXES AND CONDUITS ONLY) IS ACCEPTABLE WHERE SIZED AND SUPPORTED PROPERLY. THE NEW VOICE FIRE ALARM SYSTEM THROUGHOUT THE BUILDING SHALL BE INSTALLED, PROGRAMMED, TESTED, COMMISSIONED, AND APPROVED BY THE LOCAL AHJ PRIOR TO DECOMMISSIONING AND REMOVING THE EXISTING FIRE ALARM SYSTEM. ANY/ALL NEW FIRE ALARM DEVICES SHALL BE RECESSED IN EXISTING WALLS/CEILINGS UNLESS INDICATED OTHERWISE ANY AND ALL FIRE ALARM CABLING SHALL BE EMT CONDUIT AT A MINIMUM. NO FREE AIR CABLING IS ALLOWED. ANY/ALL EXISTING BOXES AND CONDUITS WITHIN THE EXISTING BUILDING THAT ARE REMOVED SHALL HAVE THE EXISTING WALLS/CEILINGS PATCHED AND PAINTED TO OWNER'S SATISFACTION. ANY/ALL NEW BOXES AND CONDUITS WITHIN THE EXISTING BUILDING THAT ARE SURFACE MOUNTED ON EXISTING WALLS/CEILINGS SHALL BE PAINTED TO OWNER'S SATISFACTION.

POWER GENERAL NOTES:

1. REFER TO SHEET E000 FOR ALL SYMBOLS, ABBREVIATIONS, AND DETAILS.

THE CONTRACTOR MAY INSTALL UP TO THREE (3) CURRENT CARRYING CONDUCTORS IN A CONDUIT. LOADINGS ARE BASED ON THWN INSULATION, 40°C AMBIENT WITH DERATINGS FOR TEMPERATURE AND UP TO THREE (3) CONDUCTORS IN A CONDUIT. CONTACT THE ENGINEER FOR WIRING IN OTHER CONDITIONS.

3. VERIFY ALL MOUNTING HEIGHTS OF DEVICES ABOVE MILLWORK WITH ARCHITECTURAL PLANS.

5. ALL RECEPTACLES WITH PLUGLOAD CONTROL SHALL BE CONTROLLABLE VIA THE LIGHTING CONTROLS SHOWN ON THE LIGHTING PLANS. PROVIDE CONTROL DEVICES, ETC. AS REQUIRED TO



MILWAUKEE | MADISON | CHICAGO



ENGINEERING, INC 5525 NOBEL DRIVE SUITE 110 MADISON, WI 53711 PH: 608.277.1728 FAX: 608.271.7046 JDR PROJECT NO: 23.0319

WARNER PARK COMMUNITY RECREATION **CENTER EXPANSION**

1625 NORTHPORT DRIVE MADISON, WI 53704

CITY OF MADISON PARKS DIVISION 330 EAST LAKESIDE STREET MADISON, WI 53715

PROJECT NUMBER

223471.00

ISSUE	D FOR:	
BID S	ET	5/16/2024
REVIS	ION FOR:	
NO.	DESCRIPTION	DATE
1 2	Addendum #2 Addendum #3	6/7/2024 6/18/2024

DRAWN BY	JDR
CHECKED BY	JDR

PARTIAL FIRST FLOOR PLAN – POWER AND SYSTEMS



PROJECT NORTH