


S1

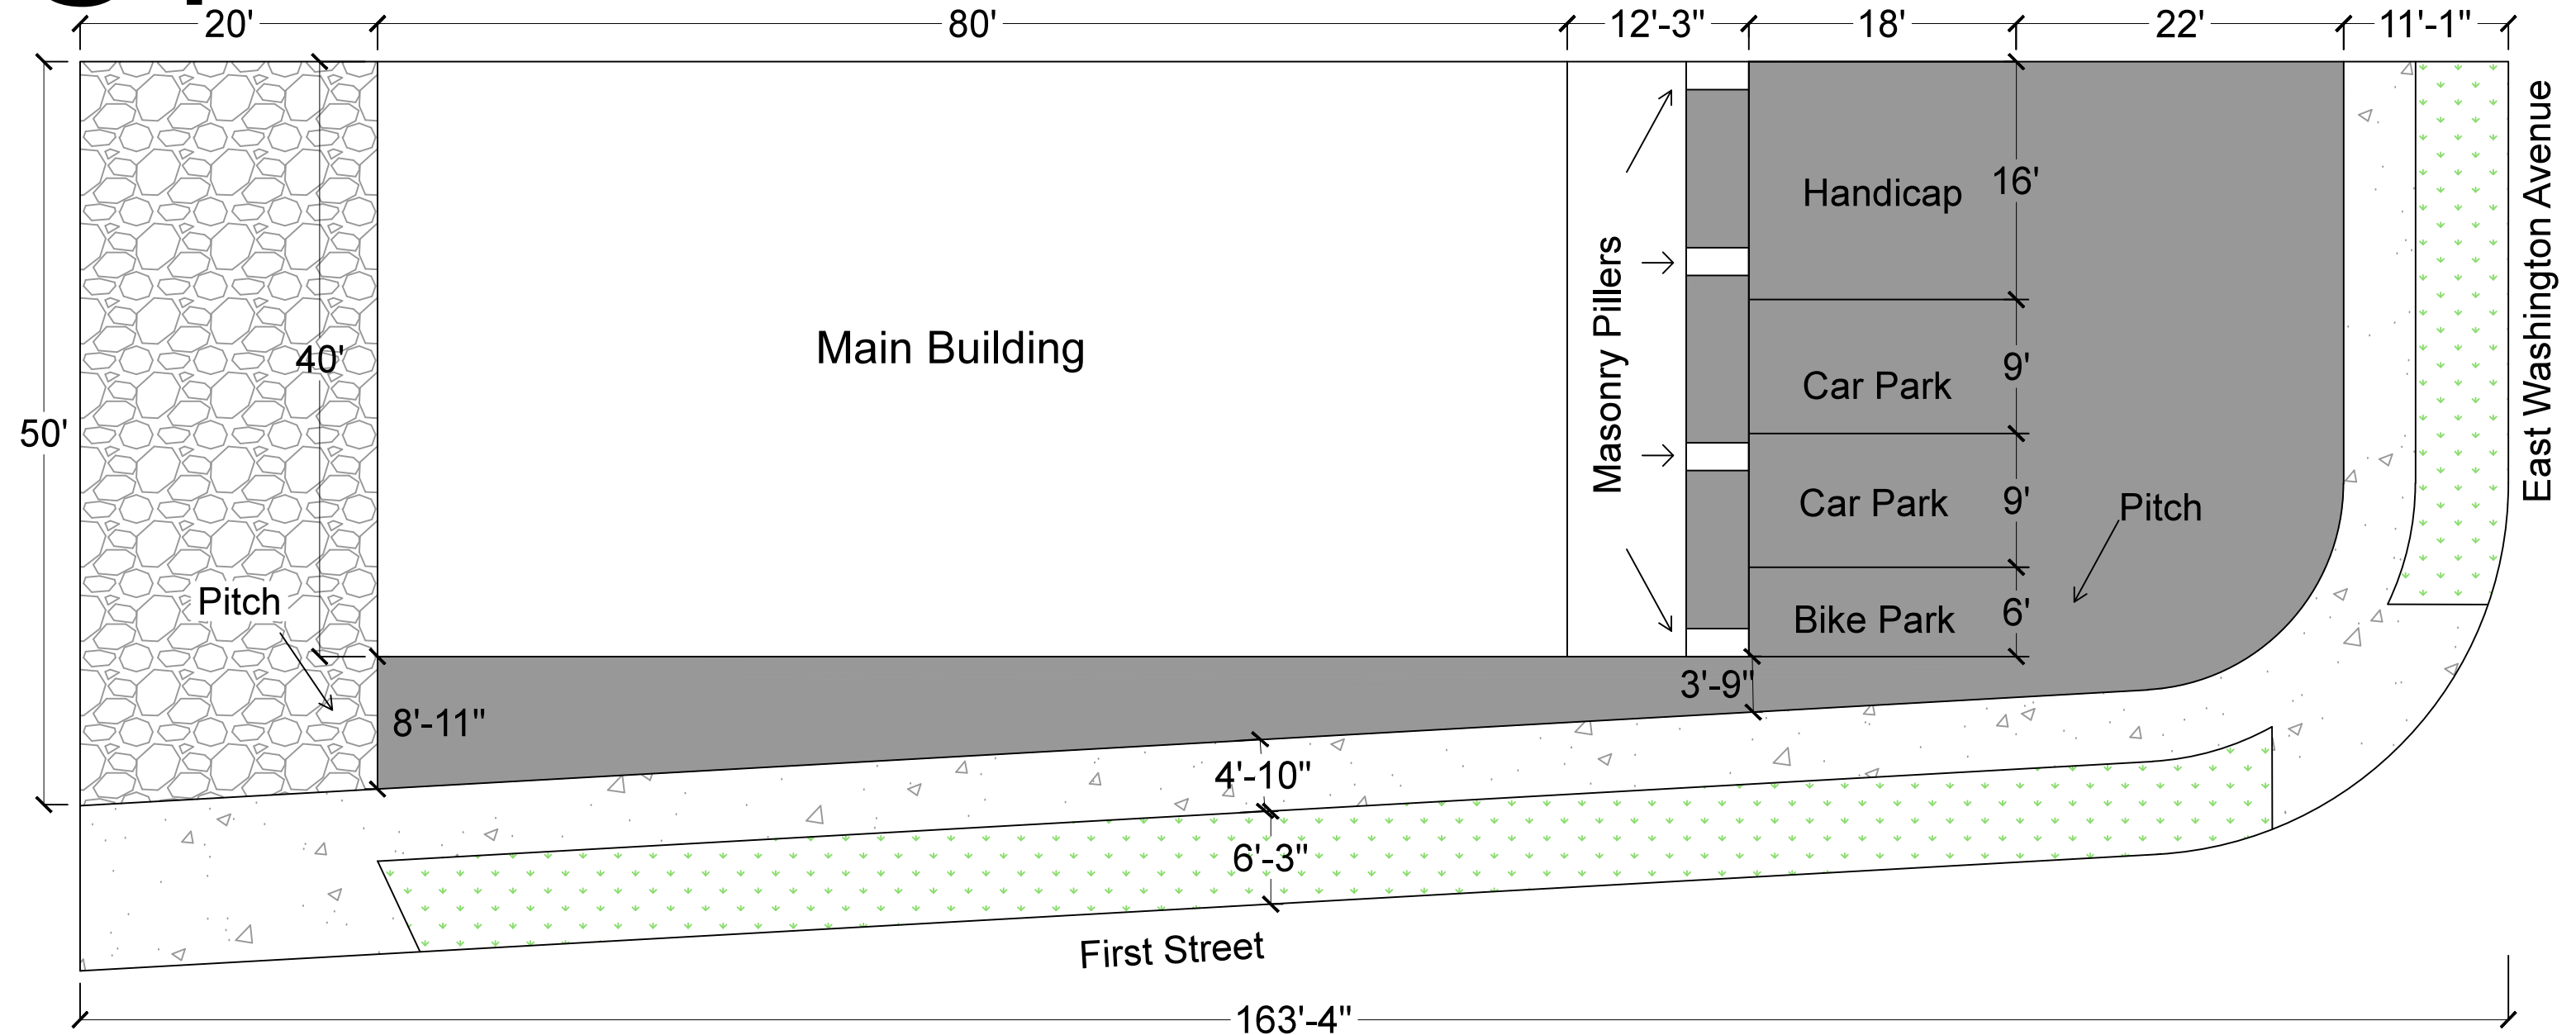

PRODUCED BY AN AUTODESK EDUCATIONAL PRODUCT


PRODUCED BY AN AUTODESK EDUCATIONAL PRODUCT

- Concrete
- Gravel
- Concrete Sidewalk
- Grass

Site Plan: 1900 + 1902 East Washington Avenue


Scale: 3/32"=1'

P1

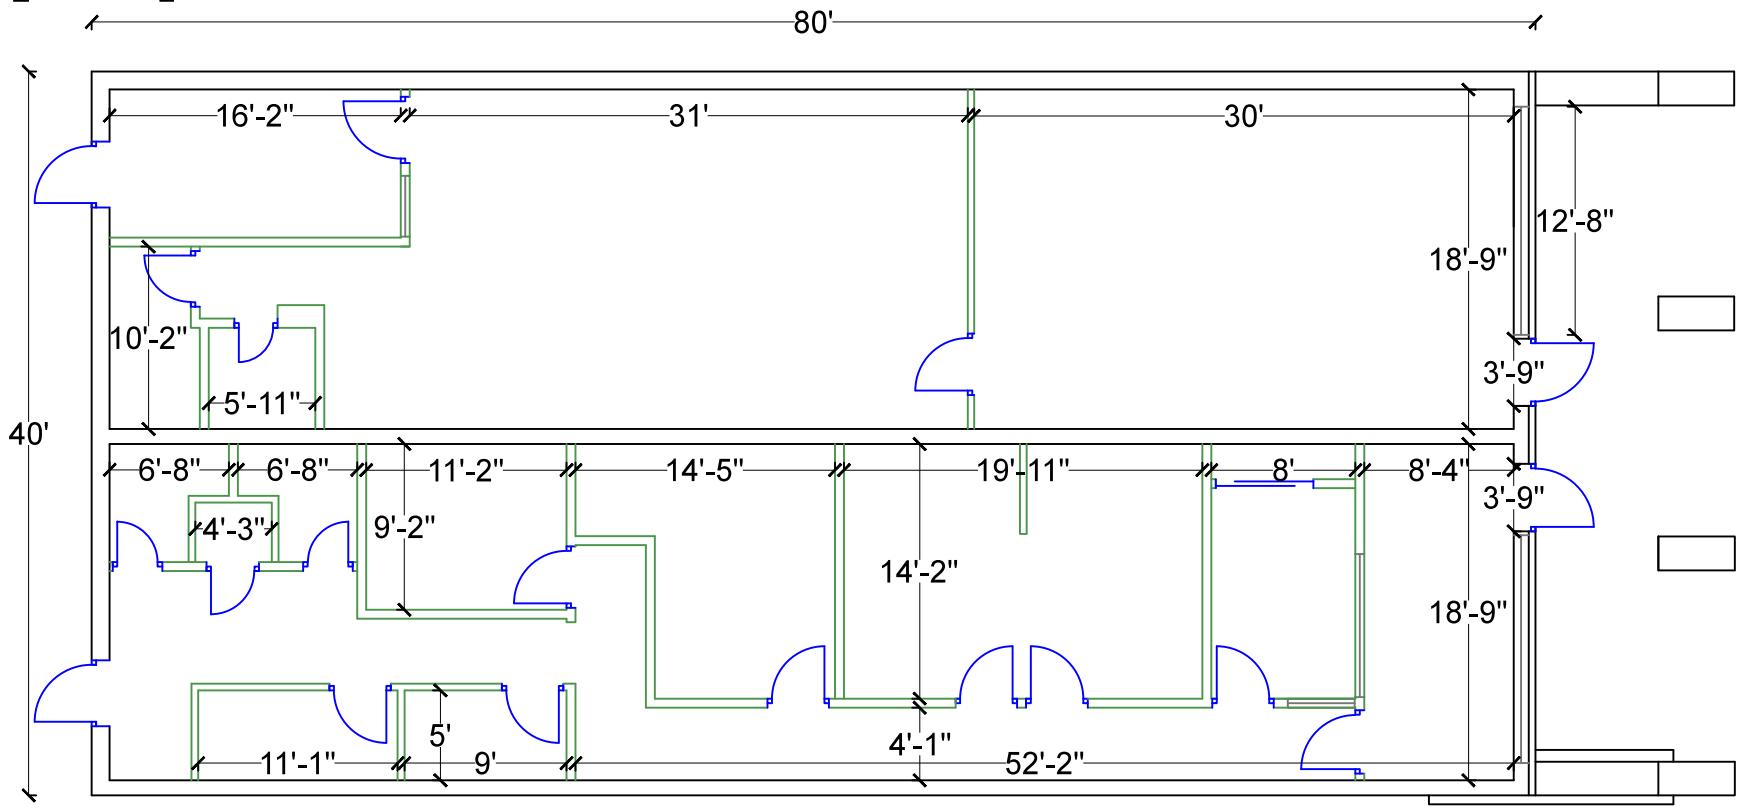

AS-BUILT FLOOR PLAN
 Address: 1900 + 1902 East Washington Avenue
 Madison, WI 53704
 Owner: Koua Vang
 Leaser: Supercharge! Foods
 Scale: $\frac{3}{32}''=1'$

P2

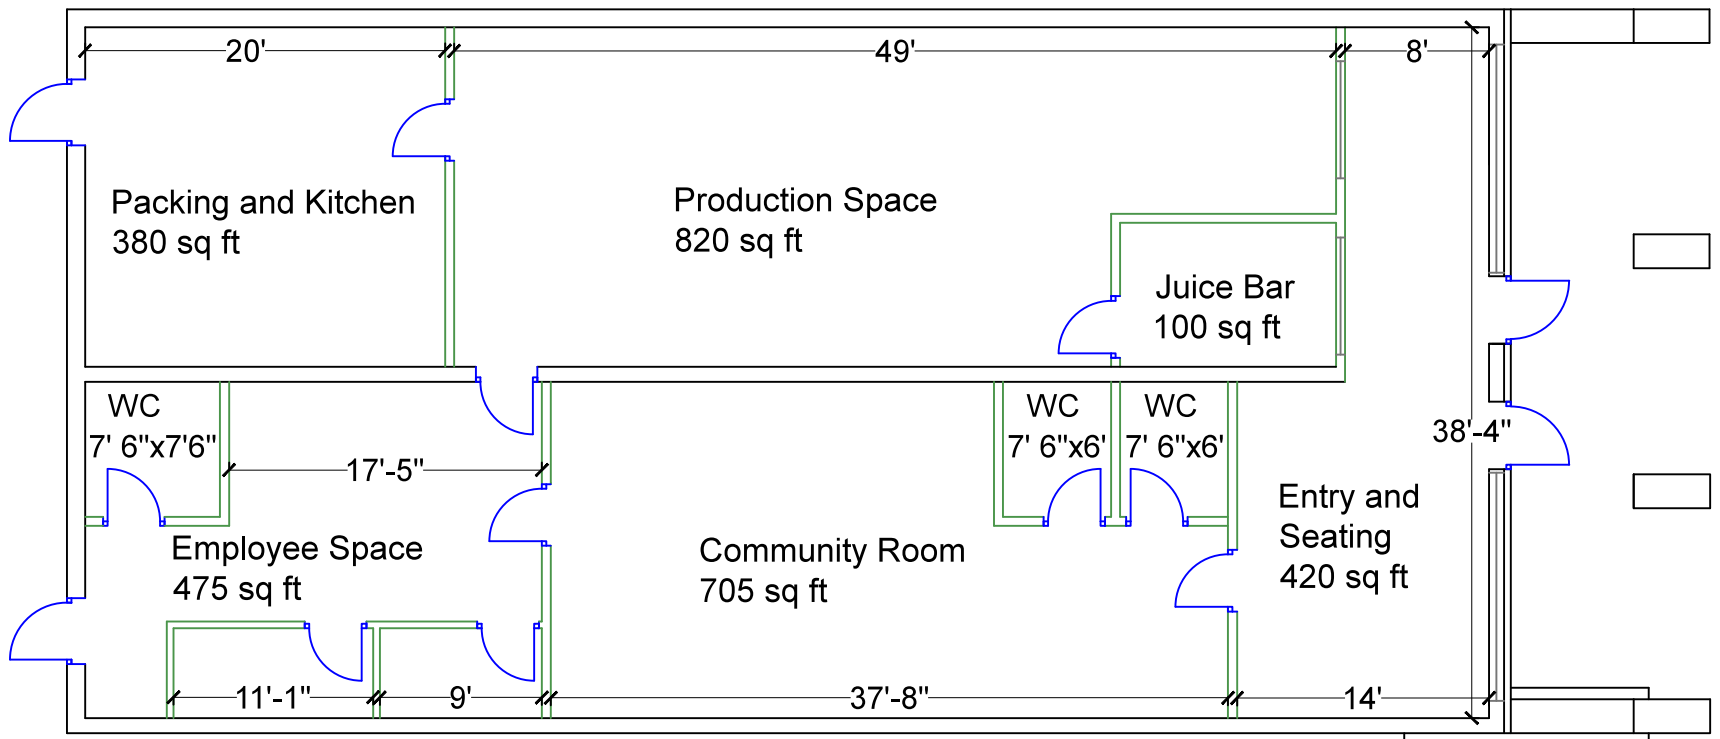





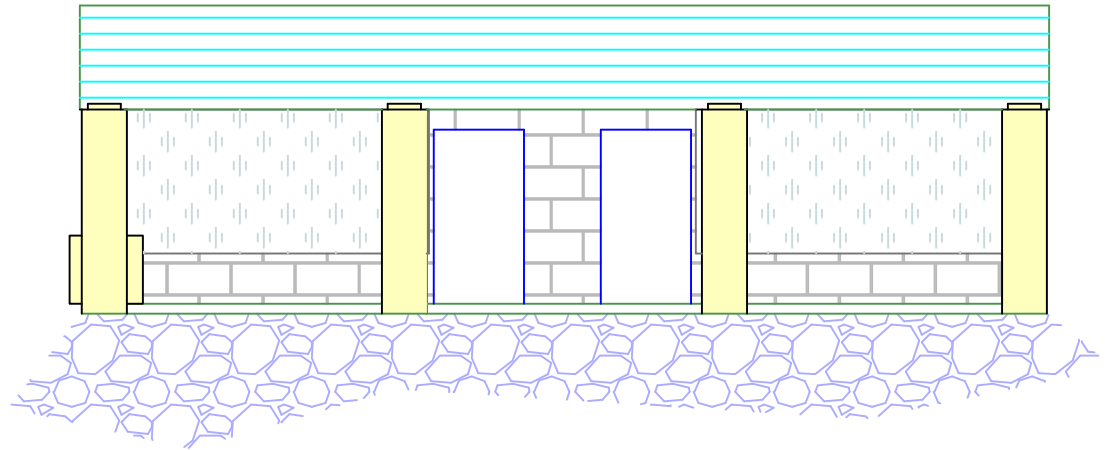
PROPOSED FLOOR PLAN
 Address: 1900 + 1902 East Washington Avenue
 Madison, WI 53704
 Owner: Koua Vang
 Leaser: Supercharge! Foods
 Scale: $\frac{3}{32}''=1'$

PRODUCED BY AN AUTODESK EDUCATIONAL PRODUCT

PRODUCED BY AN AUTODESK EDUCATIONAL PRODUCT


E1

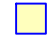-  Wood Siding
-  Concrete Block
-  Masonry Pillers
-  Window




Front Elevation
Scale: 1/8"=1'

E2

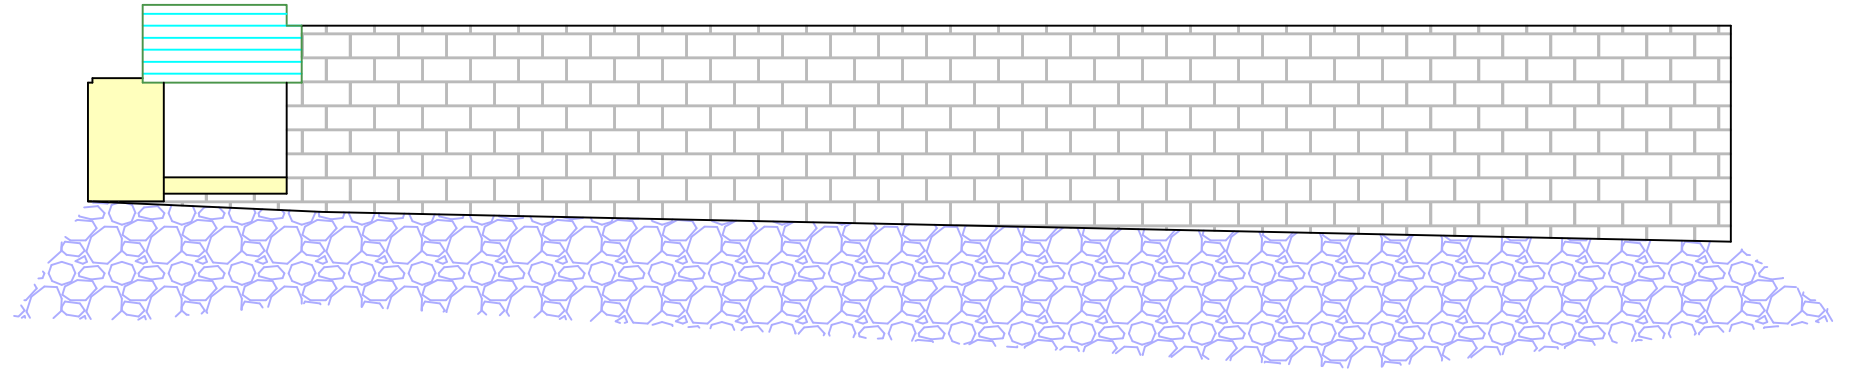


Side Elevation
Scale: 3/32"=1'

E3

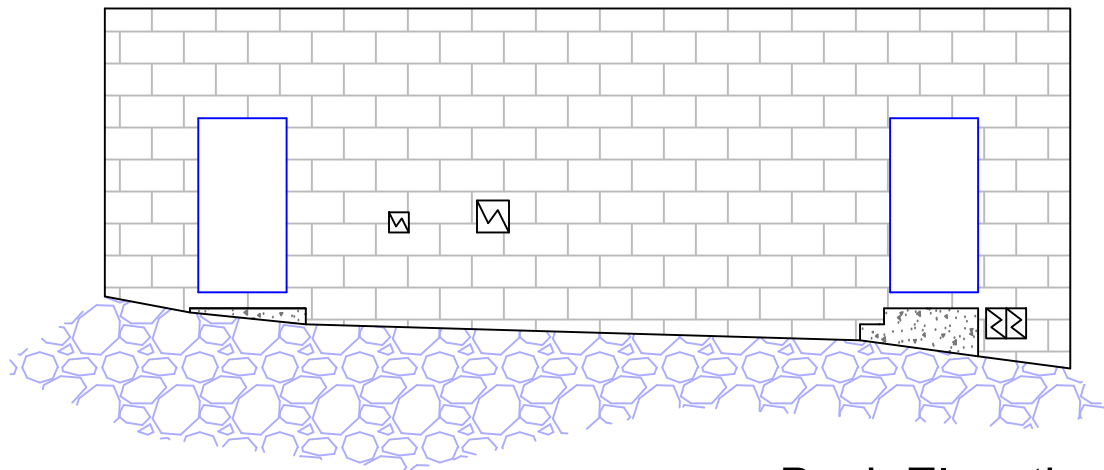

Back Elevation
Scale: 1/8"=1'

E4

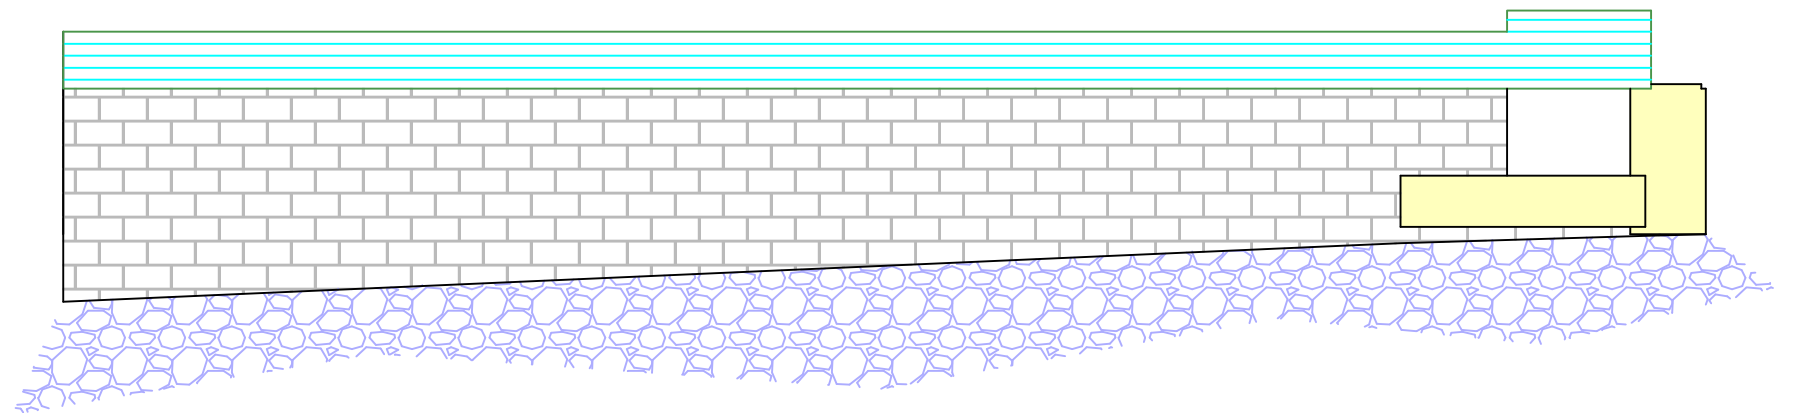

Street Side Elevation
Scale: 3/32"=1'